MAP FILE M 96-32

SUBDIVISION OF SECTION 26, T. 31 S., R. 6 W., W. M.

March 1984

Scale 1" = 400'

COUNTY SURVEYORS FILE DATA
DO NOT REMOVE FROM OFFICE

FILED BS
RECEIVED BS
APR 10 1984
COUNTY SURVEYOR
DOUGLAS COUNTY, ORE.

Surveyed For: Conifer Logging
P. O. Box 456
Roseburg, OR 97470

Surveyed By: Baughman Technical Services, Inc.
P. O. Box 222 or
5157 N. Umpqua Hwy.
Roseburg, OR 97470
(503) 673-0966

16"Laurel N52°E. 16.5ft.
11"Laurel S.20°E. 18.8ft. (Rec. 20.5ft.)
13"Laurel N.55°W. 32.7ft. (Rec. N60°W. 36.3ft.)
30" D.Fir S. ½°W. 24.1 ft. (Rec. S. 3°E. 24.5 ft.)
6"D.Fir S.53°W. 14.1ft.
12"D.Fir N.20°W. 14.9ft.

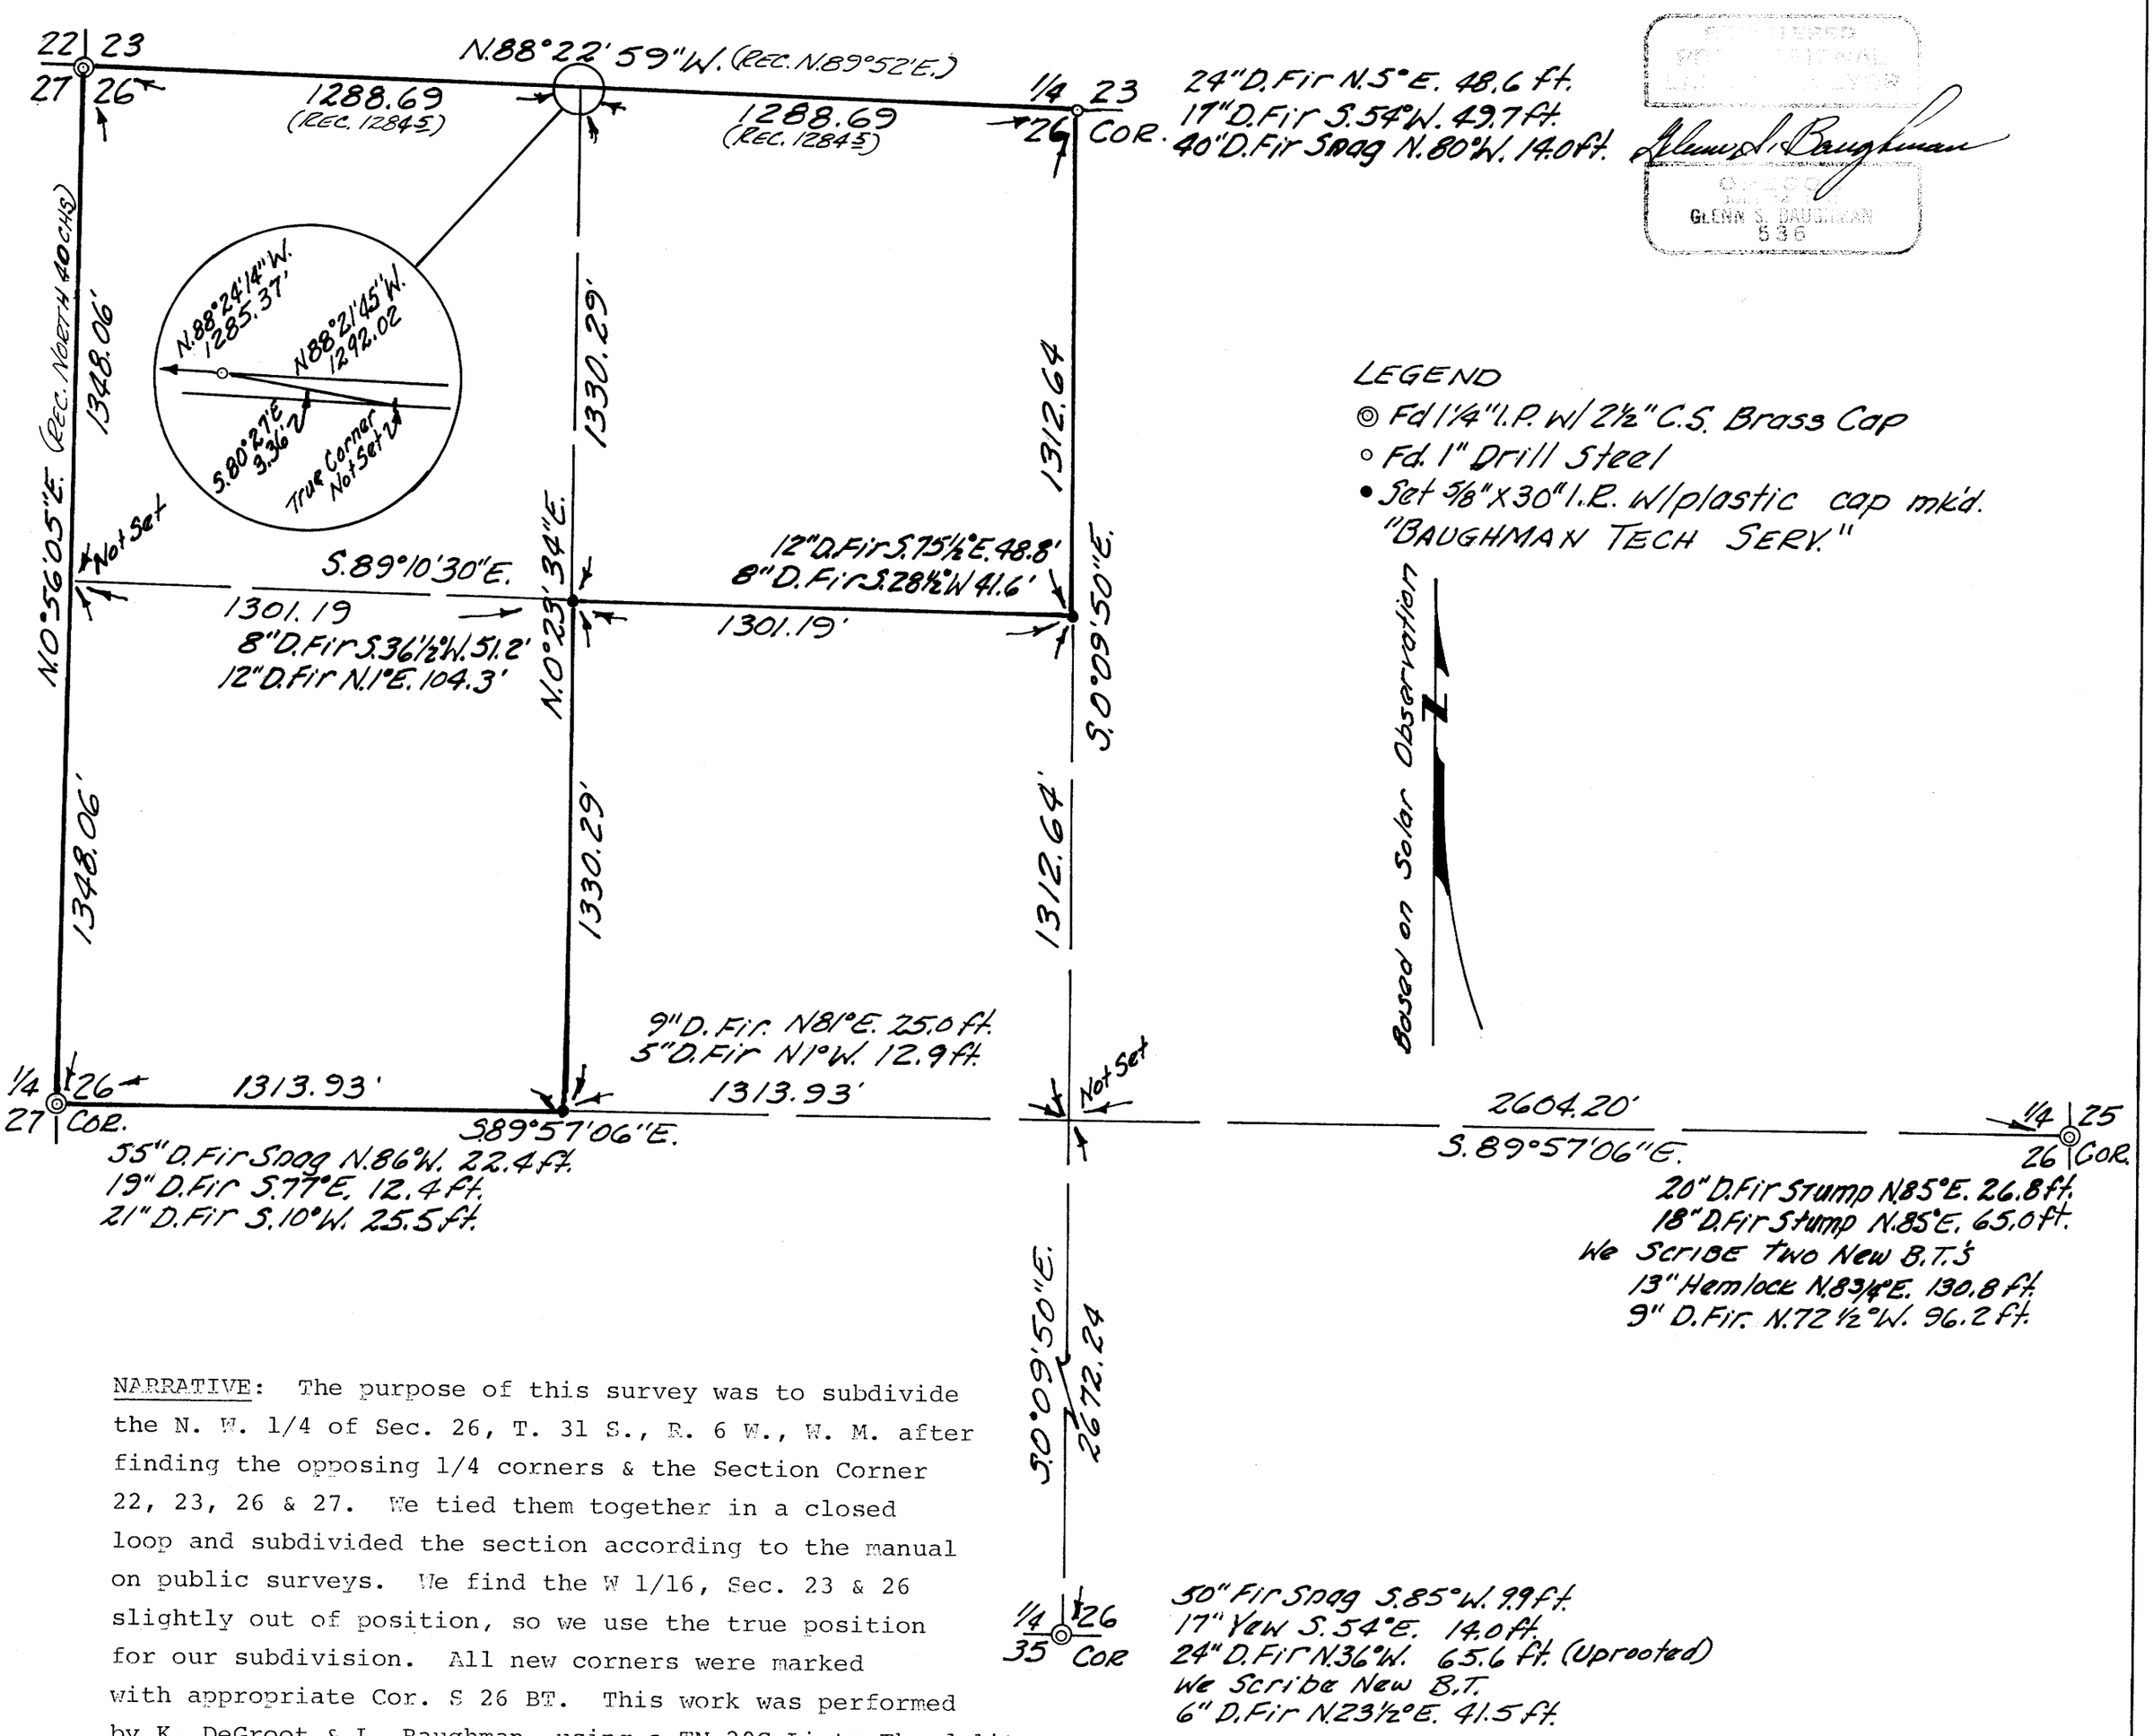

LEGEND
◎ Fd 1¼" I.P. w/ 2½" C.S. Brass Cap
○ Fd. 1" Drill Steel
• Set ⅝"x30" I.R. w/plastic cap mk'd. "BAUGHMAN TECH SERV."

Based on Solar Observation

NARRATIVE: The purpose of this survey was to subdivide the N. W. 1/4 of Sec. 26, T. 31 S., R. 6 W., W. M. after finding the opposing 1/4 corners & the Section Corner 22, 23, 26 & 27. We tied them together in a closed loop and subdivided the section according to the manual on public surveys. We find the W 1/16, Sec. 23 & 26 slightly out of position, so we use the true position for our subdivision. All new corners were marked with appropriate Cor. S 26 BT. This work was performed by K. DeGroot & L. Baughman, using a TM 20C Lietz Theodolite & Beetle 1000 E. D. M. Office calculations and drafting performed by G. Baughman.

MAP FILE M 96-32