COUNTY SURVEYORS FILE DATA
DO NOT REMOVE FROM OFFICE

SURVEY IN LOT 47, MARCH PLAT "A", NW 1/4, SEC. 8, T30S, R5W, W.M., DOUGLAS CO., OREGON, FOR SALE OF LAND FROM FRANK O. RUEBUSH TO BARNEY A. ROOT.

RS
RS
RS

SCALE: 1" = 100'
MARCH 30, 1984

SURVEY BY:

HAROLD V. STOCKHOFF, L.S. 1663
1074 N.E. KNOLL
ROSEBURG, OR 97470

NARRATIVE:

THIS SURVEY WAS ACCOMPLISHED BY USING THE FOUND MONUMENTS AS SHOWN ON THIS MAP OF SURVEY. THE EQUIPMENT USED WAS A LIETZ 20 SEC. THEODOLITE AND 300 FOOT STEEL CHAIN.
PARTY CHIEF - HAROLD V. STOCKHOFF, L.S. 1663. HEADCHAINMAN - JIM BRYAN. COMPUTATIONS BY HAROLD V. STOCKHOFF, L.S. 1663. DRAFTING BY KELLI CALDERWOOD.

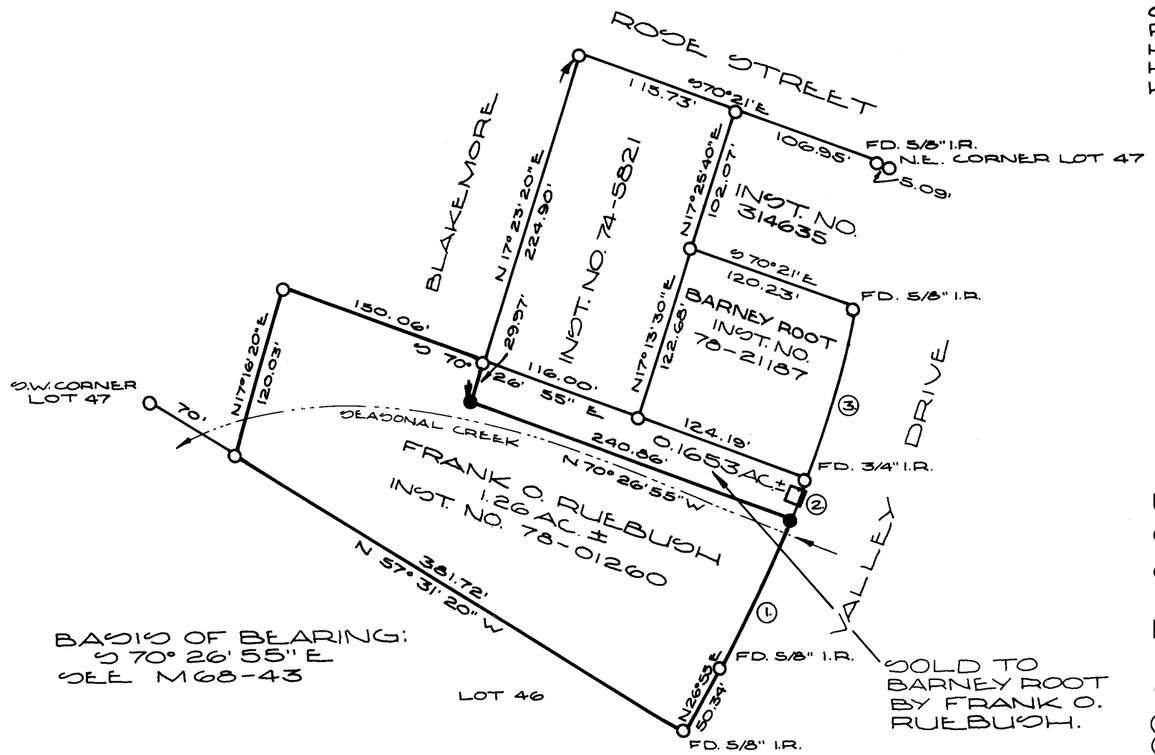

REGISTERED
PROFESSIONAL
LAND SURVEYOR
Harold V. Stockhoff
OREGON
JULY 14, 1978
HAROLD V. STOCKHOFF
1663

LEGEND:

- O – FOUND 3/4" IRON PIPE OR AS NOTED.
- ● – SET 3/4" X 30" IRON PIPE WITH BRASS WASHER STAMPED L.S. 1663.
- □ – TRI-CITY WATER DISTRICT PER INST. NO. 263573.

CURVE DATA:

	Δ	R	L	L.C.	
1	6°06'27"	1180.43'	125.83'	S23°34'09"W	– 125.77'
2	1°27'22"	1180.43'	30.00'	S16°06'13"W	– 30.00'
3	5°57'30"	1180.43'	122.76'	N15°22'32"E	– 122.70'

M96 - 49
M96 - 49