COUNTY SURVEYORS FILE DATA
DO NOT REMOVE FROM OFFICE

FILED BS
RECORDED 1/8
COUNTY SURVEYOR
DOUGLAS COUNTY, OREGON
BS

M 96-71

SURVEY IN THE N.W. 1/4 OF SECTION 9, T28S, R6W, W.M.

SURVEY FOR: LAUREN YOUNG
2460 N.E. STEPHENS
ROSEBURG, OREGON
PH. 672-6616

SURVEY BY: ROMEY WARE
2771 N.W GARDEN VALLEY RD.
ROSEBURG, OREGON
PH. 672-0649

DATE: MAY, 1984
SCALE: 1" = 200'

NARRATIVE:

Survey for the purpose of preparing a description and monumenting subject parcel for its qualification to the Douglas County Reforestation Program.
For Reference Surveys See M 37-56 & M 33-60.
Field Crew: Mike Riggan & Mike Saylor.
Equipment: Wild T-16 Theodolite mounted w/ a Nikkon ND160 E.D.M.
Computations & Drafting: Romey Ware.

○ — SET 5/8" I. ROD (30" IN LENGTH) W/ CAP STAMPED "R.E. WARE L.S. 1005".
◉ — FD. MONUMENT AS SHOWN.

REGISTERED PROFESSIONAL LAND SURVEYOR
Romanso E. Ware
OREGON NOV. 16, 1973 ROMANSO E. WARE 1005

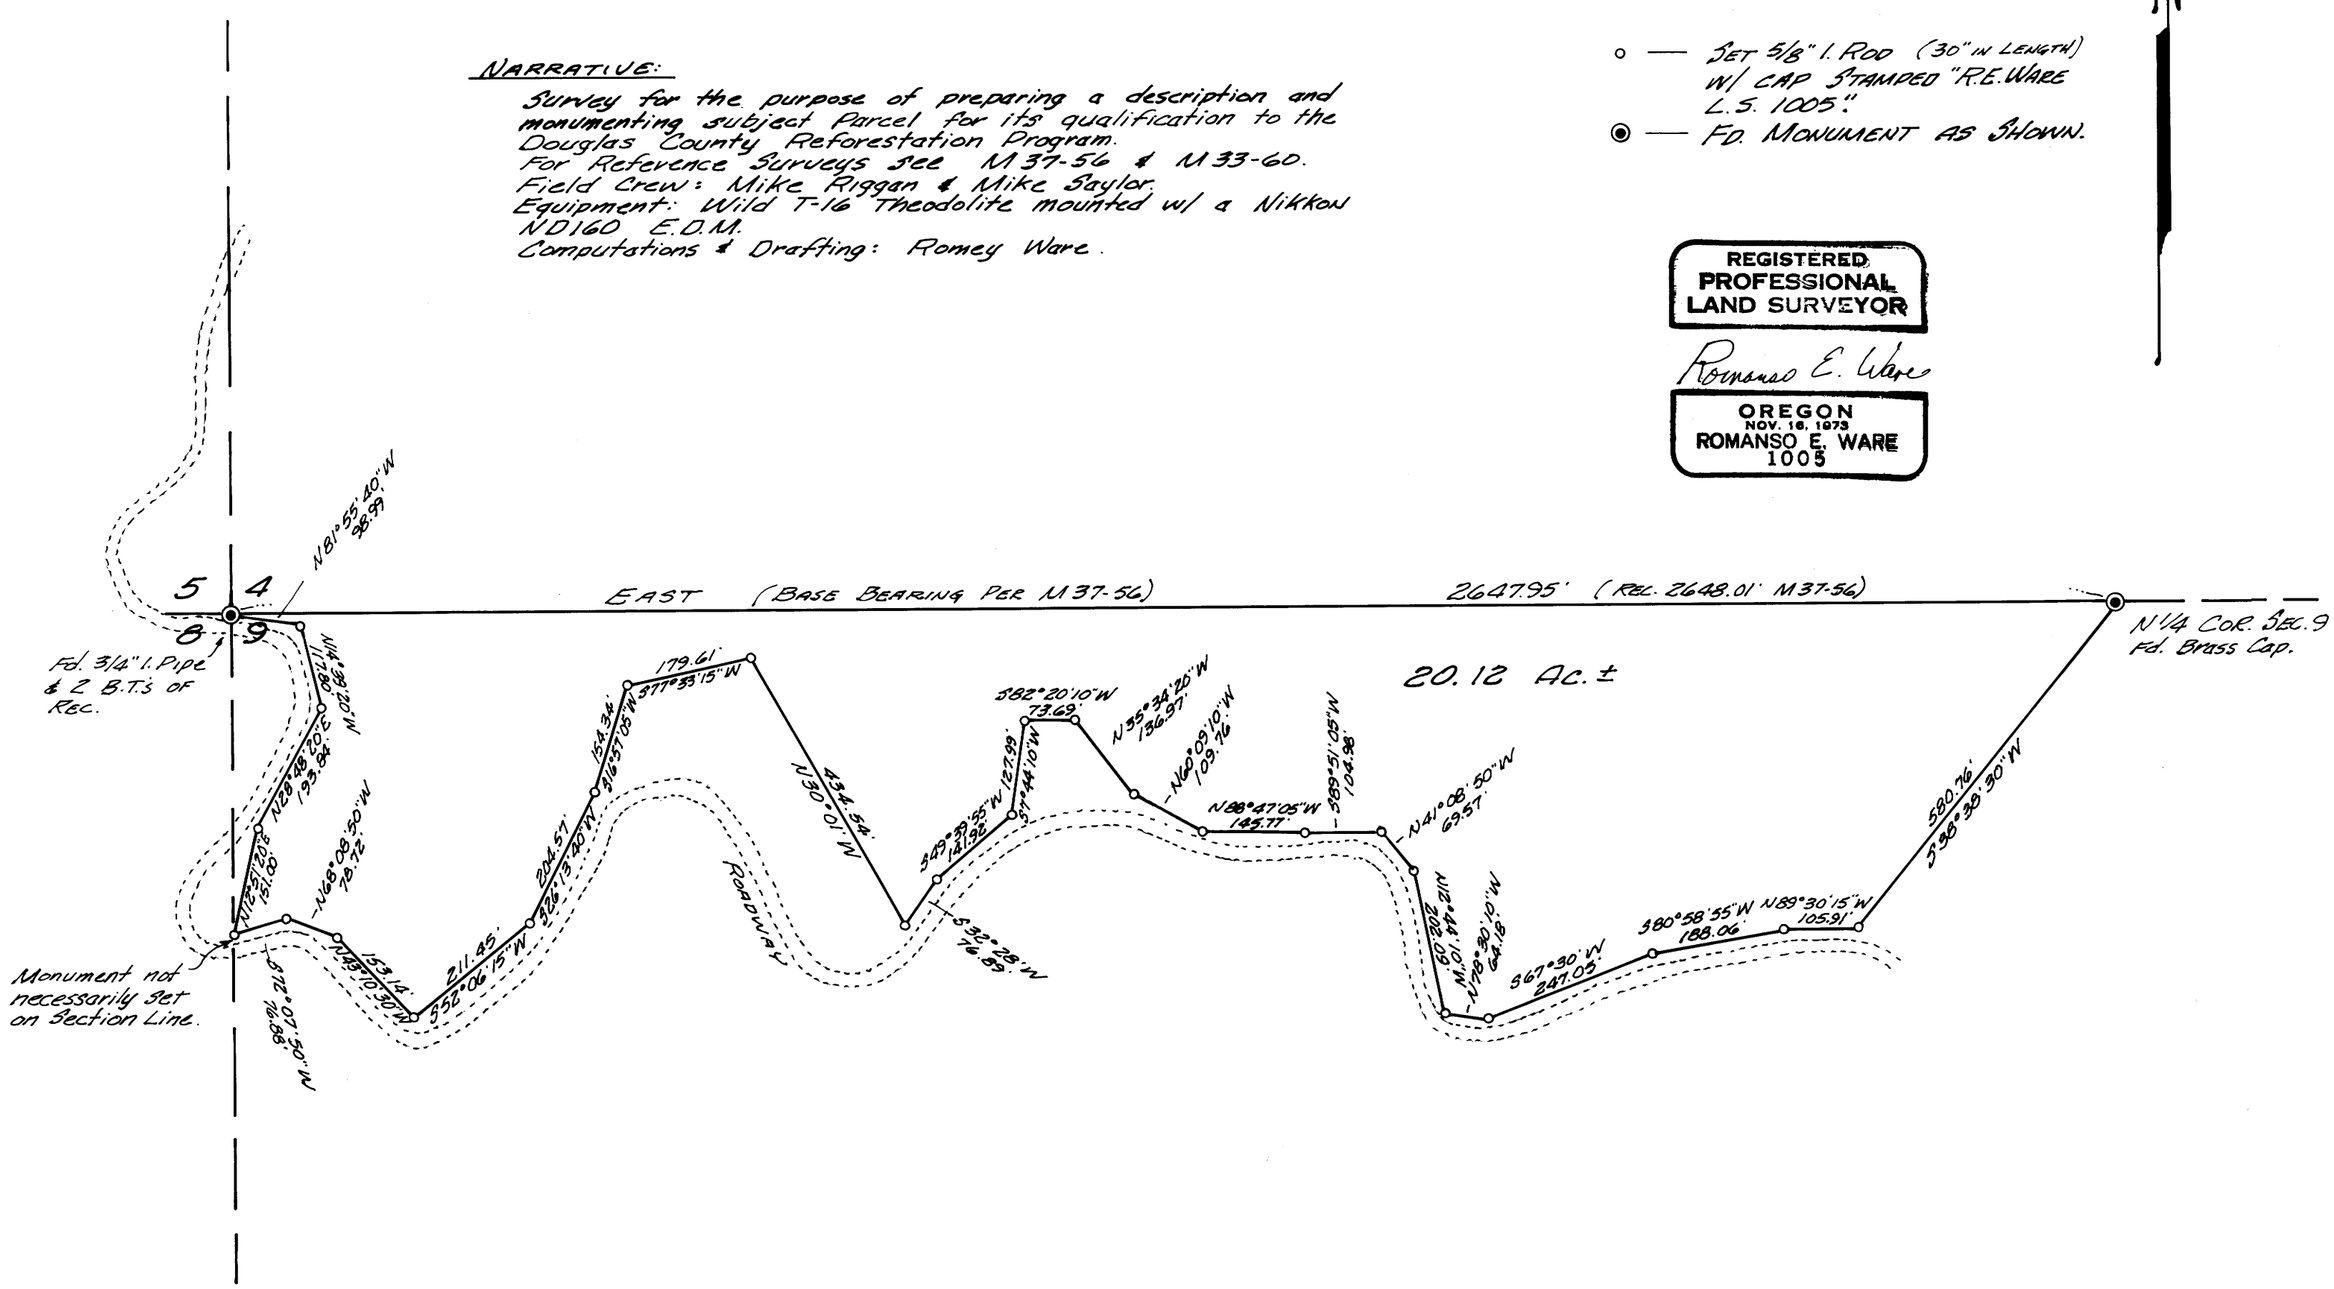

M 96-71