COUNTY SURVEYORS FILE DATA
DO NOT REMOVE FROM OFFICE

Resurvey and Subdivision of Section 30, T 30 S, R 7 W, W. M., Oregon

For Roseburg Lumber Company

July 26, 1984

FILED
RECEIVED
AUG 29 1984
COUNTY SURVEYOR
DOUGLAS COUNTY, ORE.

MAP FILE M-27-28

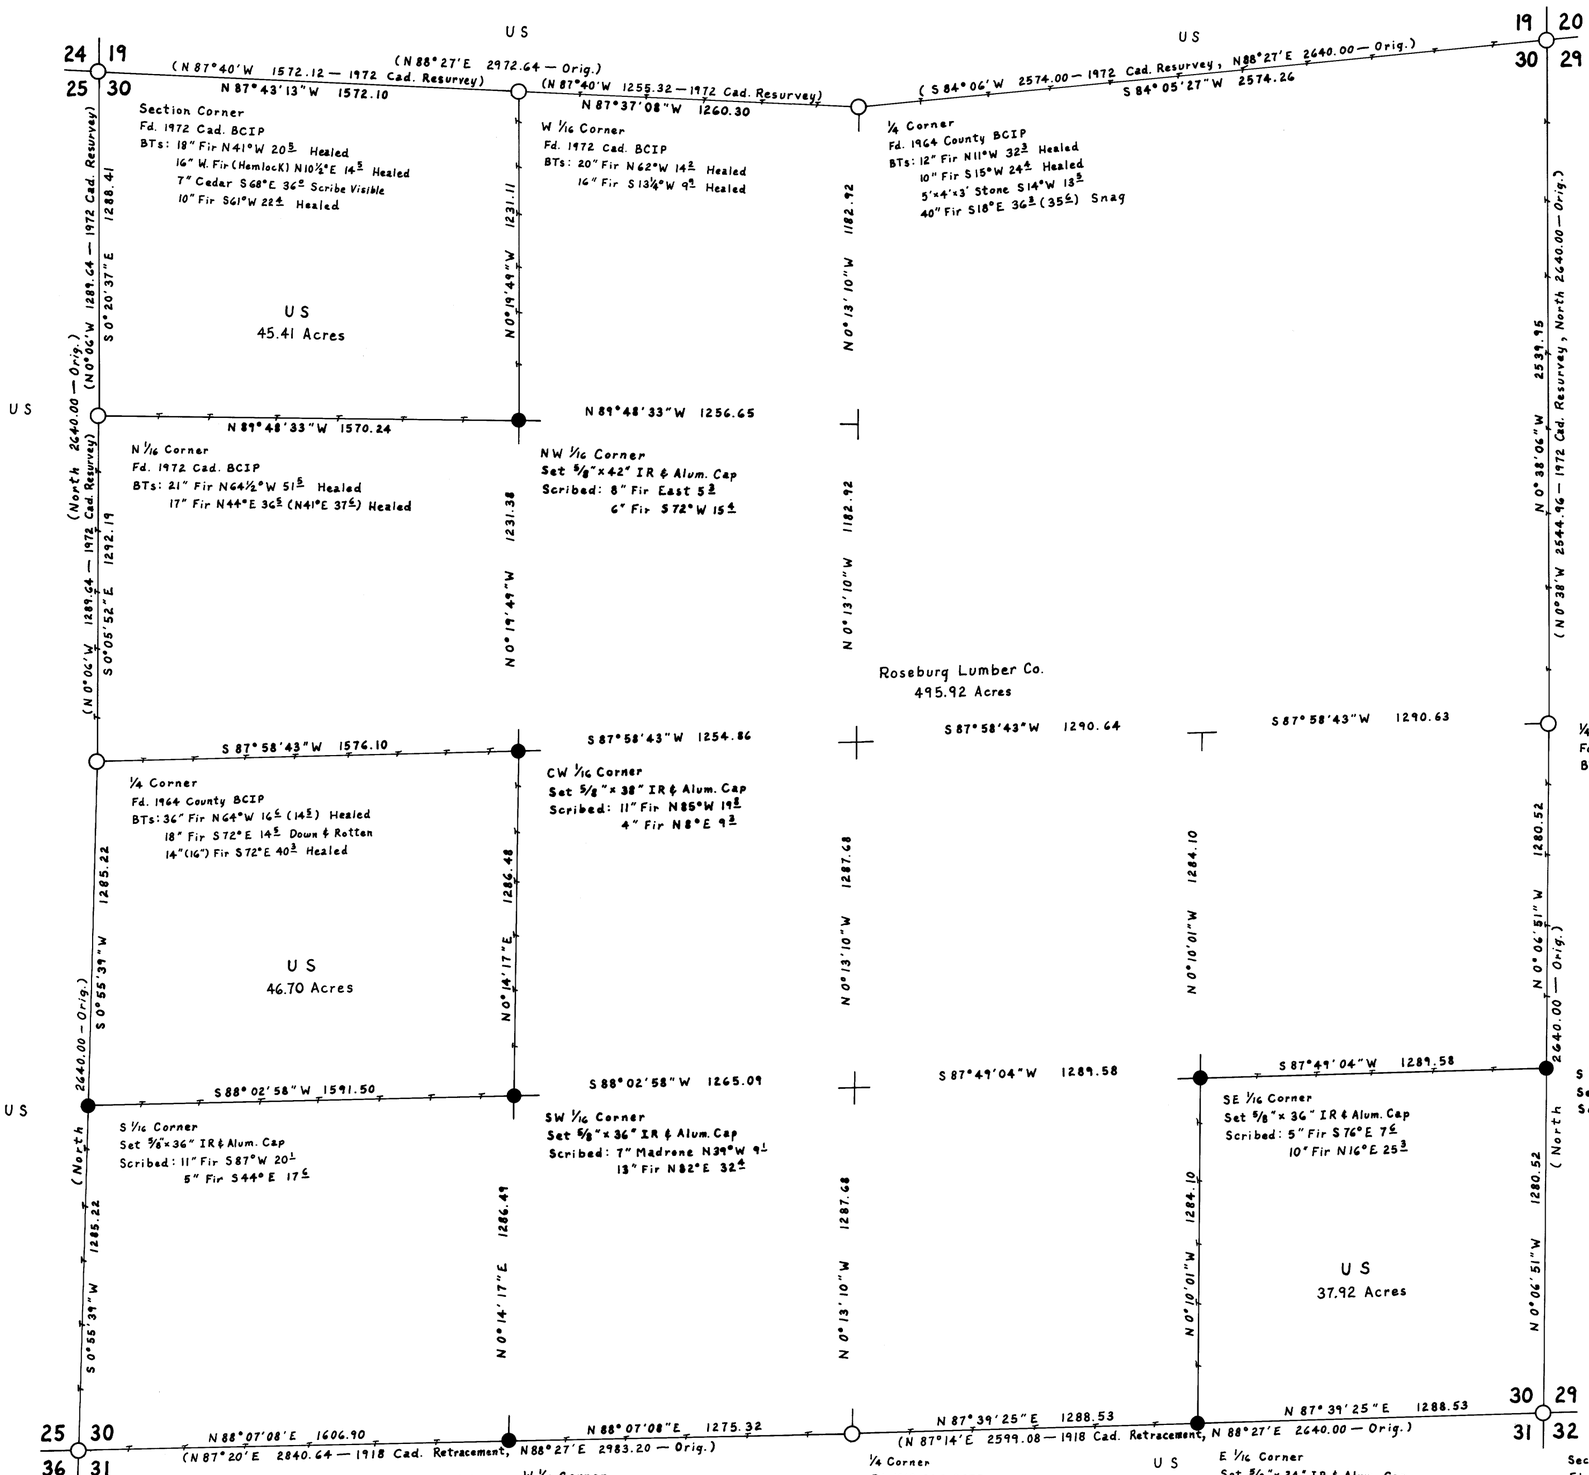

Legend

- ○ Monument Found as Noted
- ● Set 5/8" IR & Alum. Cap Marked LS 498
- —— Section or Property Line
- —+—+— Line Referenced to Alum. Tags
- ( ) Record Data

Scale: 1" = 400'

N

Bearing Based on Solar Observation

I ran a closed traverse in Section 30 using a Jena 1 second theodolite and a Mac 1-E EDM. I achieved a precision of 1:30,945 and adjusted the traverse by the Crandall method. I set the corners by standard subdivision procedure based on the location of the existing monuments. Proportions of the west half are based on Byars 1882 survey.

Howard W. Johnstone
P.O. Box 1088
Roseburg, Oregon

REGISTERED
PROFESSIONAL
LAND SURVEYOR
Howard W. Johnstone
OREGON
MAY 13, 1960
HOWARD W. JOHNSTONE
498

MAP FILE M-27-28