COUNTY SURVEYORS FILE DATA
DO NOT REMOVE FROM OFFICE

SURVEY TO LOCATE THE NORTHWESTERLY RIGHT-OF-WAY LINE OF HUNTLEY STREET, JONES ADDITION TO ROSEBURG, IN THE SW1/4 OF THE NW1/4 OF SECTION 18, T27S, R5W, W.M., DOUGLAS COUNTY, OREGON.

FILED
RECEIVED
SEP 10 1984
COUNTY SURVEYOR
DOUGLAS COUNTY, ORE.

MAP FILE M97-34

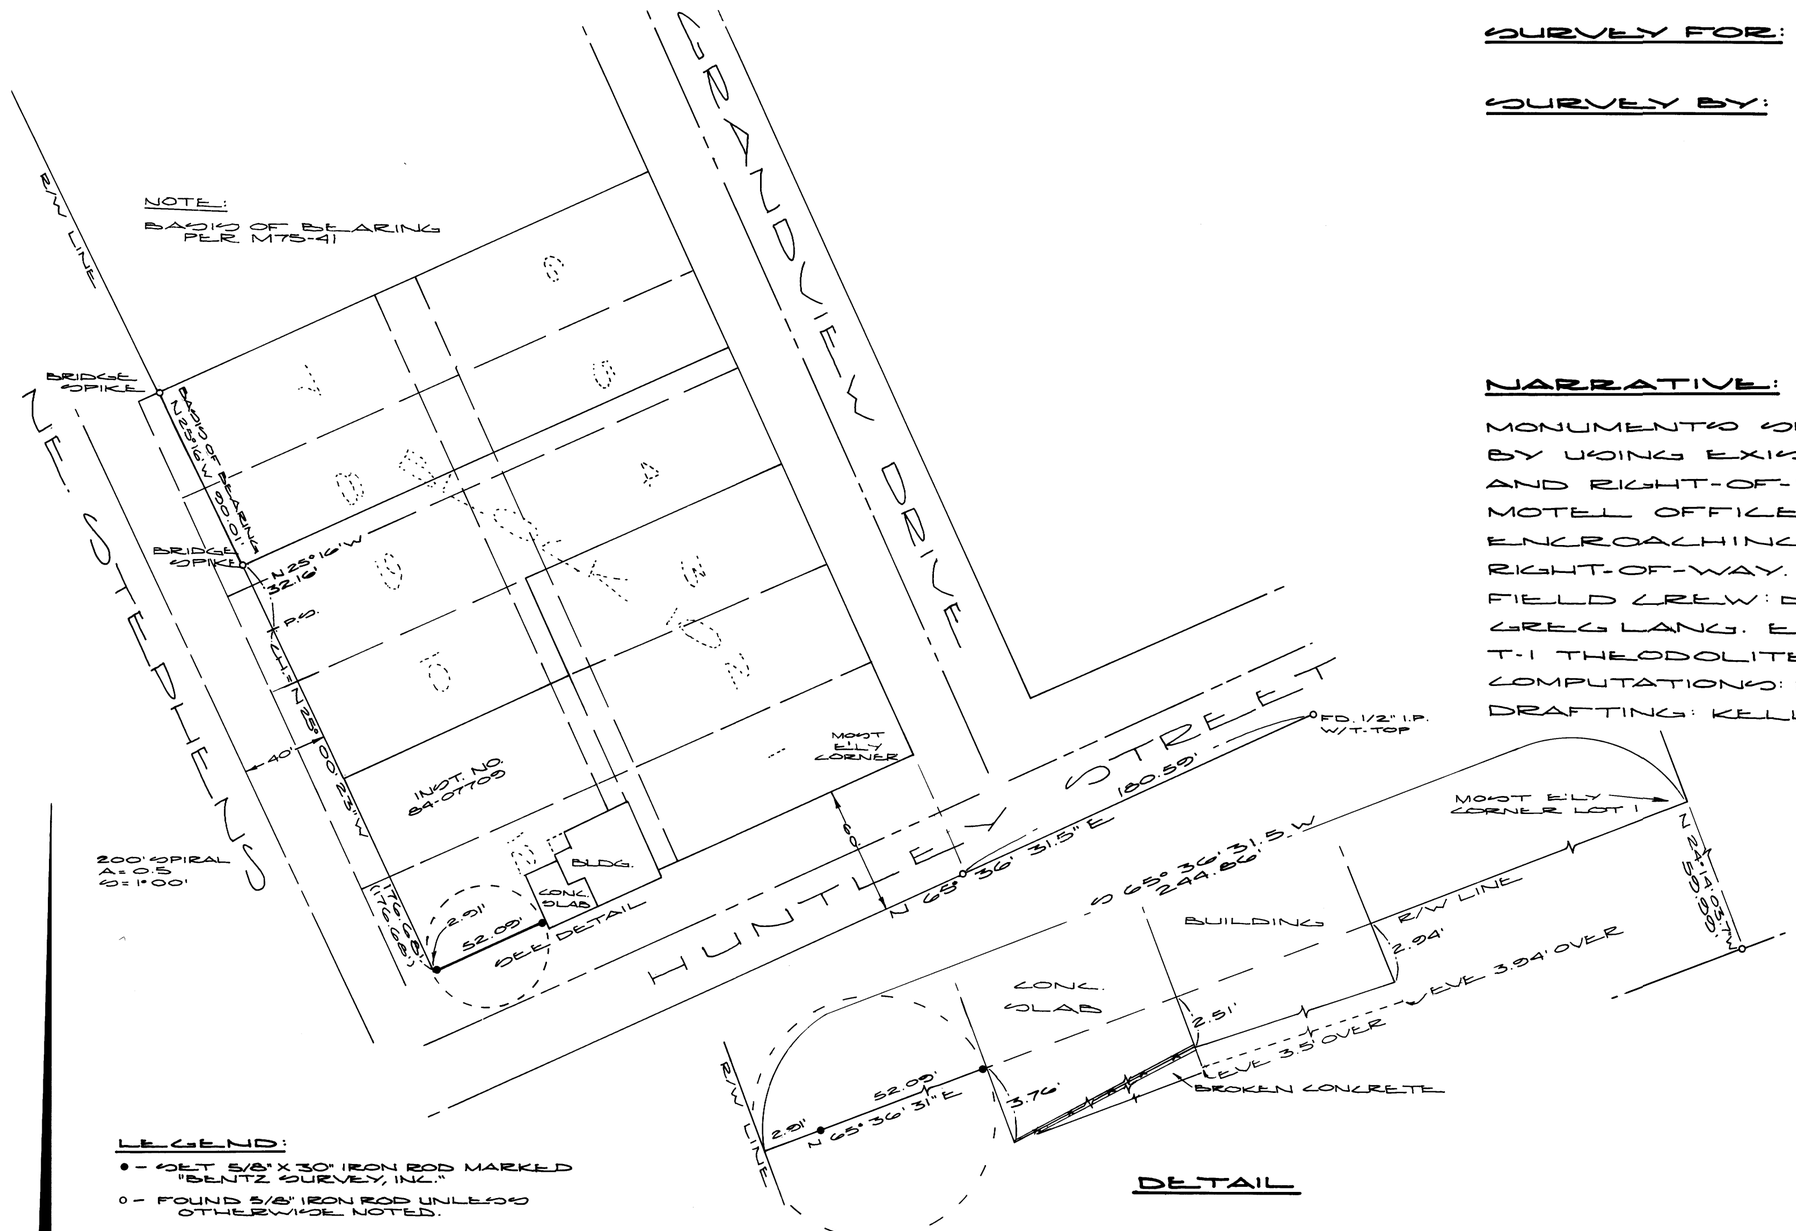

SURVEY FOR: RICK KITTSON

SURVEY BY: DONALD A. BENTZ, INC.
POST OFFICE BOX 901
WINCHESTER, OR 97495
(503) 673-0166

NARRATIVE:

MONUMENTS SET WERE ESTABLISHED BY USING EXISTING MONUMENTS AND RIGHT-OF-WAY WIDTHS.
MOTEL OFFICE WAS FOUND TO BE ENCROACHING ON HUNTLEY STREET RIGHT-OF-WAY.
FIELD CREW: DAVE DELATTE AND GREG LANG. EQUIPMENT USED: WILD T-1 THEODOLITE, RED-1 DISTANCEMETER.
COMPUTATIONS: DONALD A. BENTZ.
DRAFTING: KELLI CALDERWOOD.

REGISTERED PROFESSIONAL LAND SURVEYOR
OREGON
DONALD A. BENTZ
3339

LEGEND:

● - SET 5/8" X 30" IRON ROD MARKED "BENTZ SURVEY, INC."

○ - FOUND 5/8" IRON ROD UNLESS OTHERWISE NOTED.

SCALE: 1" = 50'

SEPTEMBER 1984

MAP FILE M97-34