SURVEY FOR DESCRIPTION

LOCATED IN LOT 12 BLOCK 13 PLAT A RHOT
NW 1/4 S29 T26S R6W WM
FOR GAYLE MOFFITT
OCTOBER 1984 SCALE 1"=50'

COUNTY SURVEYORS FILE DATA
DO NOT REMOVE FROM OFFICE

7

BS

BS

M 97-45

NARRATIVE

PURPOSE

SURVEY FOR DESCRIPTION

PROCEDURE

USING DATA OF RECORD PER M42-16, M58-64 DOUGLAS COUNTY SURVEYORS OFFICE MAP FILE AND FOUND MONUMENTS I ESTABLISHED A POINT ON THE EASTERLY R/W LINE OF COUNTY ROAD NO. 6, WHICH IS AN EXTENSION OF THE LINE BETWEEN THE NORTHERLY FOUND 1/2" IRON RODS PER M58-64.

EQUIPMENT

TOPCON GTS-2

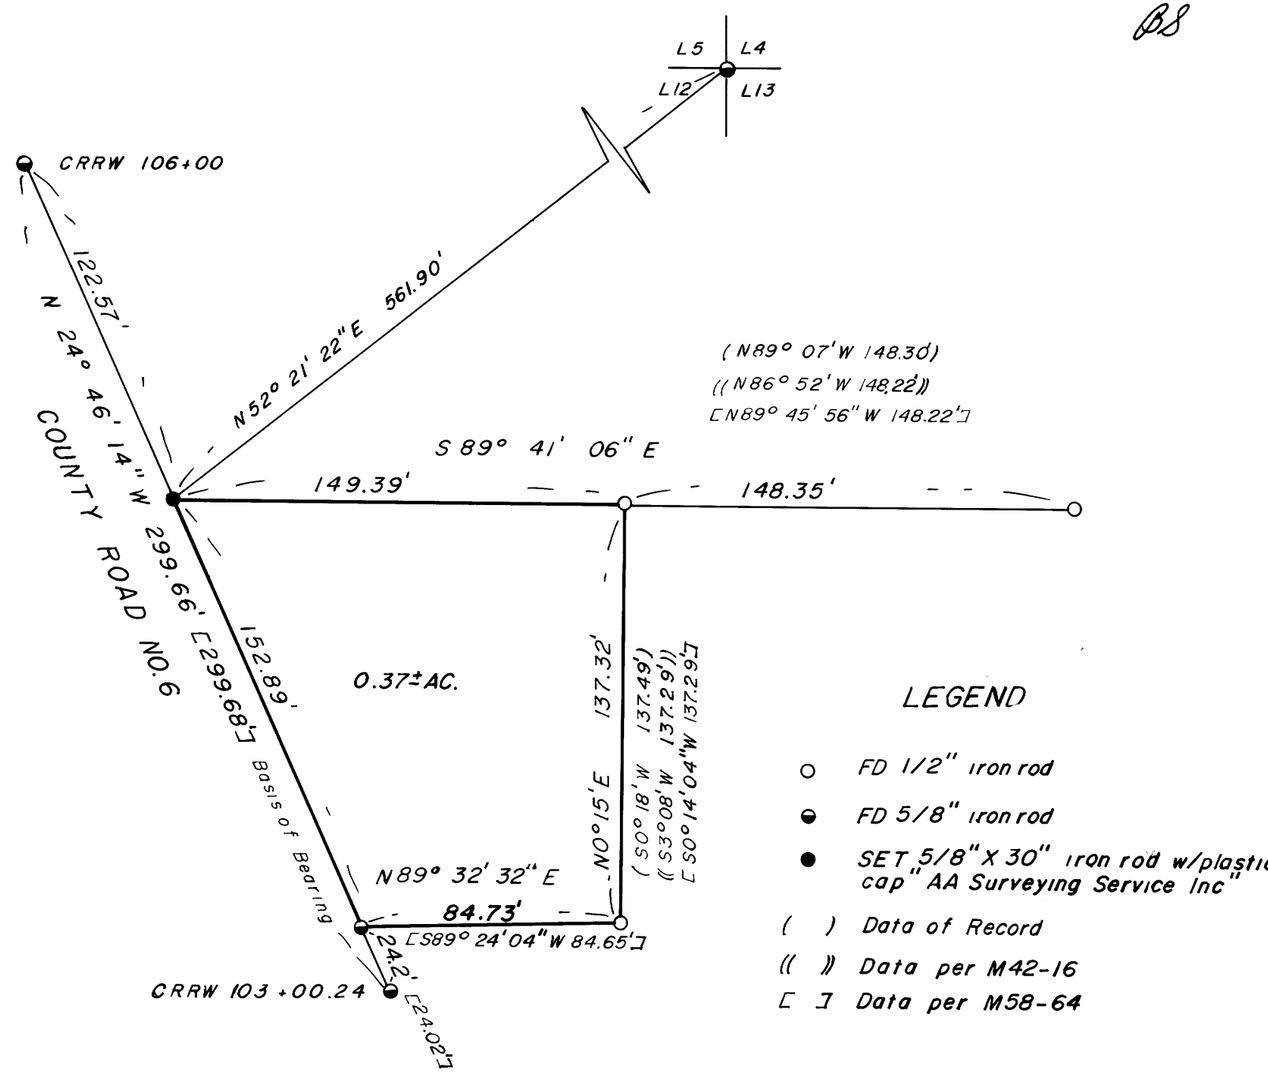

REGISTERED
PROFESSIONAL
LAND SURVEYOR
OREGON
JULY 14, 1978
EUGENE A. BLOOM
452

LEGEND

- ○ FD 1/2" iron rod
- ◒ FD 5/8" iron rod
- ● SET 5/8" X 30" iron rod w/plastic cap "AA Surveying Service Inc"
- ( ) Data of Record
- (( )) Data per M42-16
- [ ] Data per M58-64

M 97-45

PREPARED BY

AA SURVEYING SERVICE, INC. PO BOX 130 ROSEBURG, OREGON 97470

JOB 477-84