COUNTY SURVEYORS FILE DATA
DO NOT REMOVE FROM OFFICE

Resurvey and Subdivision of E½ Section 32, T 30 S, R 7 W, W. M., Oregon

For Roseburg Lumber Company

September 24, 1984

Scale: 1" = 400'

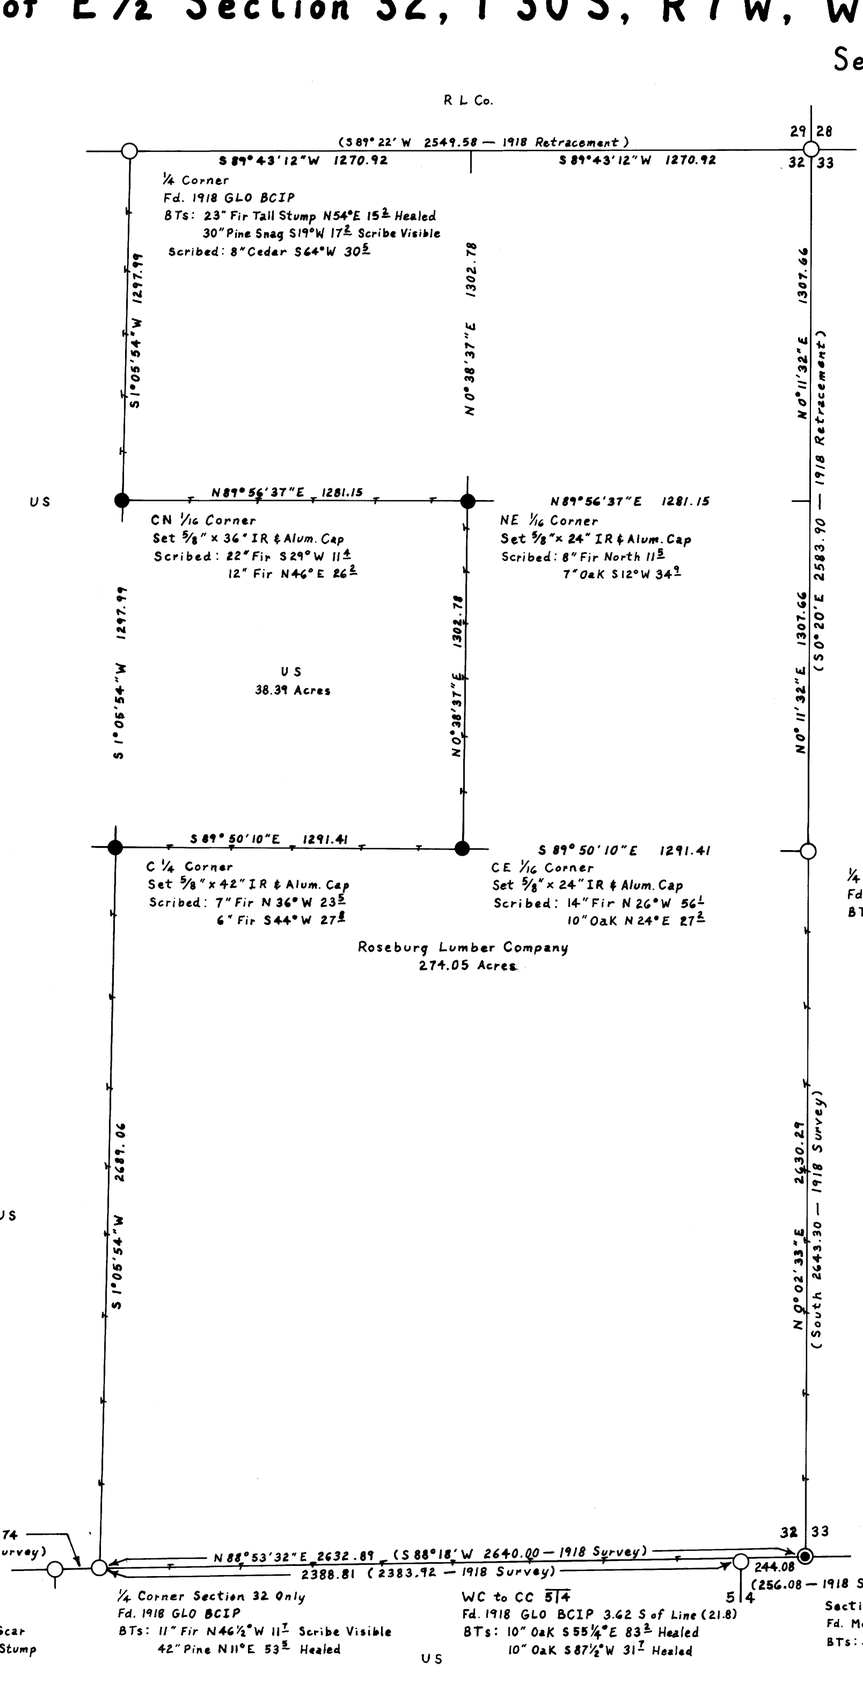

31 | 32

Legend

- ○ Monument Found as Indicated
- ● Set 5/8" IR & Alum. Cap Marked "LS 498"
- ◉ Found Corner Evidence — Set 5/8" IR & Alum. Cap Marked "LS 498"
- —— Section or Subdivision Line
- —T— Line Referenced to Alum. Tags
- ( ) Record Data

Bearing Based on Solar Observation

I ran a closed traverse in Section 32 using a Jena I second theodolite and a Mac 1-E EDM. I achived a precision of 1:110,562 and adjusted the traverse by the Crandall method. I set the corners by standard subdivision procedure based on the location of the existing monuments.

Howard W. Johnstone P. O. Box 1088 Roseburg, Oregon

REGISTERED
PROFESSIONAL
LAND SURVEYOR
Howard W. Johnstone
OREGON
MAY 13, 1960
HOWARD W. JOHNSTONE
498

N 97-50