COUNTY SURVEYORS FILE DATA
DO NOT REMOVE FROM OFFICE

RECORD OF SURVEY

COOKED WASSEN CADASTRAL SURVEY
FOR THE U.S.D.A. FOREST SERVICE
SIUSLAW NATIONAL FOREST
SECTION 7, T21S, R10W, W.M.

DOUGLAS COUNTY, OREGON
NOVEMBER 1984

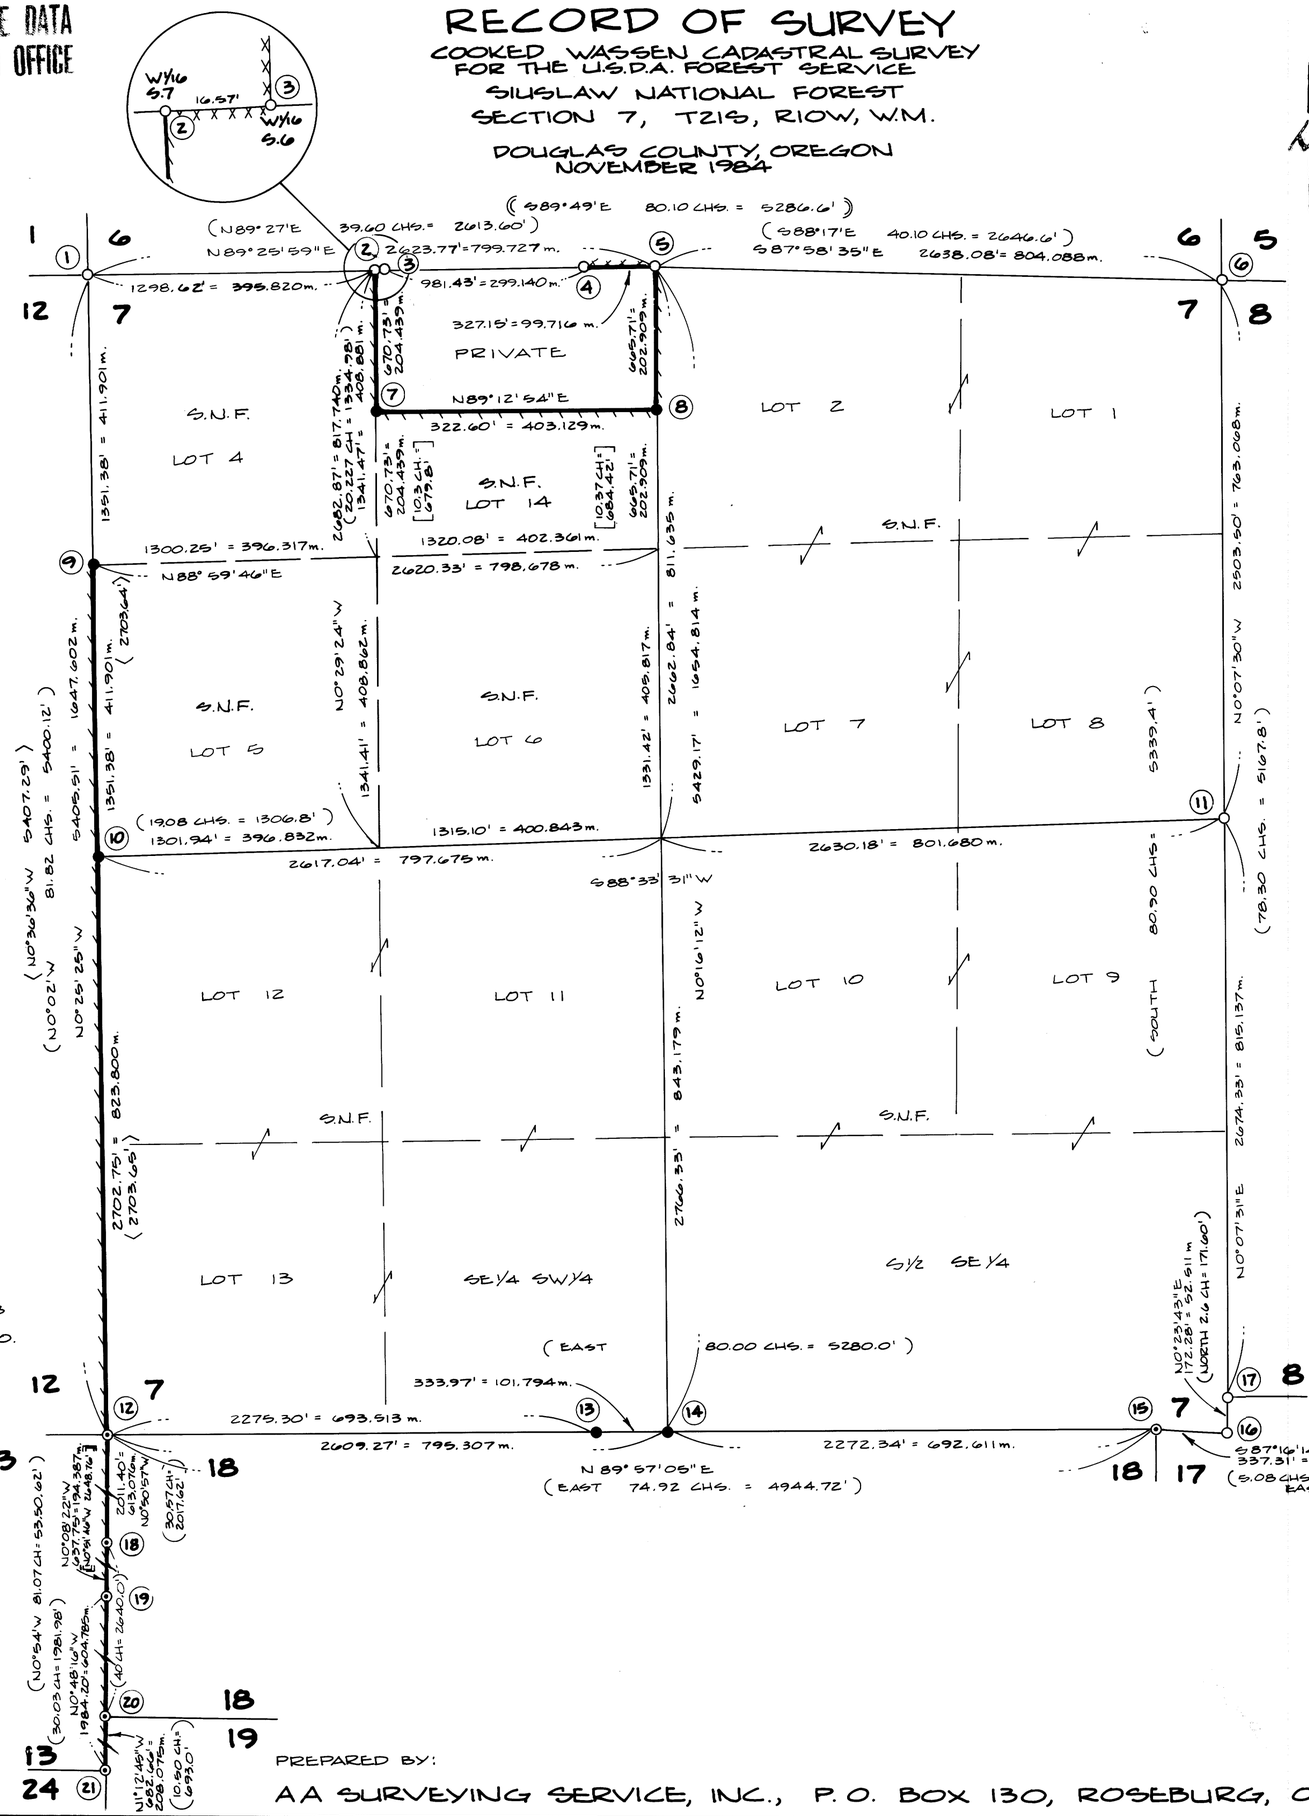

LEGEND:

- O – FOUND MONUMENT AS NOTED
- ● – SET MONUMENT AS NOTED
- ⊙ – CORNER REMONUMENTED AS NOTED

NOTES:

1. BASIS OF BEARINGS AND BEARINGS CHECKS ARE FROM SOLAR OBSERVATIONS
2. ( ) – INDICATES DATA OF RECORD PER G.L.O. RESURVEY IN 1919, CONTRACT NO. 36
3. (( )) – INDICATES DATA OF RECORD PER G.L.O. SURVEY IN 1867, CONTRACT NO. 116
4. [[ ]] – INDICATES DATA OF RECORD PER HINTZ SURVEY IN 1983, M95-40
5. ⟨ ⟩ – INDICATES DATA OF RECORD PER STUNTZNER SURVEY IN 1984, M96-23
6. [ ] – INDICATES DATA OF RECORD PER G.L.O. SUPPLEMENTAL PLAT, 1930
7. XXX – INDICATES LINES PREVIOUSLY POSITED
8. ||| – LINES POSTED THIS SURVEY WITH 6FT. ORANGE FIBERGLASS POSTS

500 0 500
152.400m. 152.400 m.

SCALE: 1" = 500'

3.28083 FEET = ONE METER

REGISTERED PROFESSIONAL LAND SURVEYOR
OREGON
JULY 14, 1978
HERMAN A. PIESKE
1651

I, HERMAN A. PIESKE, REGISTERED LAND SURVEYOR IN THE STATE OF OREGON, HEREBY CERTIFY THAT THIS PLAT AND THE NOTES HEREON ARE A CORRECT REPRESENTATION OF A SURVEY I PERFORMED DURING JUNE, 1983, - NOVEMBER, 1984, AT THE REQUEST OF THE U.S.D.A. FOREST SERVICE IN ACCORDANCE WITH THE STATUTES OF THE STATE OF OREGON AND THE ARTICLES OF MY CONTRACT.

HERMAN A. PIESKE
P.L.S. 1651

NARRATIVE:

PURPOSE:

TO MONUMENT AND MARK THE BOUNDARIES BETWEEN THE SIUSLAW NATIONAL FOREST LANDS AND PRIVATE OWNERSHIP.

HISTORY:

A HISTORY OF PRIOR SURVEYS WHICH PERTAIN TO THIS SURVEY IS AS FOLLOWS.

IN 1867, JOHN W. MELDRUM, UNDER CONTRACT NO. 116, SURVEYED THE NORTH BOUNDARY OF SECTION 7.

IN 1891, WILLIAM THIEL, UNDER CONTRACT NO. 567, SURVEYED THE EAST BOUNDARY OF TOWNSHIP 21 SOUTH, RANGE 11 WEST, WILLAMETTE MERIDIAN.

IN 1919, FRED W. RODOLPH, ELMER F. STRICKLER AND GERALD SORRELS, UNDER CONTRACT NO. 36, RESURVEYED THE NORTH BOUNDARY AND SUBDIVIDED SECTION 7. ALSO IN 1919, FRED MENSCH AND CHARLES M. COLLIER RESURVEYED A PORTION OF THE WEST BOUNDARY OF TOWNSHIP 21 SOUTH, RANGE 10 WEST, WILLAMETTE MERIDIAN.

IN 1983, RICHARD HINTZ SURVEYED THE NORTH HALF OF THE EAST LINE OF SECTION 13, TOWNSHIP 21 SOUTH, RANGE 11 WEST, WILLAMETTE MERIDIAN.

IN 1984, RONALD E. STUNTZNER SURVEYED THE WEST BOUNDARY OF SECTION 7.

PROCEDURE:

THIS SURVEY WAS ACCOMPLISHED PRIMARILY BY RANDOM TRAVERSE CLOSING INTO OUR LONG RANGE CONTROL. ALL KNOWN AND FOUND CORNERS WERE TIED INTO THE RANDOM TRAVERSES.

THE CORNERS ON THE NORTH AND EAST LINES WERE PREVIOUSLY FOUND OR SET UNDER THIS CONTRACT AND RECORDED IN THE DOUGLAS COUNTY SURVEYOR'S OFFICE.

AFTER A DILIGENT SEARCH WAS MADE AND NO ORIGINAL EVIDENCE FOUND, THE SOUTH ONE-QUARTER CORNER OF SECTION 7 AND NORTH ONE-QUARTER OF SECTION 18 AND WEST ONE-QUARTER OF SECTION 7, WERE SET BY PROPORTION.

THE ORIGINAL CORNERS (1919 RESURVEY) ALONG THE WEST BOUNDARY OF TOWNSHIP 21 SOUTH, RANGE 10 WEST, W.M., WERE FOUND TO BE IN POOR CONDITION SO I REMONUMENTED THE CORNERS AS SHOWN ON THE ANNEXED MAP.

THE SUPPLEMENTAL PLAT OF 1930 SHOWING THE DIVISION OF LOT 3 IS IN ERROR; THE WEST LINE OF LOT 4 & 5 ON THE 1919 PLAT MAP IS ALSO IN ERROR (DIST. CALLS). THE ORIGINAL INTENT OF A LAND TRADE WAS TO SPLIT LOT 3 EQUALLY (PER DEED - REC. NO. 019263). THIS WAS CONFIRMED WITH THE CADASTRAL DIVISION OF THE B.L.M., PORTLAND, OREGON.

THE CORNERS REMONUMENTED AND PROPORTIONED WERE DONE ACCORDING TO THE 1973 BLM MANUAL OF INSTRUCTIONS. ALL OF THE CORNERS SET MEET THE POSITIONAL TOLERANCE SPECIFICATIONS OF MY CONTRACT.

THE INSTRUMENTS USED ON THIS SURVEY WERE: TOPCON GTS-2 AND A STAFF COMPASS TO DETERMINE B.T. BEARINGS. ALSO USED WAS AN H.P. 3800 E.D.M. FOR MEASURING LONG RANGE DISTANCES.

REFERENCE FIELD BOOKS: #1 - #37.

CONTRACT NO. 53-04TO-3-0870N

PREPARED BY:

AA SURVEYING SERVICE, INC., P.O. BOX 130, ROSEBURG, OREGON 97470

M97-778

M97-778