COUNTY SURVEYORS FILE DATA
DO NOT REMOVE FROM OFFICE

CMO

M98-45

Resurvey And Subdivision of SE ¼ Section 5 And NE ¼ Section 8, T 31 S, R 7 W, W.M., Oregon

For Roseburg Lumber Company

March 22, 1985

Scale: 1" = 400'

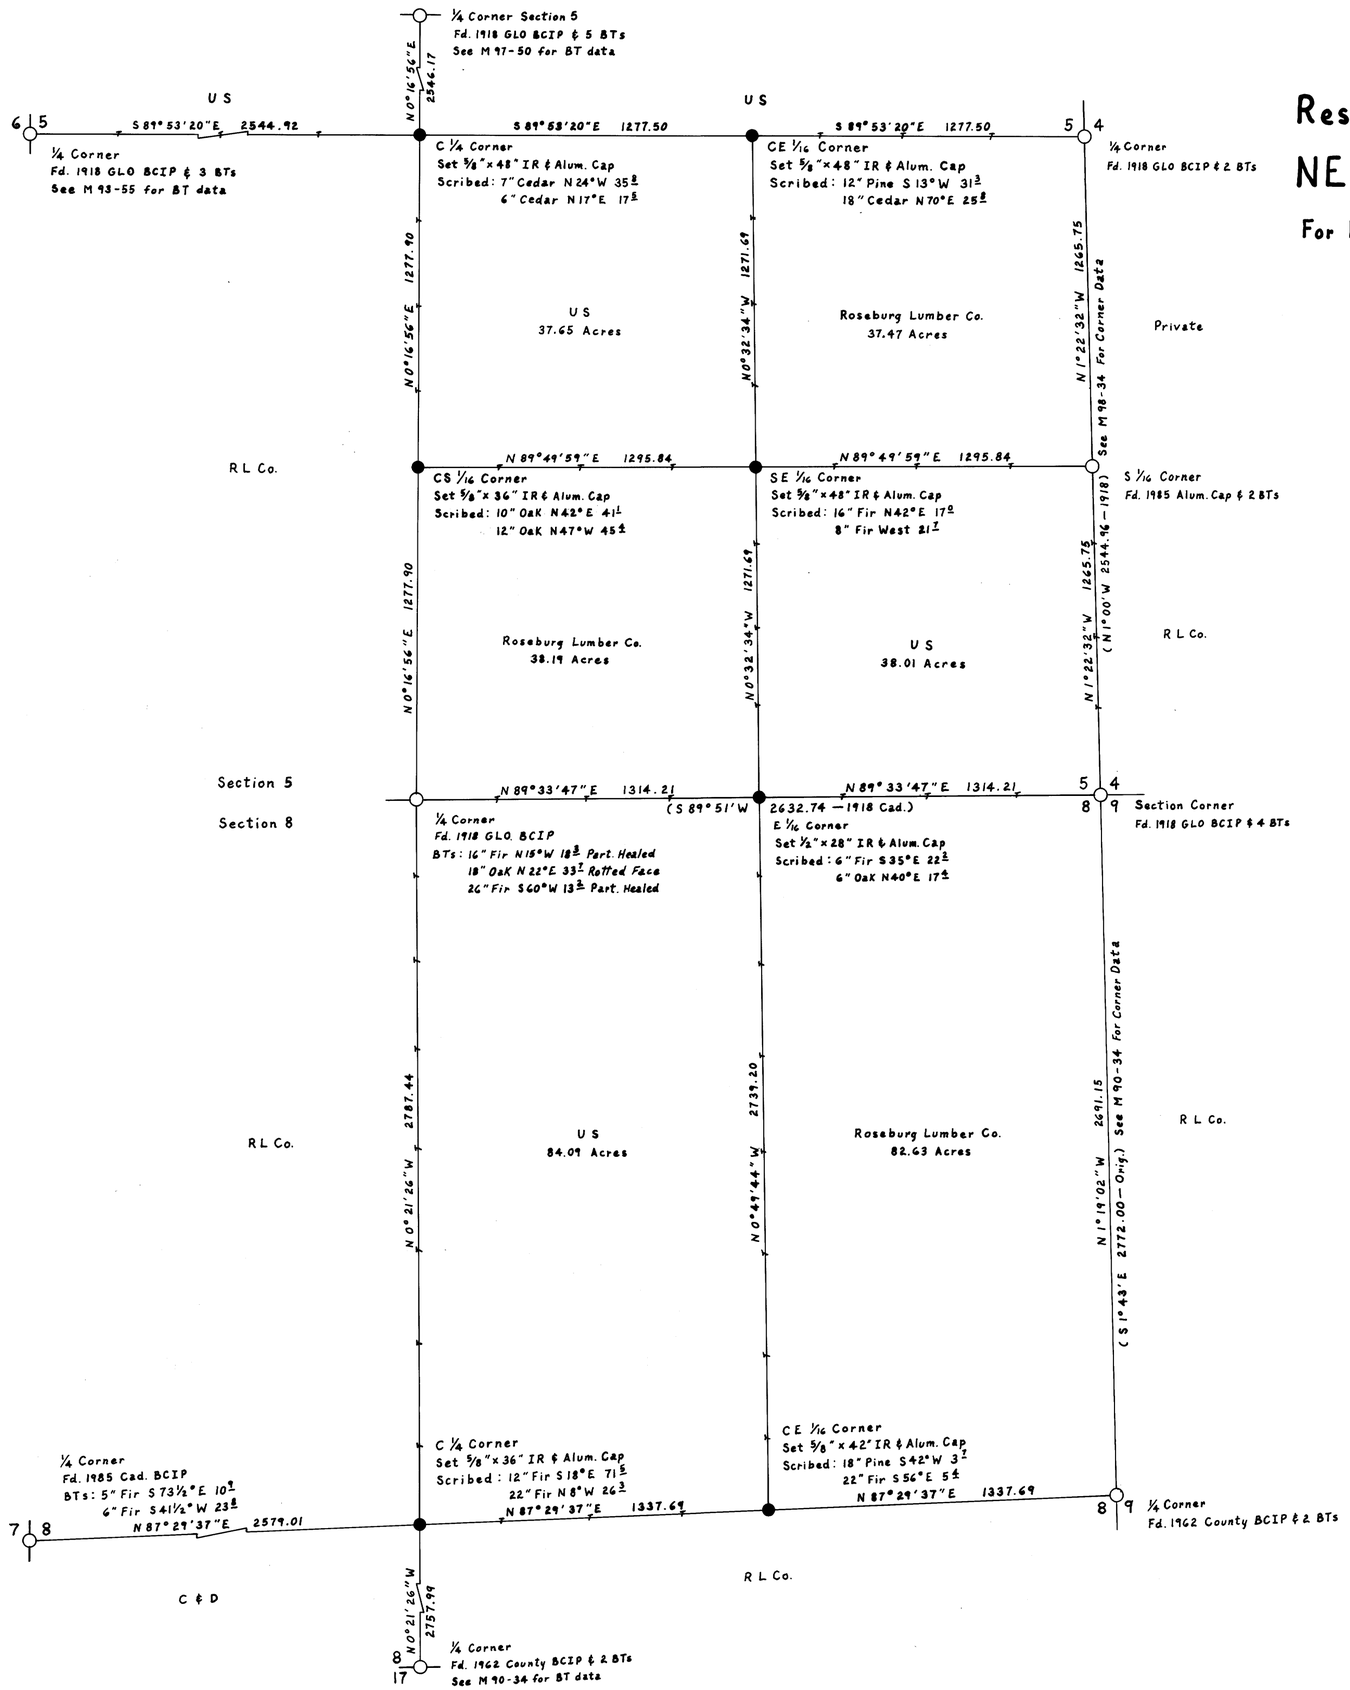

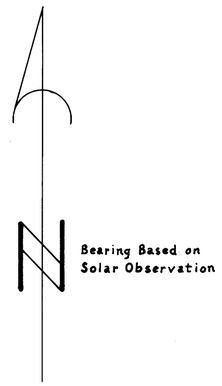

Legend

- ○ Monument Found as Noted
- ● Set Iron Rod & Alum. Cap MarKed "LS 498"
- —— Section or Subdivision Line
- —T— Line Referenced to Alum. Tags
- ( ) Record Data

I ran a closed traverse in Sections 5 and 8 using a NiKon NTD 4 total station. I achieved a precision of 1:50,898 and adjusted the traverse by the Crandall method. I set the corners by standard subdivision procedure based on the location of the existing monuments.

Howard W. Johnstone *P.O. Box 1088* *Roseburg, Oregon*

REGISTERED
PROFESSIONAL
LAND SURVEYOR

Howard W. Johnstone

OREGON
MAY 13, 1960
HOWARD W. JOHNSTONE
498

M98-45