COUNTY SURVEYOR'S FILE DATA
DO NOT REMOVE FROM OFFICE

SURVEY FOR ADJUSTMENT OF LOT LINES
IN LOTS 2, 3, & 12 OF TWO-OAKS TRACTS BLOCK ONE VOL 11, PG. 2
IN THE S.E. 1/4 SECTION 16, T. 28 S., R. 6 W., W.M. DOUGLAS COUNTY

FOR - LEWIS KIMBALL
P.O. BOX 145
WINSTON, OREGON

BY - ROMEY WARE
2771 GARDEN VALLEY RD.
ROSEBURG, OREGON

FILED CMO
RECEIVED
MAY 13 1985
COUNTY SURVEYOR
DOUGLAS COUNTY, ORE.
CMO

MAP FILE M98-59

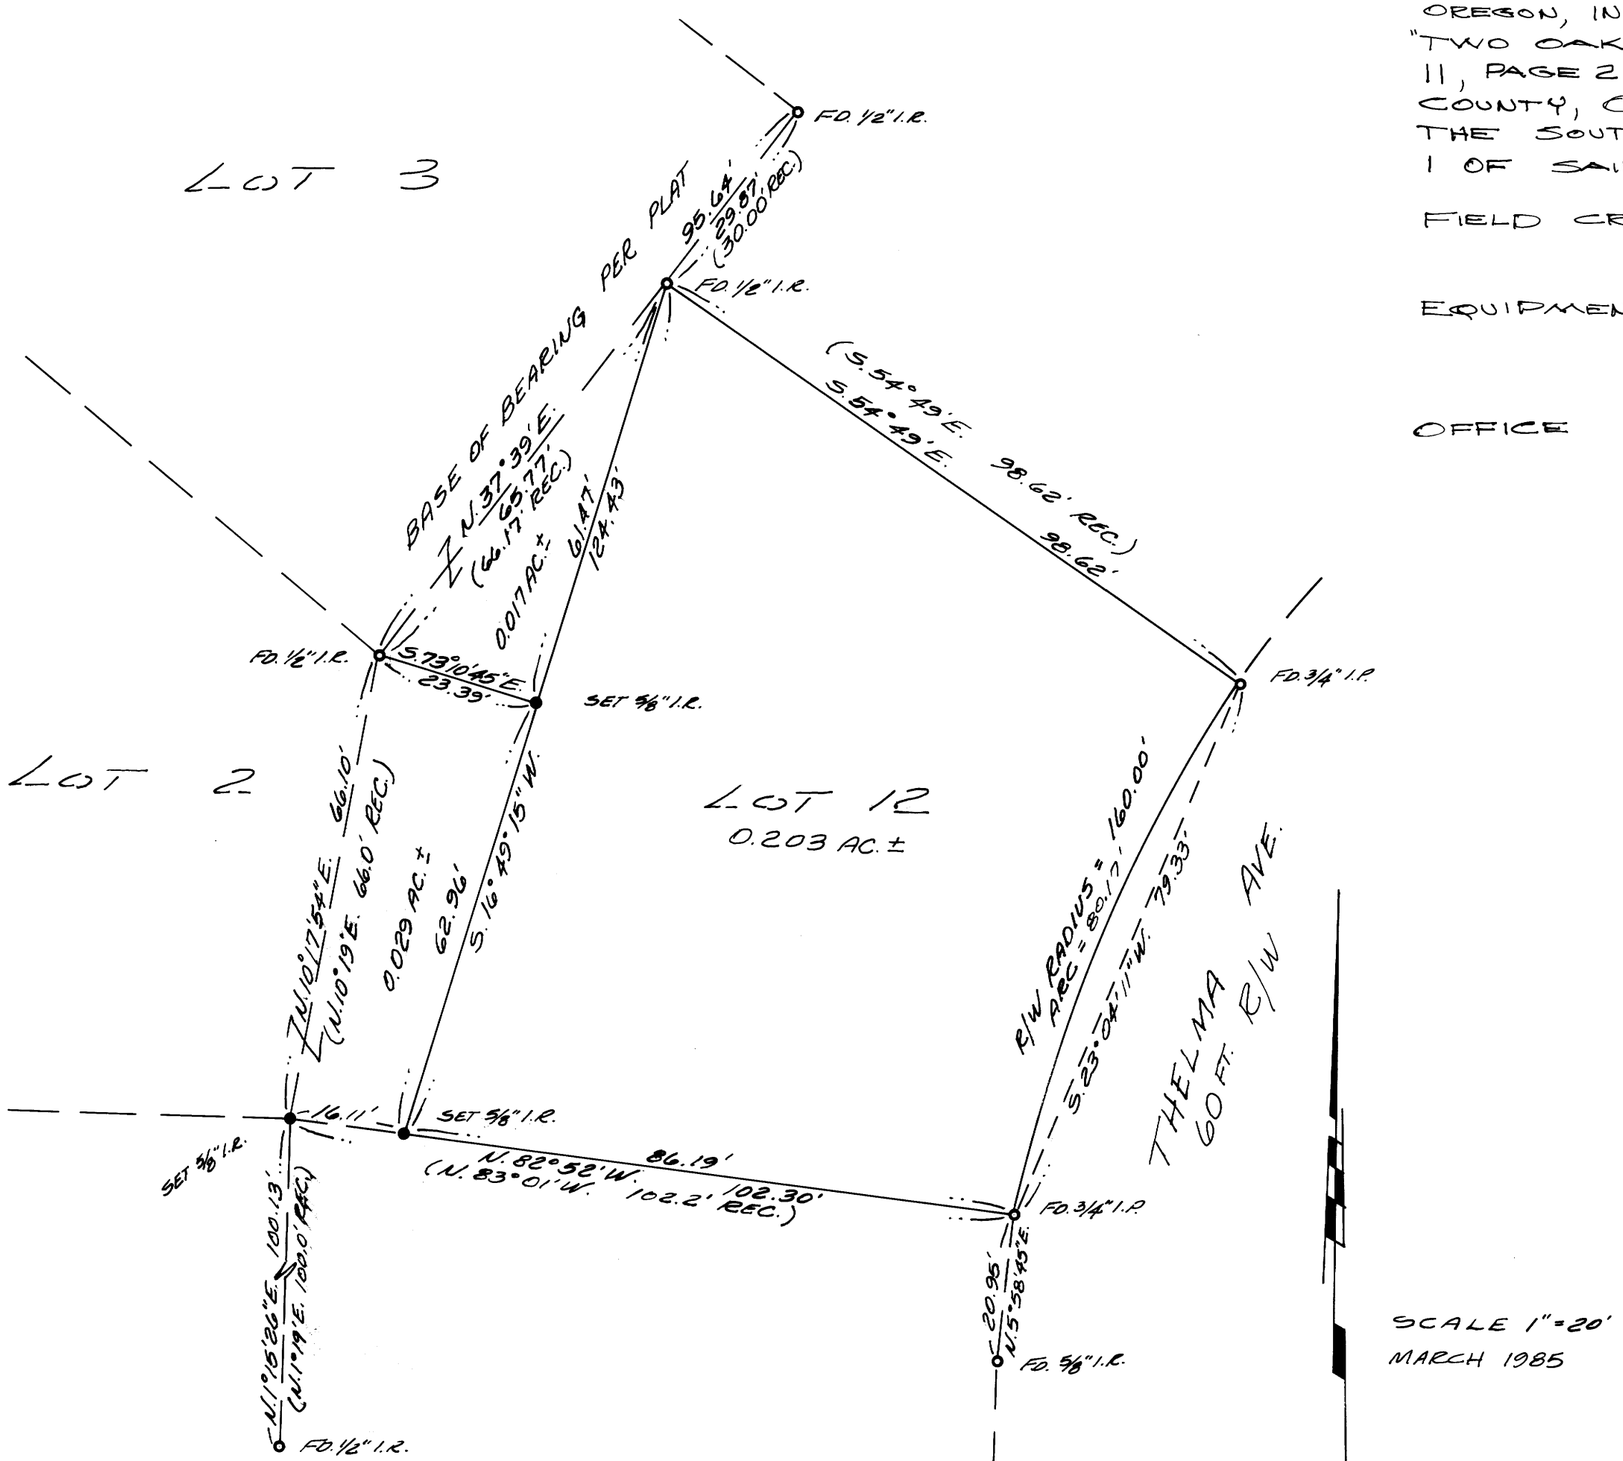

NARRATIVE

SURVEY TO CREATE AN ADJUSTMENT OF LOT LINES AS APPROVED BY THE CITY OF WINSTON, OREGON, IN LOTS 2, 3, AND 12 OF BLOCK 1 OF "TWO OAKS TRACTS" AS RECORDED IN VOLUME 11, PAGE 2 IN THE PLAT RECORDS OF DOUGLAS COUNTY, OREGON. BASIS OF BEARING PER THE SOUTHEASTERLY LINE OF LOT 3, BLOCK 1 OF SAID "TWO-OAKS TRACTS".

FIELD CREW: MIKE RADCLIFFE, BILL KIMBALL AND NEIL HIBBS.

EQUIPMENT : WILD T16 THEODOLITE MOUNTED WITH A NIKKON NO160 EDM.

OFFICE : ROMEY WARE & MIKE RADCLIFFE

LEGEND:

o - FOUND 5/8" IRON ROD UNLESS NOTED OTHERWISE

• - SET 5/8" x 30" IRON ROD W/CAP MKD. "R.E. WARE L.S. 1005"

REGISTERED PROFESSIONAL LAND SURVEYOR
Romanso E. Ware
OREGON
NOV. 16, 1973
ROMANSO E. WARE
1005

SCALE 1" = 20'
MARCH 1985

MAP FILE M98-59