A SURVEY FOR HAYWARD REED IN FAIRMOUNT SUBDIVISION IN NW¼ OF NE¼ SEC. 13, T27S, R6W, W.M.

SURVEYED BY: DONALD A. BENTZ, INC.
P.O. BOX 901
WINCHESTER, OR. 97495

FILED
RECEIVED
OCT 1985
COUNTY SURVEYOR
DOUGLAS COUNTY, ORE.

COUNTY SURVEYORS FILE DATA
DO NOT REMOVE FROM OFFICE

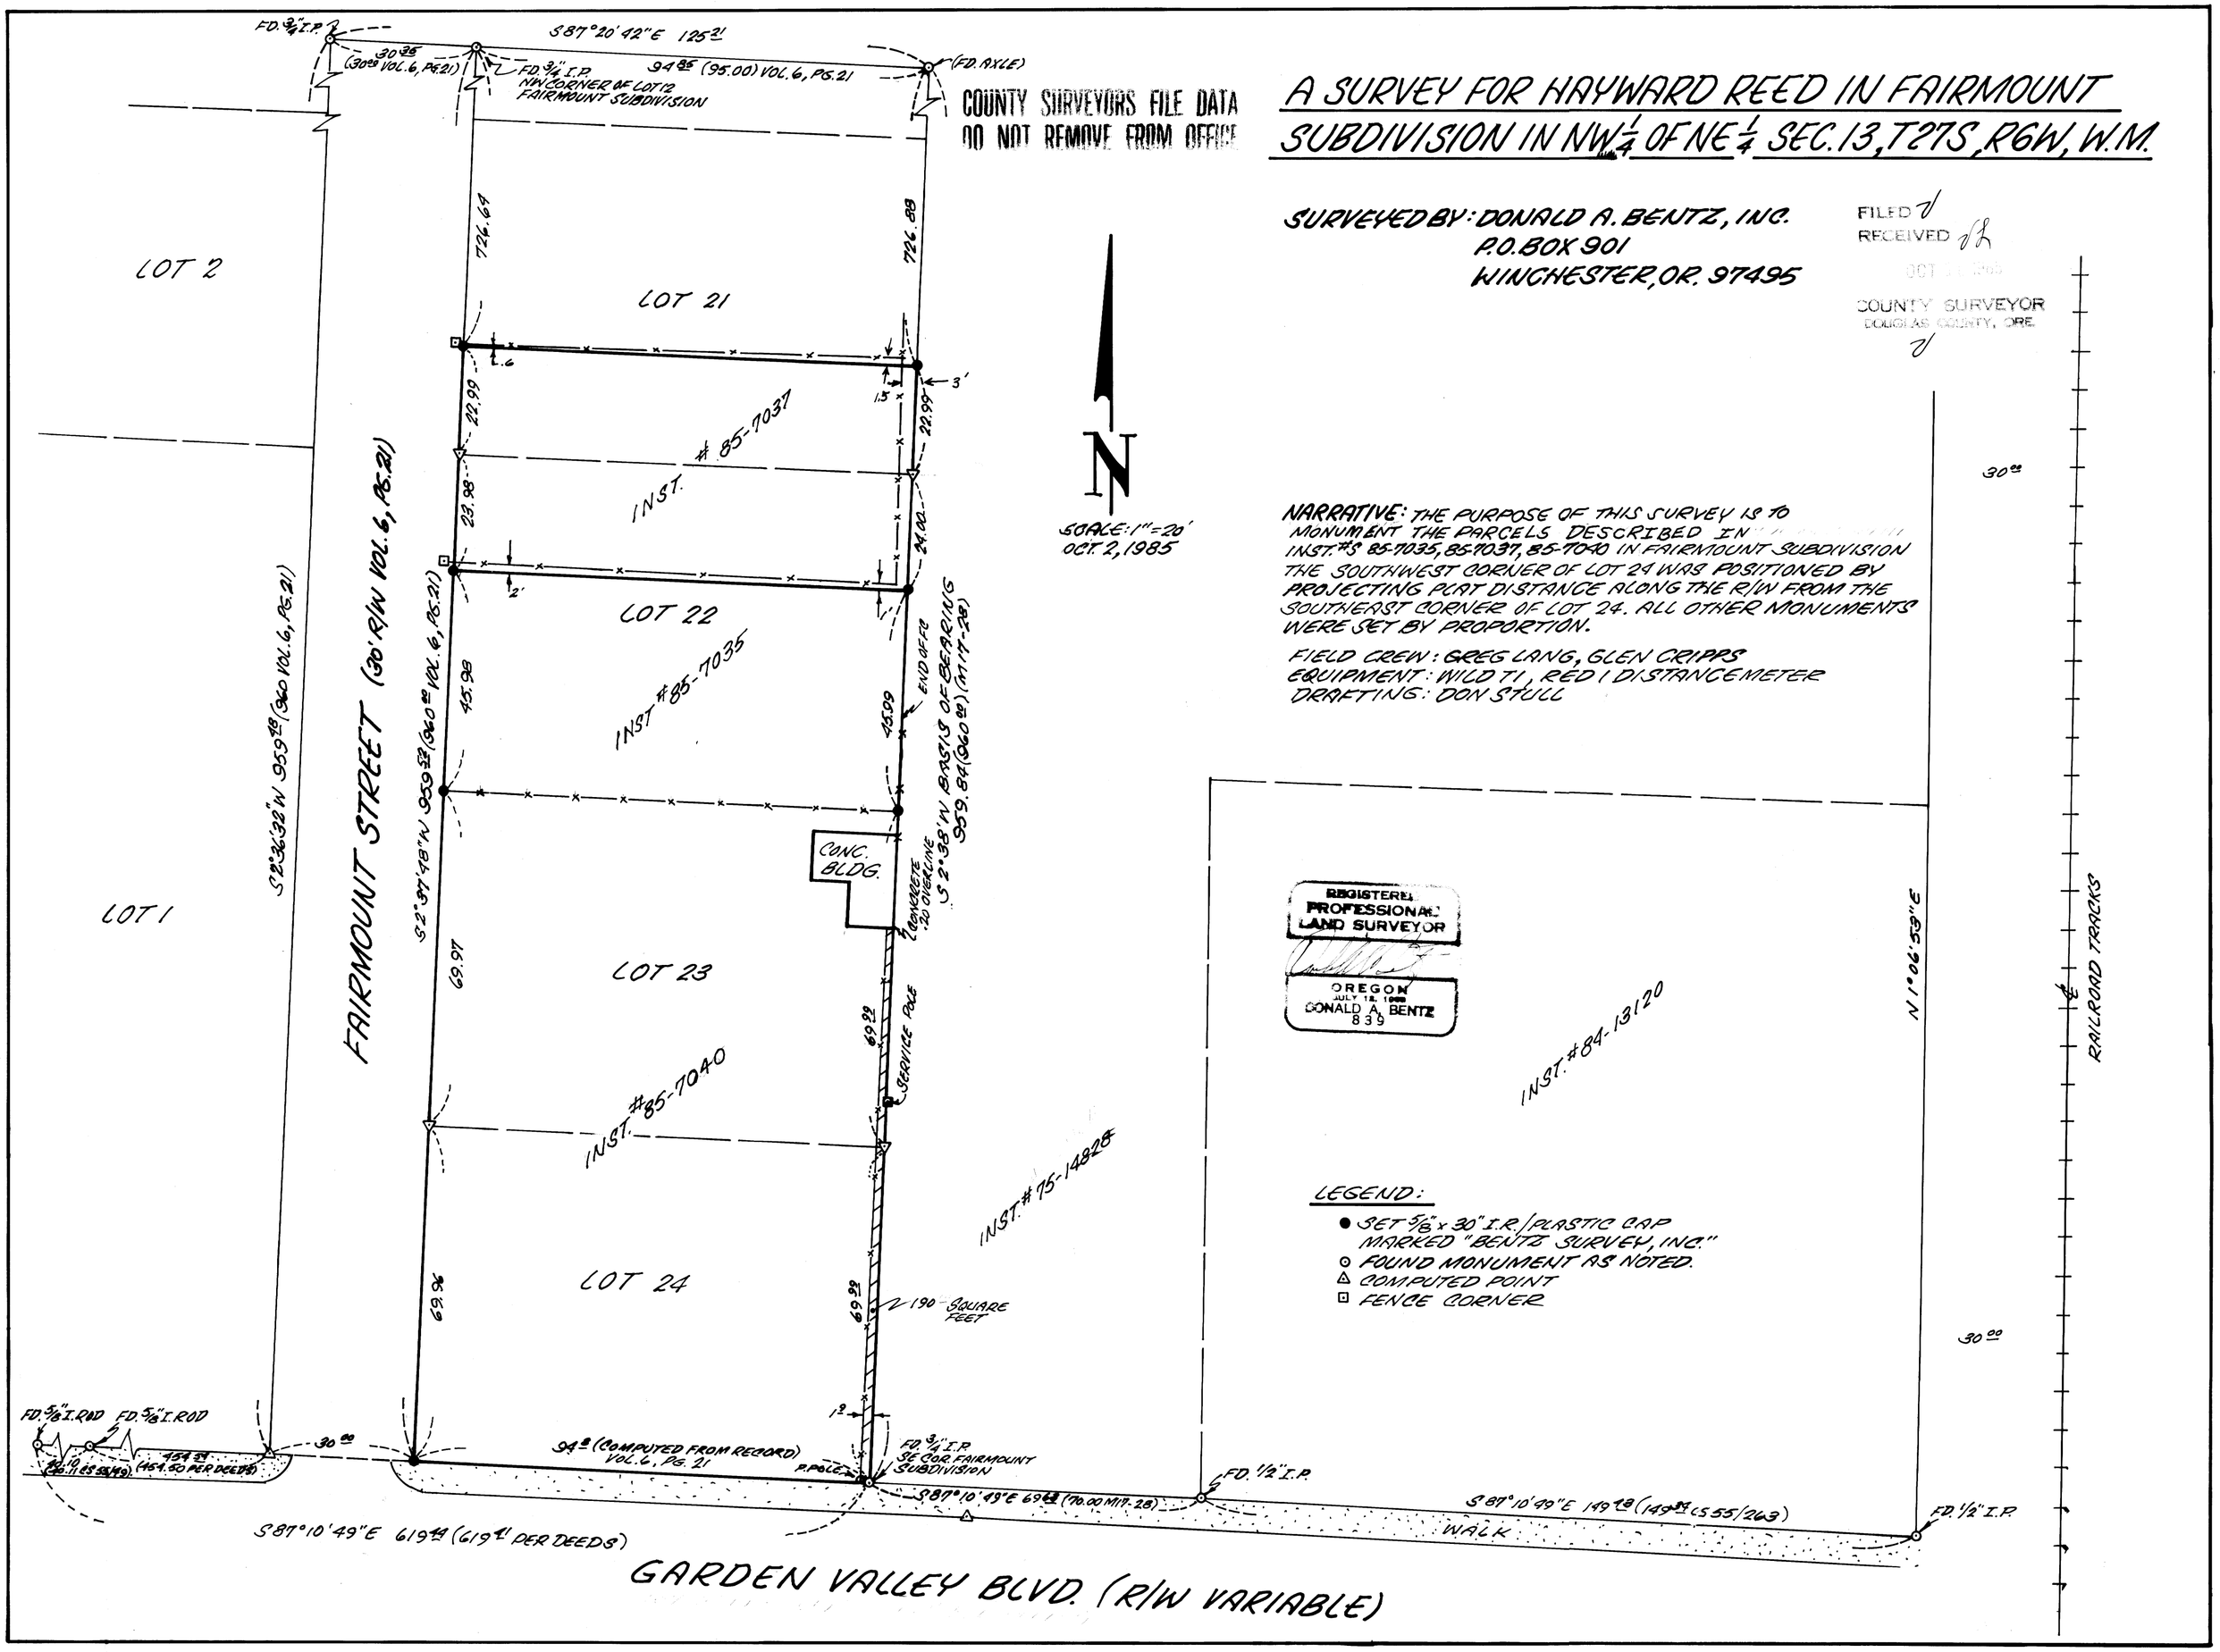

NARRATIVE: THE PURPOSE OF THIS SURVEY IS TO MONUMENT THE PARCELS DESCRIBED IN INST. #'S 85-7035, 85-7037, 85-7040 IN FAIRMOUNT SUBDIVISION. THE SOUTHWEST CORNER OF LOT 24 WAS POSITIONED BY PROJECTING PLAT DISTANCE ALONG THE R/W FROM THE SOUTHEAST CORNER OF LOT 24. ALL OTHER MONUMENTS WERE SET BY PROPORTION.

FIELD CREW: GREG LANG, GLEN CRIPPS
EQUIPMENT: WILD T1, RED 1 DISTANCEMETER
DRAFTING: DON STULL

REGISTERED PROFESSIONAL LAND SURVEYOR
OREGON
JULY 12, 1966
DONALD A. BENTZ
839

LEGEND:

- ● SET 5/8" x 30" I.R./PLASTIC CAP MARKED "BENTZ SURVEY, INC."
- ⊙ FOUND MONUMENT AS NOTED.
- △ COMPUTED POINT
- ⊡ FENCE CORNER

MAP FILE M99-54

MAP FILE M99-54