PROPERTY SURVEY IN LOTS 5 AND 6, BLOCK 42, OAKLAND RAILROAD ADDITION
N.W. 1/4, SECTION 4, T.25 S., R.5 W., W.M., OAKLAND, OREGON

COUNTY SURVEYORS FILE DATA
DO NOT REMOVE FROM OFFICE

FOR: MARY GERMOND

BY: ROBERT L. DOLAN
RT. 1 BOX 1820
SUTHERLIN, OR. 97479

DATE: SEPTEMBER, 1985

SCALE: 1" = 100'

LEGEND: o = AS NOTED
● = SET 5/8" x 30" IRON ROD W/CAP (LS 1076)

FILED CMO
RECEIVED
OCT 22 1985
COUNTY SURVEYOR
DOUGLAS COUNTY, ORE.
CMO

MAP FILE M99-64

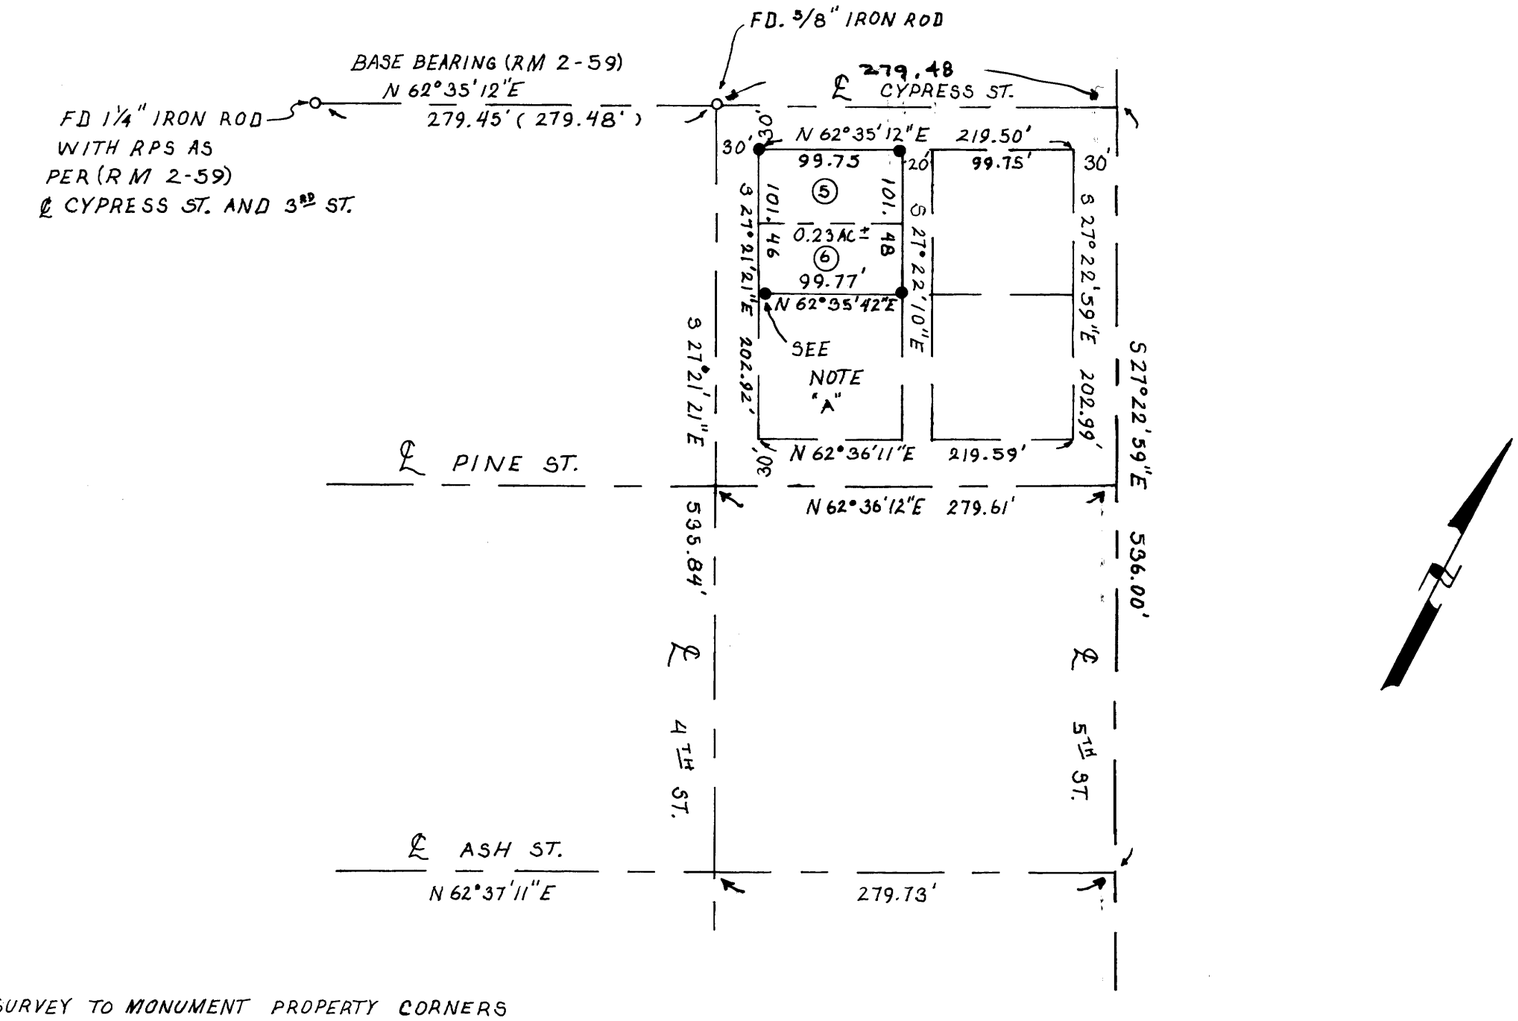

NARRATIVE: SURVEY TO MONUMENT PROPERTY CORNERS
INSTRUMENTS: DISTANCE METER, THEODOLITE

NOTE A: NO SCALE

SOUTHWEST CORNER LOT 6 — 5.0' N 62°35'42"E

POINT FALLS ON CONCRETE BLOCK
5/8" x 30" IRON ROD W/CAP
SET N 62°35'42"E, 5.0 FT.

POINTS FOR CORNERS WERE COMPUTED FROM FOUND PINS AND RECORD BEARINGS AND DISTANCES FROM (R M 2-59).

REGISTERED
PROFESSIONAL
LAND SURVEYOR
OREGON
JULY 30, 1976
ROBERT L. DOLAN
1076

M99-64