COUNTY SURVEYORS FILE DATA
DO NOT REMOVE FROM OFFICE

FILED CMO
RECEIVED
CMO

A SURVEY FOR ABBY'S PIZZA...

... LOCATED IN THE NE¼ OF THE SW¼ AND THE NW¼ OF THE SE¼ OF SECTION 28, TOWNSHIP 29 SOUTH, RANGE 5 WEST, W.M. ALSO LOCATED IN JOHN ADAMS D.L.C. #41.

SURVEYOR
DONALD A. BENTZ
P.O. BOX 901
WINCHESTER, OR.
97495

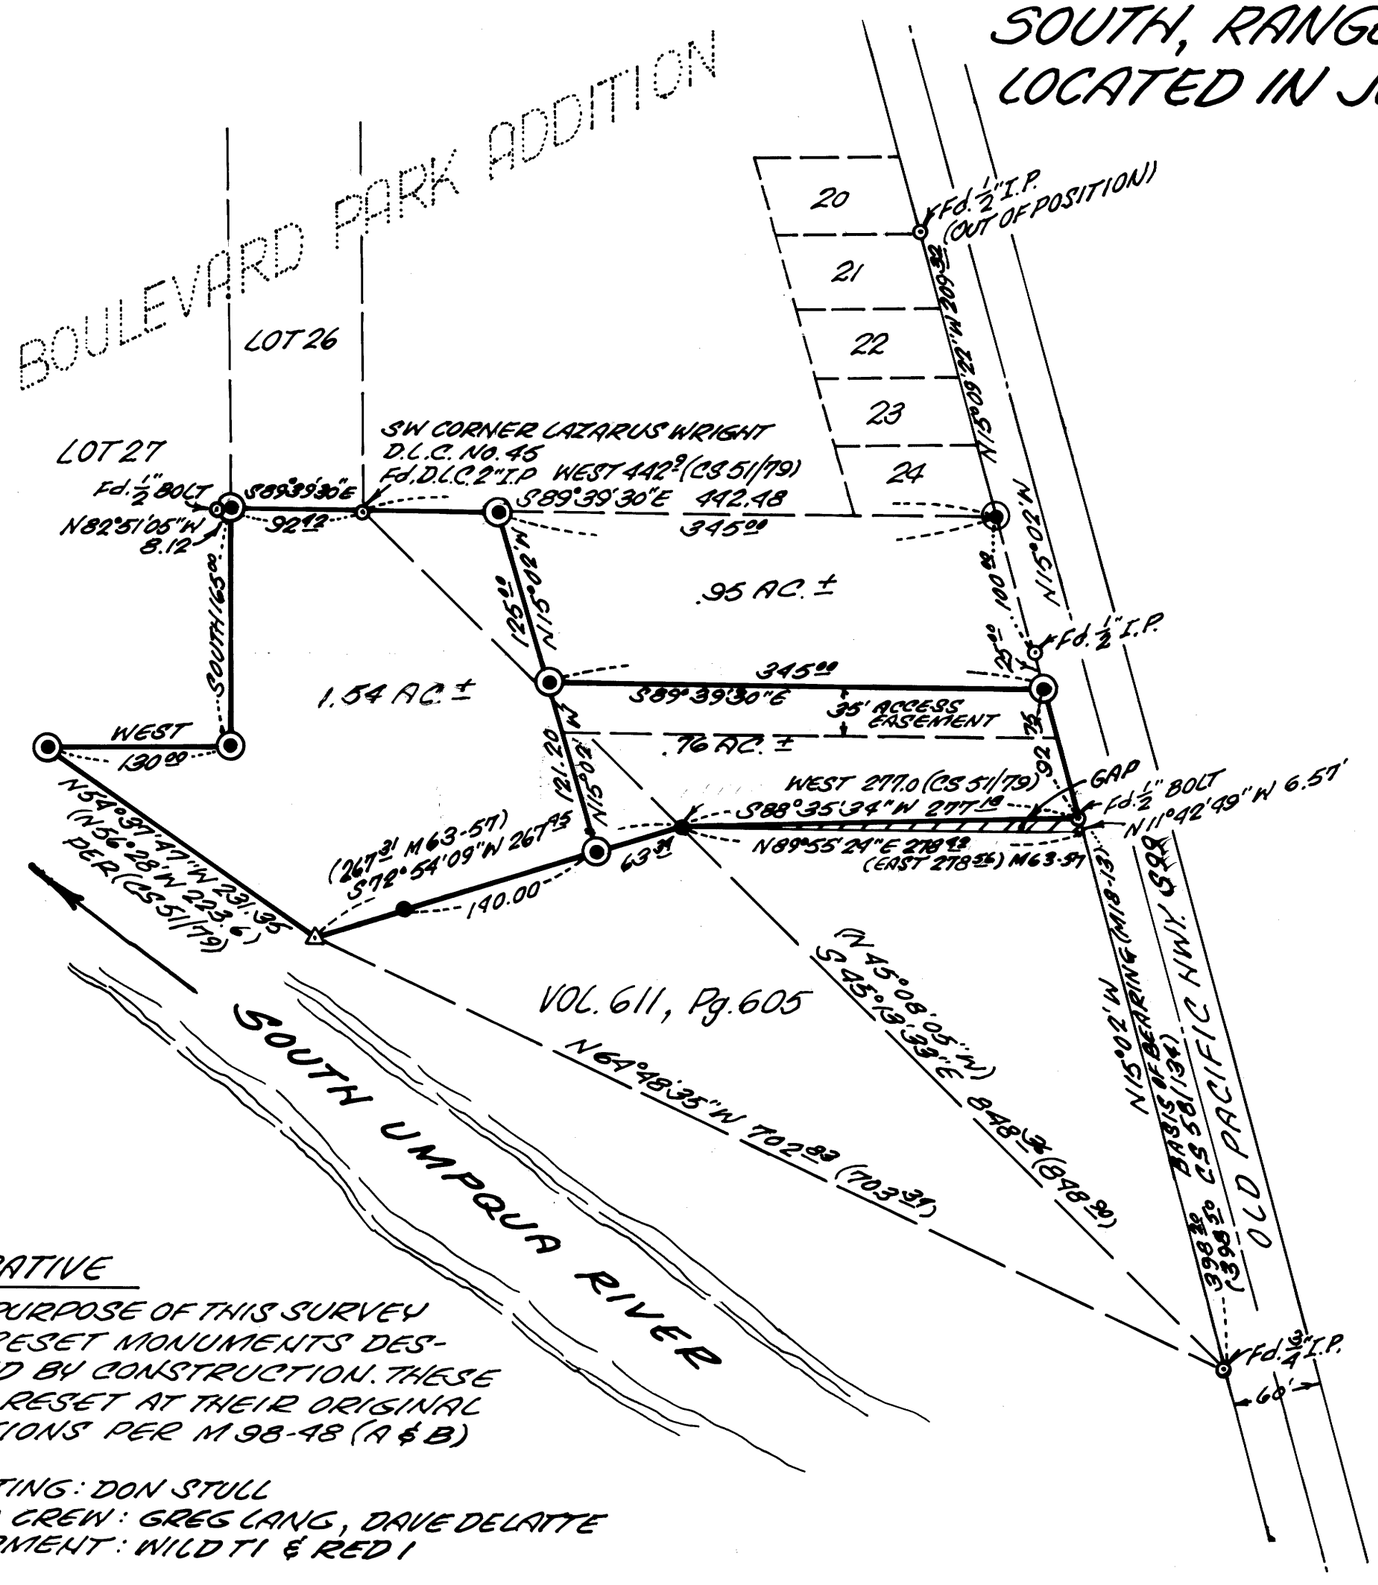

REGISTERED PROFESSIONAL LAND SURVEYOR
OREGON
JULY 14, 1978
DONALD A. BENTZ
839

LEGEND

- ⊙ FOUND AS NOTED
- ◉ FOUND ⅝" x 30" IRON ROD WITH PLASTIC CAP MARKED "BENTZ SURV., INC."
- △ COMPUTED POINT
- ● SET ⅝" x 30" I.R. / PLASTIC CAP MKD. "BENTZ SURV., INC."

N

SCALE: 1" = 100'
OCT. 18, 1985

NARRATIVE

THE PURPOSE OF THIS SURVEY IS TO RESET MONUMENTS DESTROYED BY CONSTRUCTION. THESE WERE RESET AT THEIR ORIGINAL POSITIONS PER M 98-48 (A & B)

DRAFTING: DON STULL
FIELD CREW: GREG LANG, DAVE DELATTE
EQUIPMENT: WILD T1 & RED 1

MAP FILE M99-65

M99-65