M99-72

PROPERTY SURVEY IN LOTS 4 AND 5, BLOCK 4, PLAT D, BLOCKS 2, 4, AND 5, SUTHERLIN LAND AND WATER CO., W 1/2, SECTION 14, T.25S., R.5W., W.M., DOUGLAS COUNTY, OREGON

COUNTY SURVEYOR'S FILE DATA
DO NOT REMOVE FROM OFFICE

FOR: GEORGE BROWN

BY: ROBERT L. DOLAN
RT. 1 BOX 1820
SUTHERLIN, OR 97479

DATE: OCTOBER 1985
SCALE: 1" = 100'
LEGEND: ○ FOUND AS NOTED
● SET 5/8" X 30" IRON ROD W/CAP (L.S. 1076)
( ) RECORD

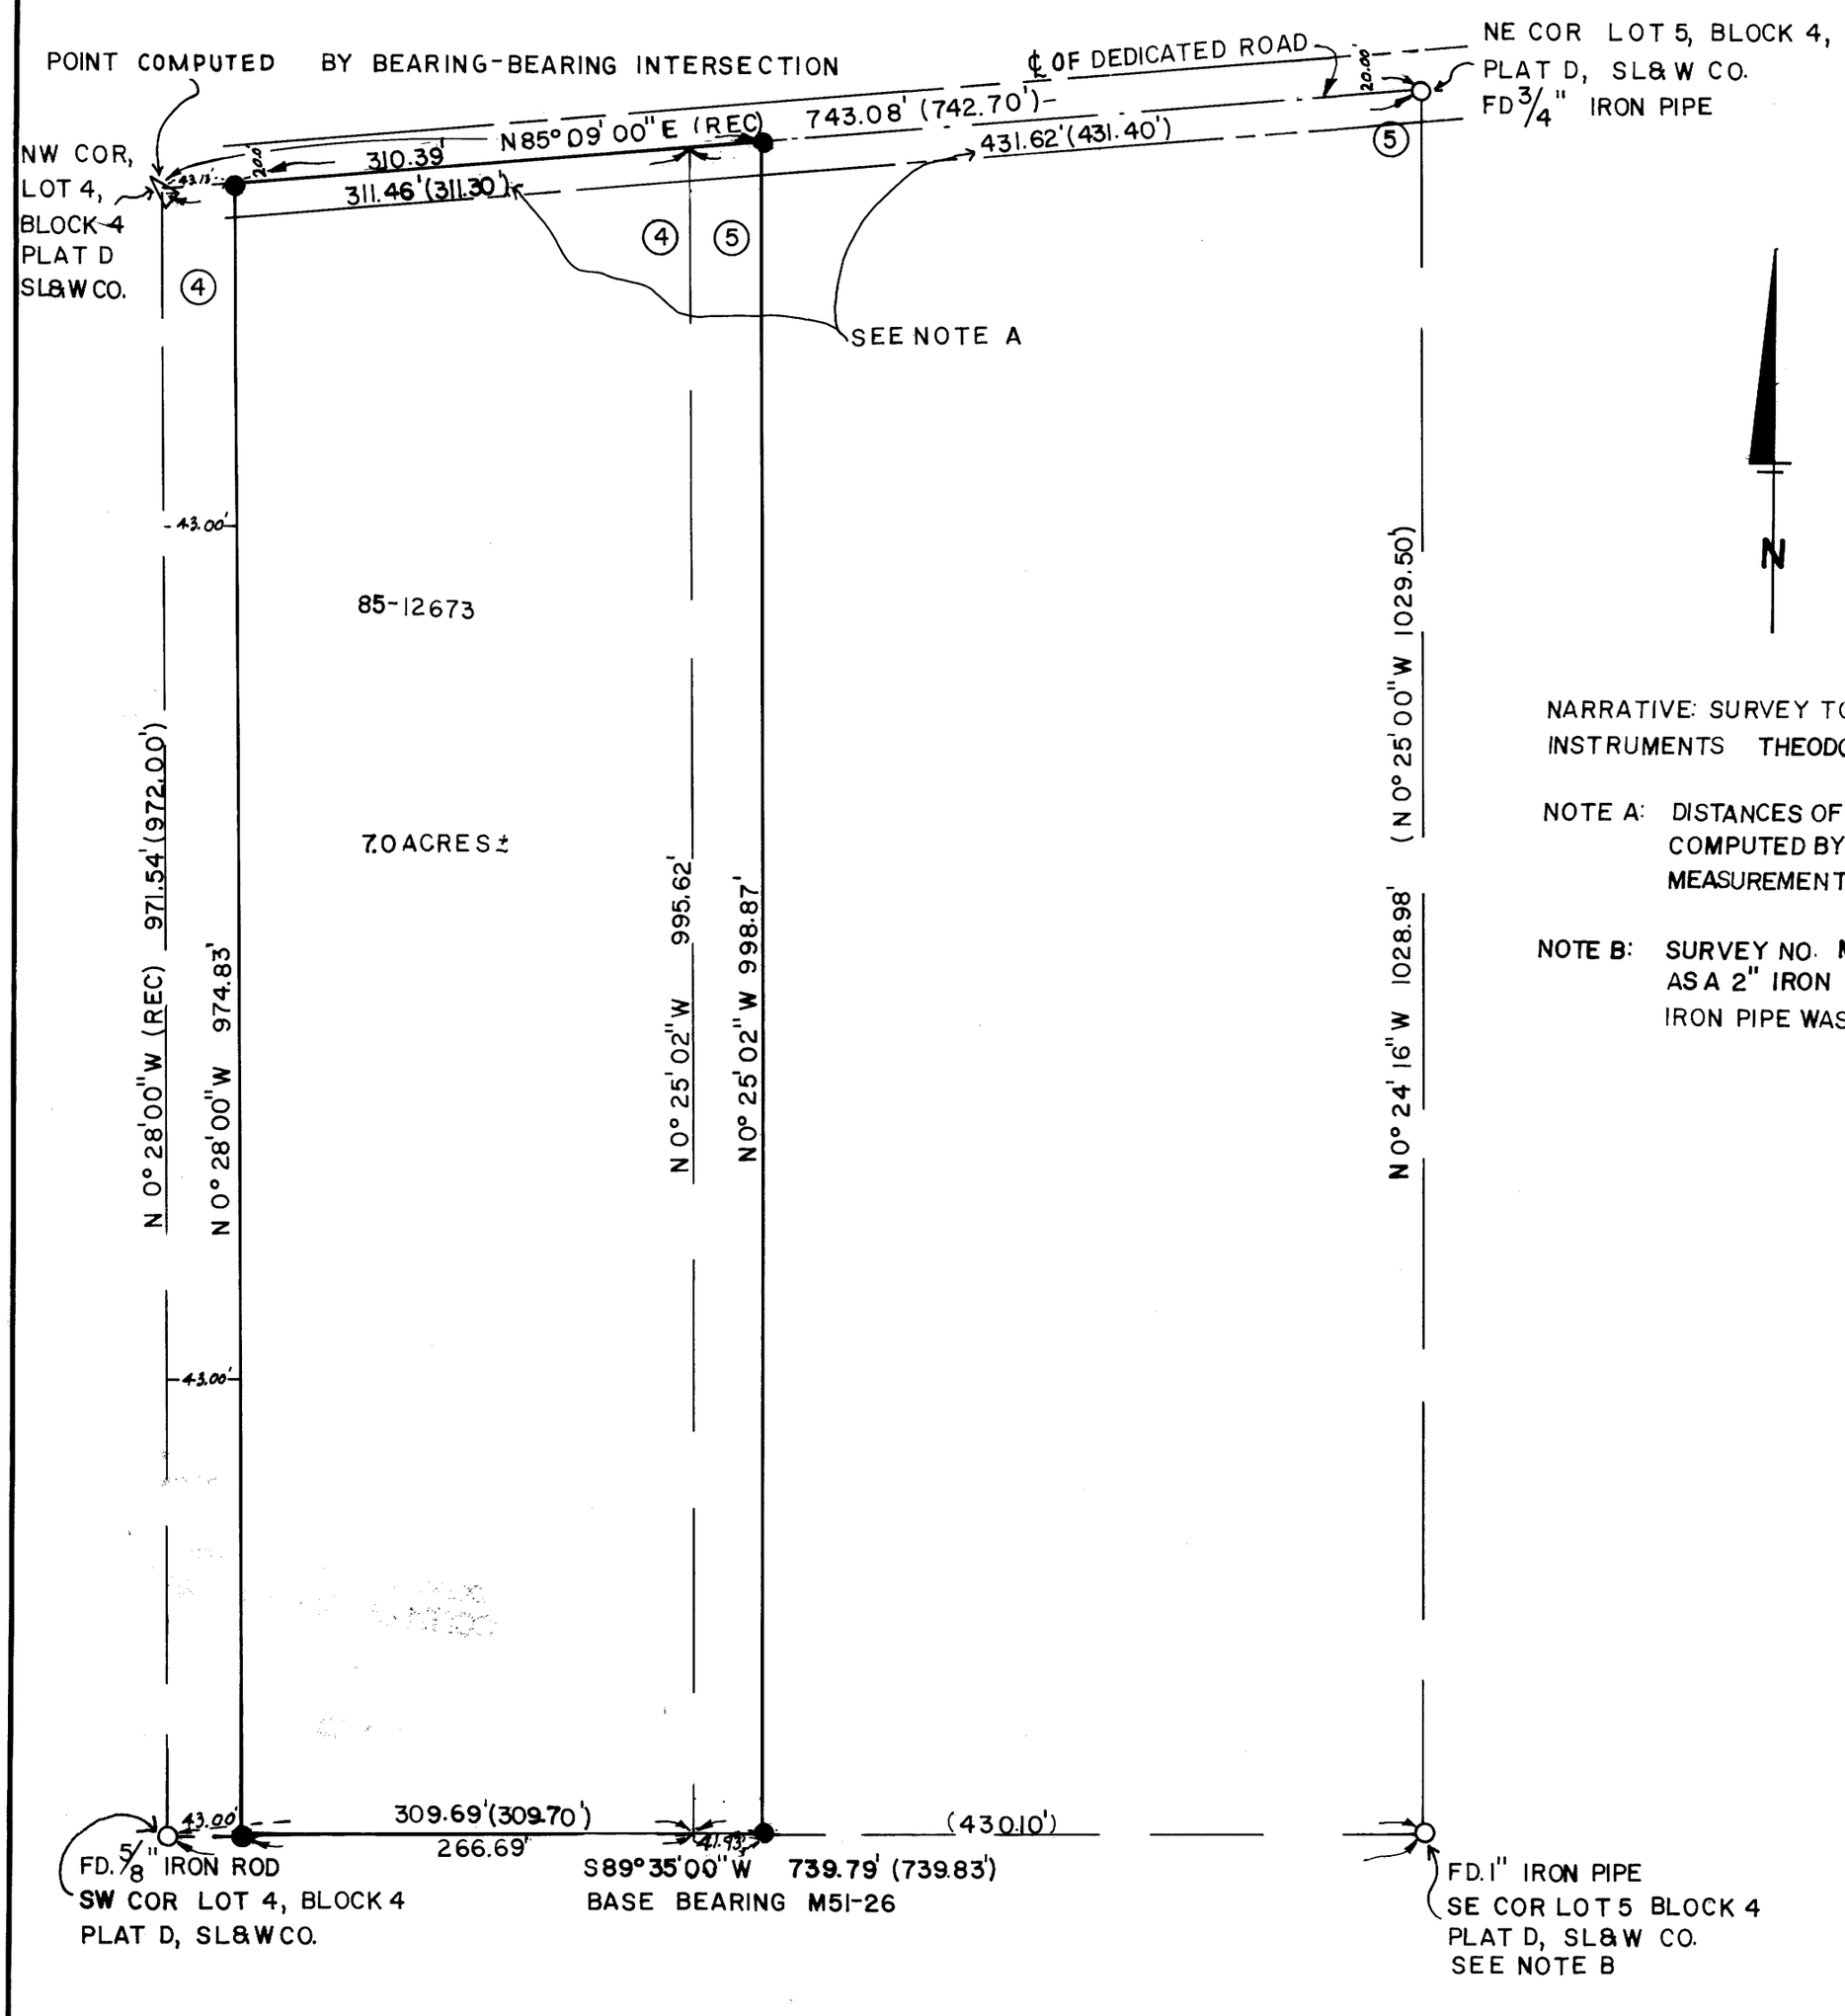

NARRATIVE: SURVEY TO MONUMENT PROPERTY CORNERS
INSTRUMENTS THEODOLITE, DISTANCE METER

NOTE A: DISTANCES OF NORTH LINE OF LOT 4 AND 5 COMPUTED BY SINGLE PROPORTIONATE MEASUREMENT

NOTE B: SURVEY NO. M51-26 REFERS TO THIS CORNER AS A 2" IRON PIPE, NO EVIDENCE OF A 2" IRON PIPE WAS FOUND

REGISTERED PROFESSIONAL LAND SURVEYOR
Robert L. Dolan
OREGON
JULY 30, 1976
ROBERT L. DOLAN
1076

MAP FILE M99-72