COUNTY SURVEYORS FILE DATA
DO NOT REMOVE FROM OFFICE

PORTION OF LOTS 4 & 9, SECTION 19, T 21 S, R 11 W, W.M.
PORTION OF LOTS 3, 4, 5 & N1/2 SE1/4, SECTION 24, T 21 S, R 12 W

NOVEMBER 1985 SCALE: 1" = 300'

FILED
RECEIVED CMO
NOV 29 1985
COUNTY SURVEYOR
DOUGLAS COUNTY, ORE.

MAP FILE M99 - 78 B

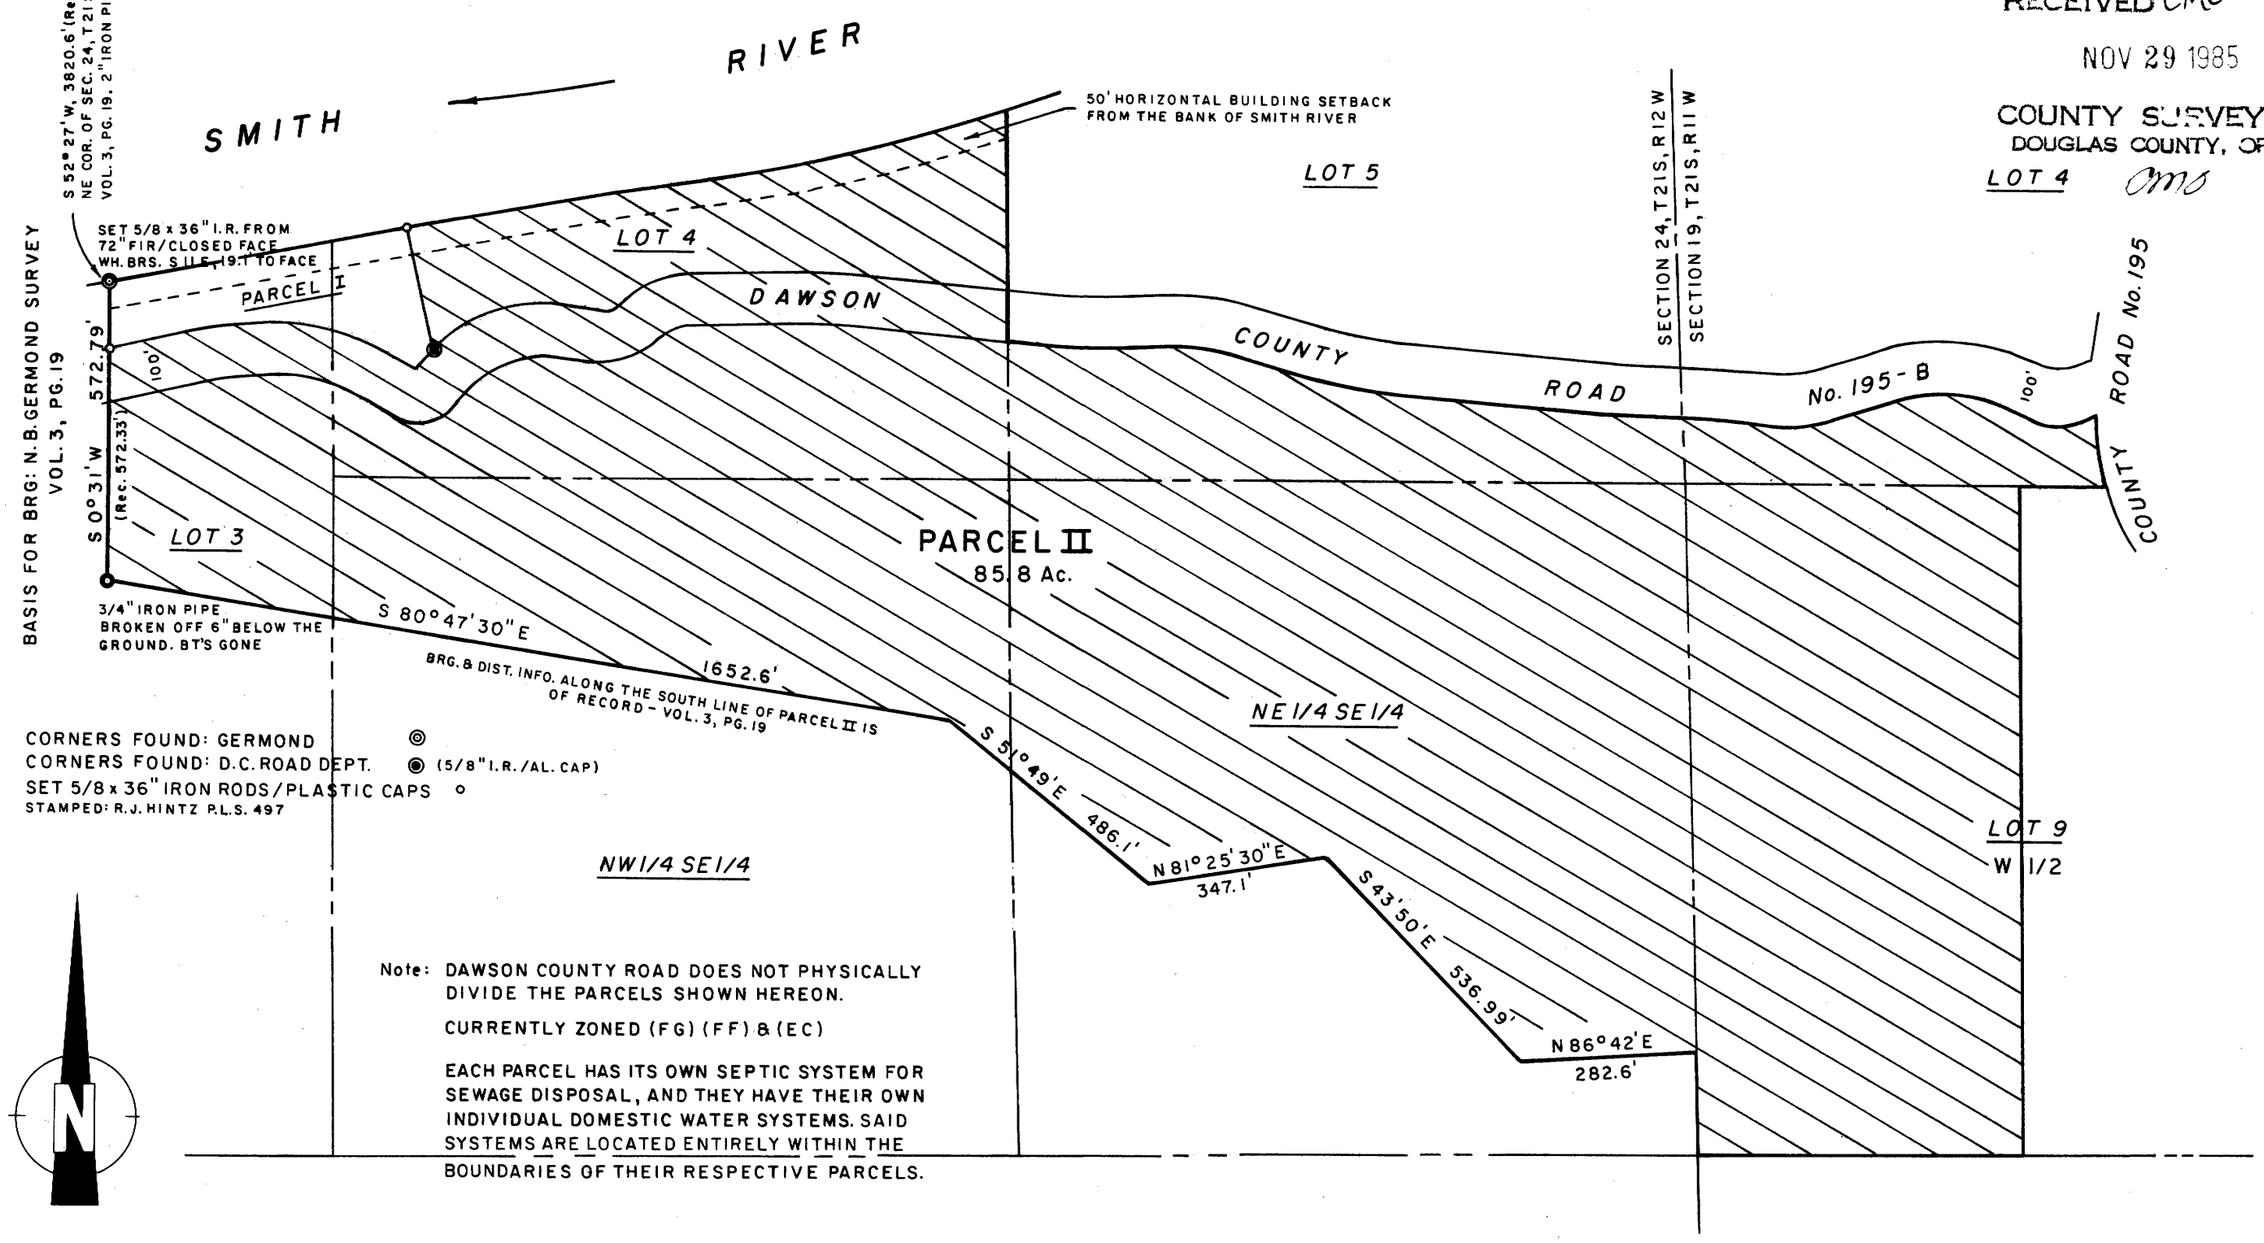

CORNERS FOUND: GERMOND ◎
CORNERS FOUND: D.C. ROAD DEPT. ◉ (5/8" I.R./AL. CAP)
SET 5/8 x 36" IRON RODS/PLASTIC CAPS ○
STAMPED: R.J. HINTZ P.L.S. 497

Note: DAWSON COUNTY ROAD DOES NOT PHYSICALLY DIVIDE THE PARCELS SHOWN HEREON.

CURRENTLY ZONED (FG) (FF) & (EC)

EACH PARCEL HAS ITS OWN SEPTIC SYSTEM FOR SEWAGE DISPOSAL, AND THEY HAVE THEIR OWN INDIVIDUAL DOMESTIC WATER SYSTEMS. SAID SYSTEMS ARE LOCATED ENTIRELY WITHIN THE BOUNDARIES OF THEIR RESPECTIVE PARCELS.

FOUND 5/8" IRON RODS/ALUMINUM CAPS STAMPED "DOUGLAS CO. RD. DEPT. R/W" (UNRECORDED) ◉

SET 5/8 x 36" IRON RODS/PLASTIC CAPS STAMPED "R.J. HINTZ P.L.S. 497" ○

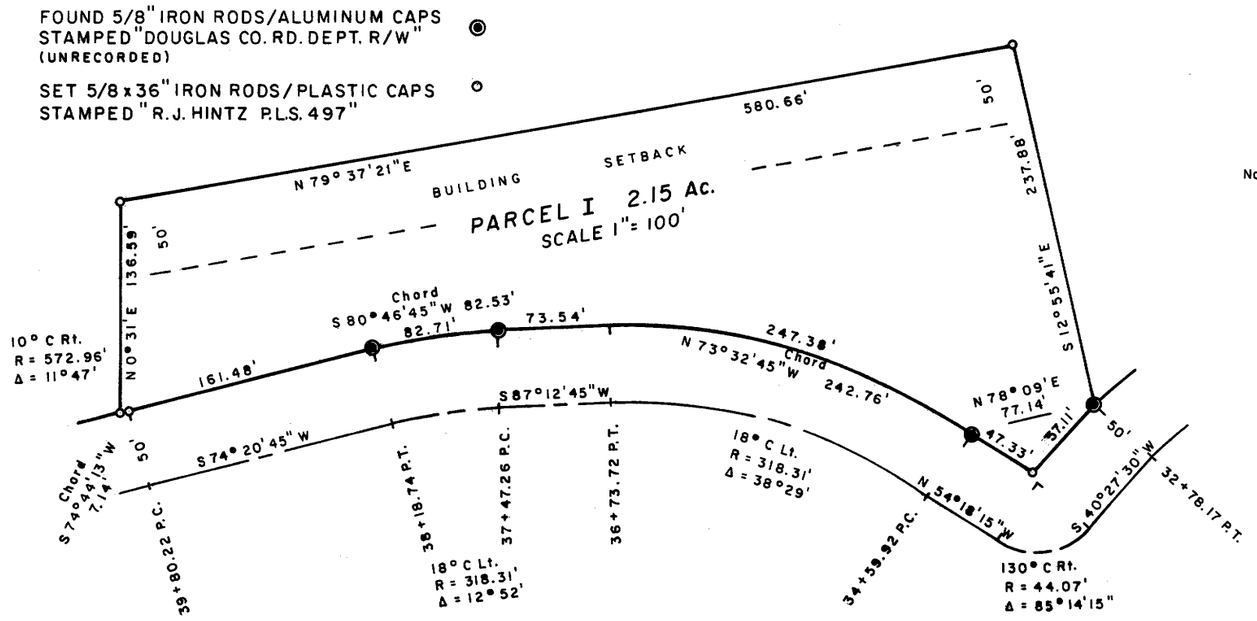

Note: CURVE INFORMATION REFERS TO CENTERLINE. SURVEY FURNISHED BY D.C. ENGINEER DEPARTMENT.

36 + 73.72 P.T. WAS GONE, AND COULD NOT BE RESET AS THE POINT FALLS ON A VERTICAL CUT.

REGISTERED PROFESSIONAL LAND SURVEYOR

Richard J. Hintz

OREGON
MAY 13, 1960
RICHARD J. HINTZ
497

MAP FILE M99 - 78B