COUNTY SURVEYORS FILE DATA
DO NOT REMOVE FROM OFFICE

FILED
JAN 28 1986
COUNTY SURVEYOR
DOUGLAS COUNTY, ORE.
CMO

SURVEY OF PARCEL FOR ADDITION TO VETERAN OF FOREIGN WARS, WINSTON, ORE., IN S.W. 1/4, SEC. 21. T.28S., R.6 W., W.M., DOUGLAS CO., ORE.

DEC. '85 1" = 40'

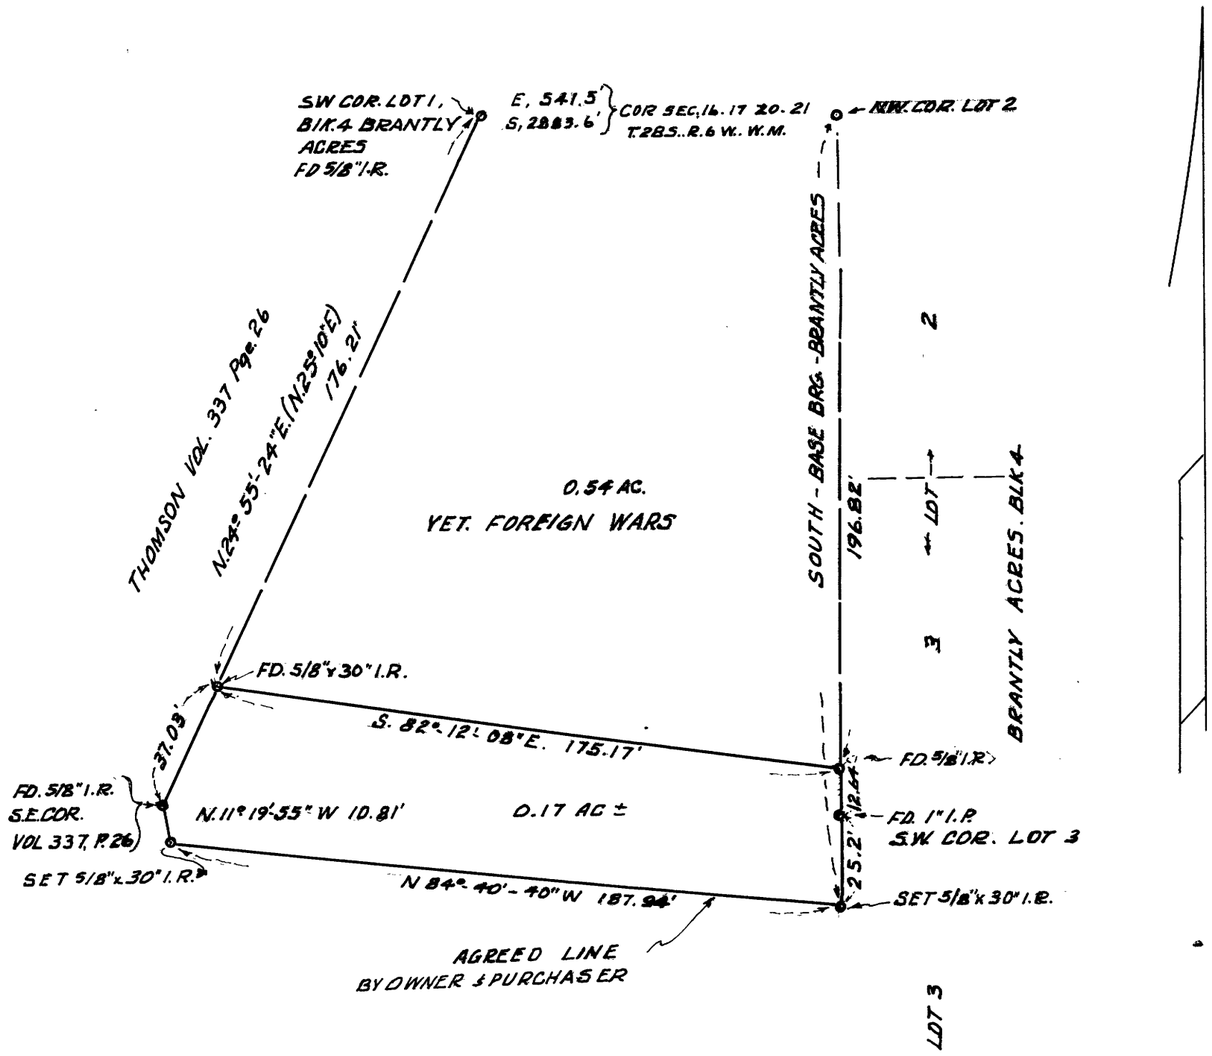

BASE BRG - BRANTLY ACRES
o FD MONUMENTS AS INDICATED
o SET 5/8" x 30" I.R. MKD LS750

SURVEY FOR
ARTHUR E. MILLER
WINSTON, ORE.
BY
HERBERT L. NORTHCRAFT
3520 OLALLA RD.,
WINSTON. ORE.

REGISTERED PROFESSIONAL LAND SURVEYOR
Herbert L. Northcraft
OREGON
JULY 8, 1986
HERBERT L. NORTHCRAFT
750

MAP FILE N100-23