MAP FILE M100-42

COUNTY SURVEYORS FILE DATA
DO NOT REMOVE FROM OFFICE

# A SURVEY FOR DAVID WITT IN SW¼ SECTION 1, & SE¼ OF SECTION 2, TOWNSHIP 28 SOUTH, RANGE 6 WEST, W. M., ALSO IN LOTS 6 & 11 BOGGS ORCHARD TRACTS.

SURVEYED BY: DONALD A. BENTZ
P.O. BOX 901
WINCHESTER, OR.
97495

FILED
MAR 18 1986
COUNTY SURVEYOR
DOUGLAS COUNTY, ORE.
CMO

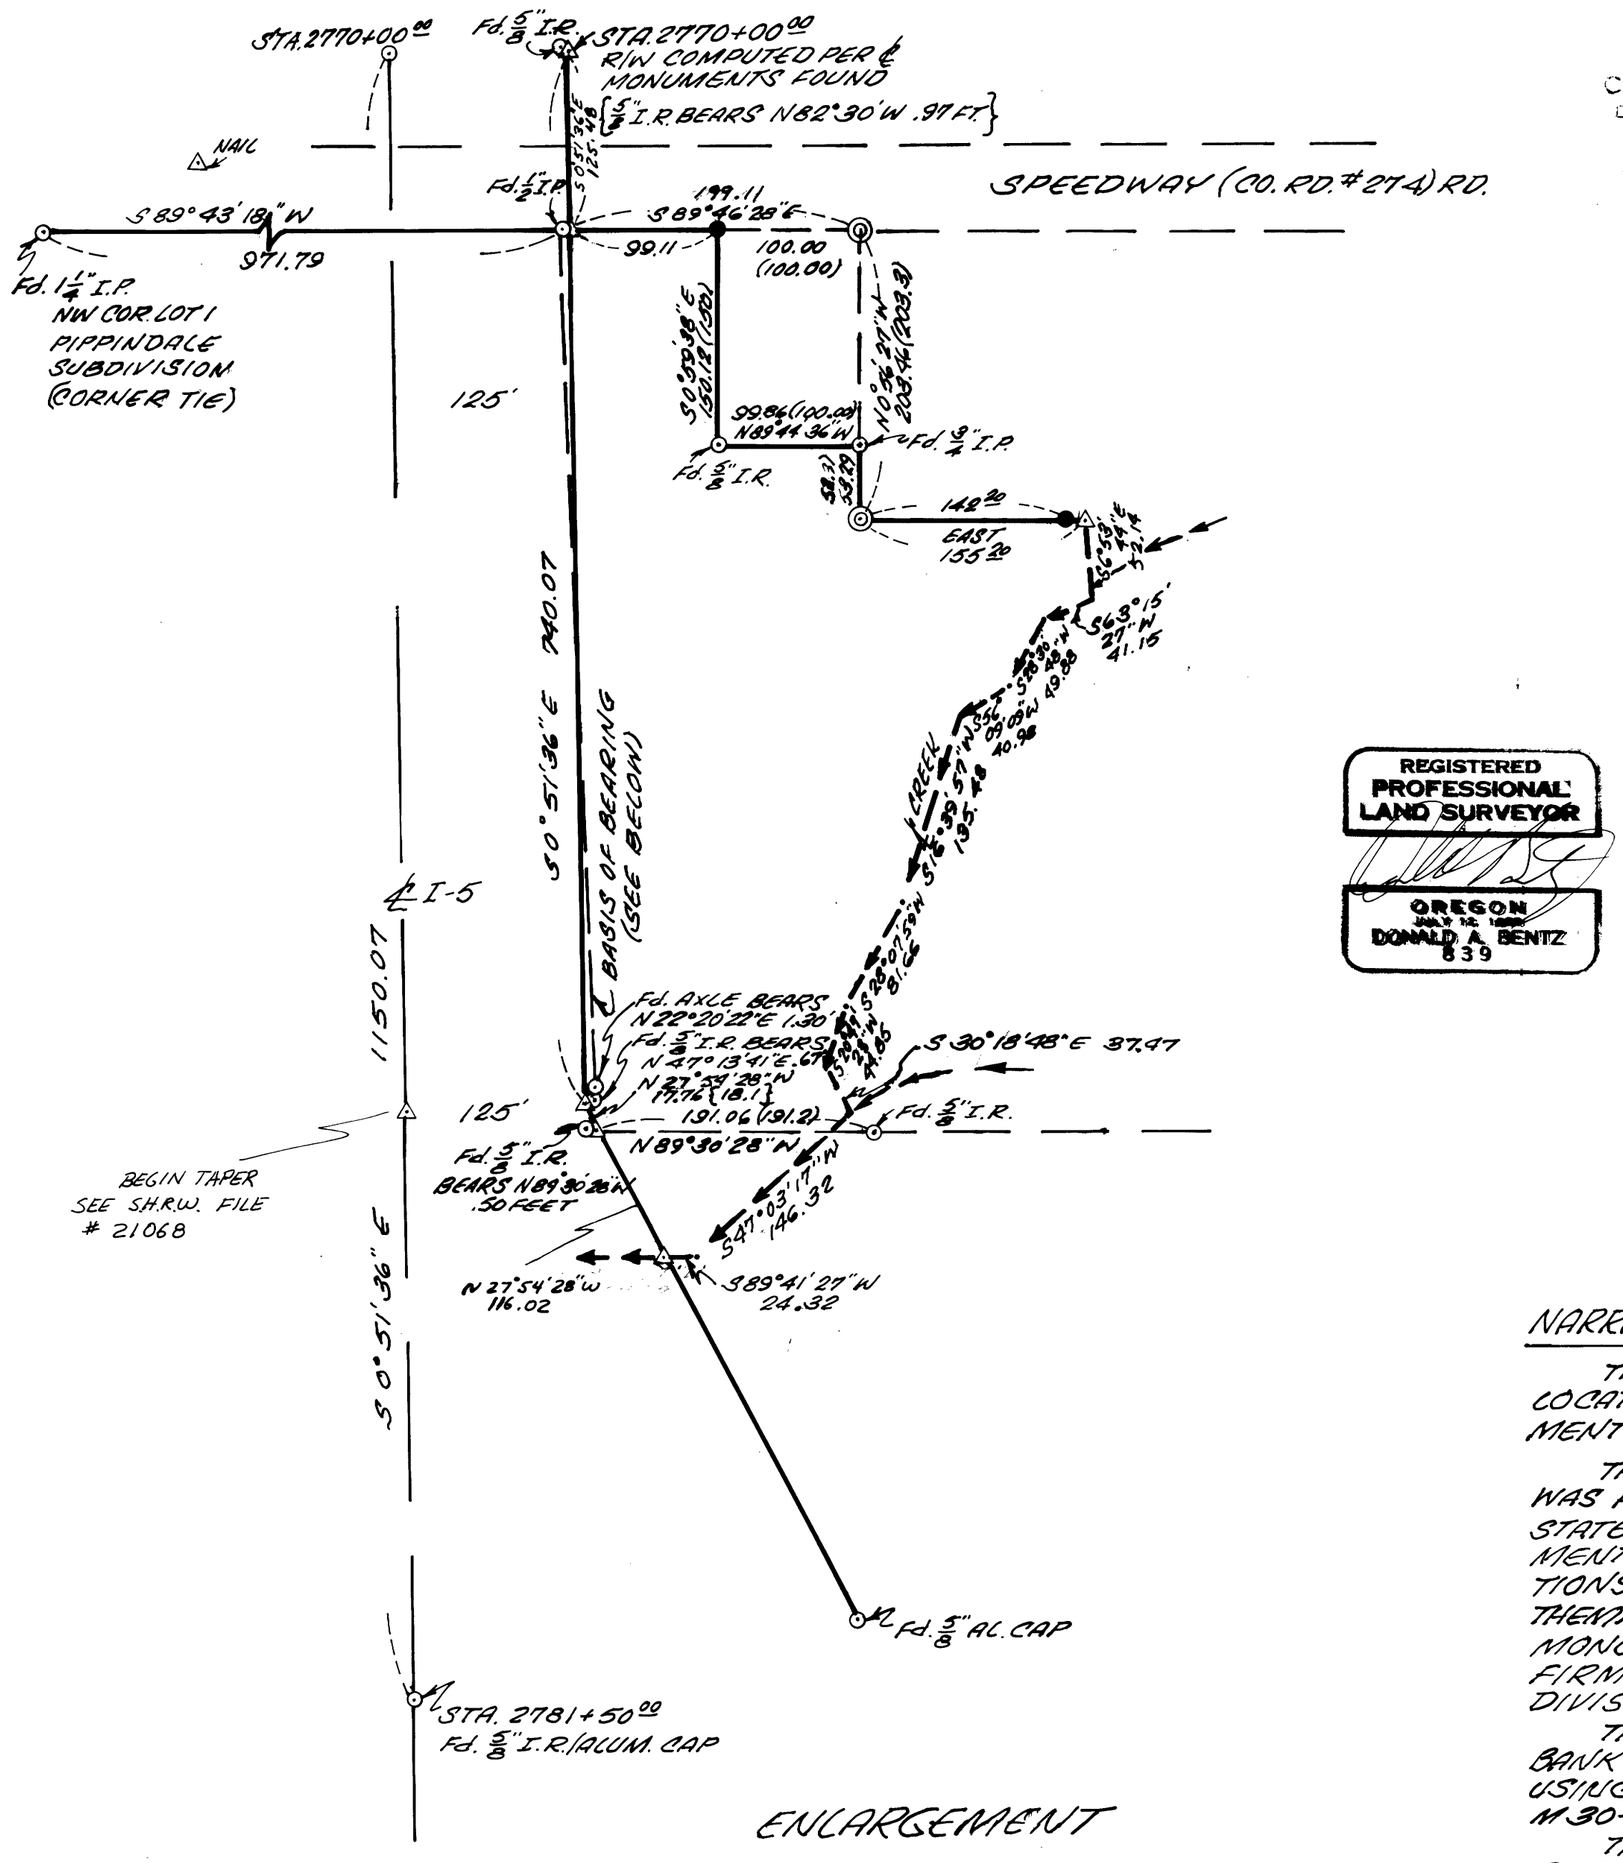


N

SCALE: 1" = 100'
MARCH, 1986

REGISTERED
PROFESSIONAL
LAND SURVEYOR
OREGON
JAN. 7 1972
DONALD A. BENTZ
839

## LEGEND

- ⊙ FOUND AS NOTED
- ● SET 5/8" x 30" I.R./PLASTIC CAP MKD. "BENTZ SURVEY, INC."
- ◎ FOUND AXLE/FLANGE
- △ COMPUTED POINT
- ( ) REC. PER M30-10
- { } REC. PER M43-37

## NARRATIVE:

THE PURPOSE OF THIS SURVEY IS TO LOCATE INST. #75-13661 AND SET MONUMENTS AS SHOWN HEREON.

THE INTERSTATE 5 RIGHT-OF-WAY WAS POSITIONED USING TWO FOUND STATE HIGHWAY CENTERLINE MONUMENTS (BEING APPARENT EVEN STATIONS DUE TO THE DISTANCE BETWEEN THEM). THE STATIONING OF THESE TWO MONUMENTS COULD NOT BE CONFIRMED BY ANYONE IN THE HIGHWAY DIVISION.

THE MONUMENT SET ON THE HIGH BANK OF THE CREEK WAS POSITIONED USING A RECORD EAST BEARING PER M30-10.

THE OTHER SET MONUMENT WAS POSITIONED ON THE NORTH-SOUTH LOT LINE BETWEEN THE SUBJECT PROPERTY AND THE PROPERTY TO THE EAST (GIVING PROPERTY TO THE EAST THEIR RECORD 100.00 FT.)

NOTE: ACTUAL COUNTY R/W NOT ESTABLISHED PER THIS SURVEY.

FIELD CREW: JIM ARTMAN, GREG LANG
EQUIPMENT: WILD T1 & RED1 DISTANCE-METER.
DRAFTING: DON STULL
COMPUTATIONS: GREG LANG

MAP FILE M100-42