SURVEYORS FILE DATA
DO NOT REMOVE FROM OFFICE

MAP FILE M100-69B

# EXHIBIT "A"

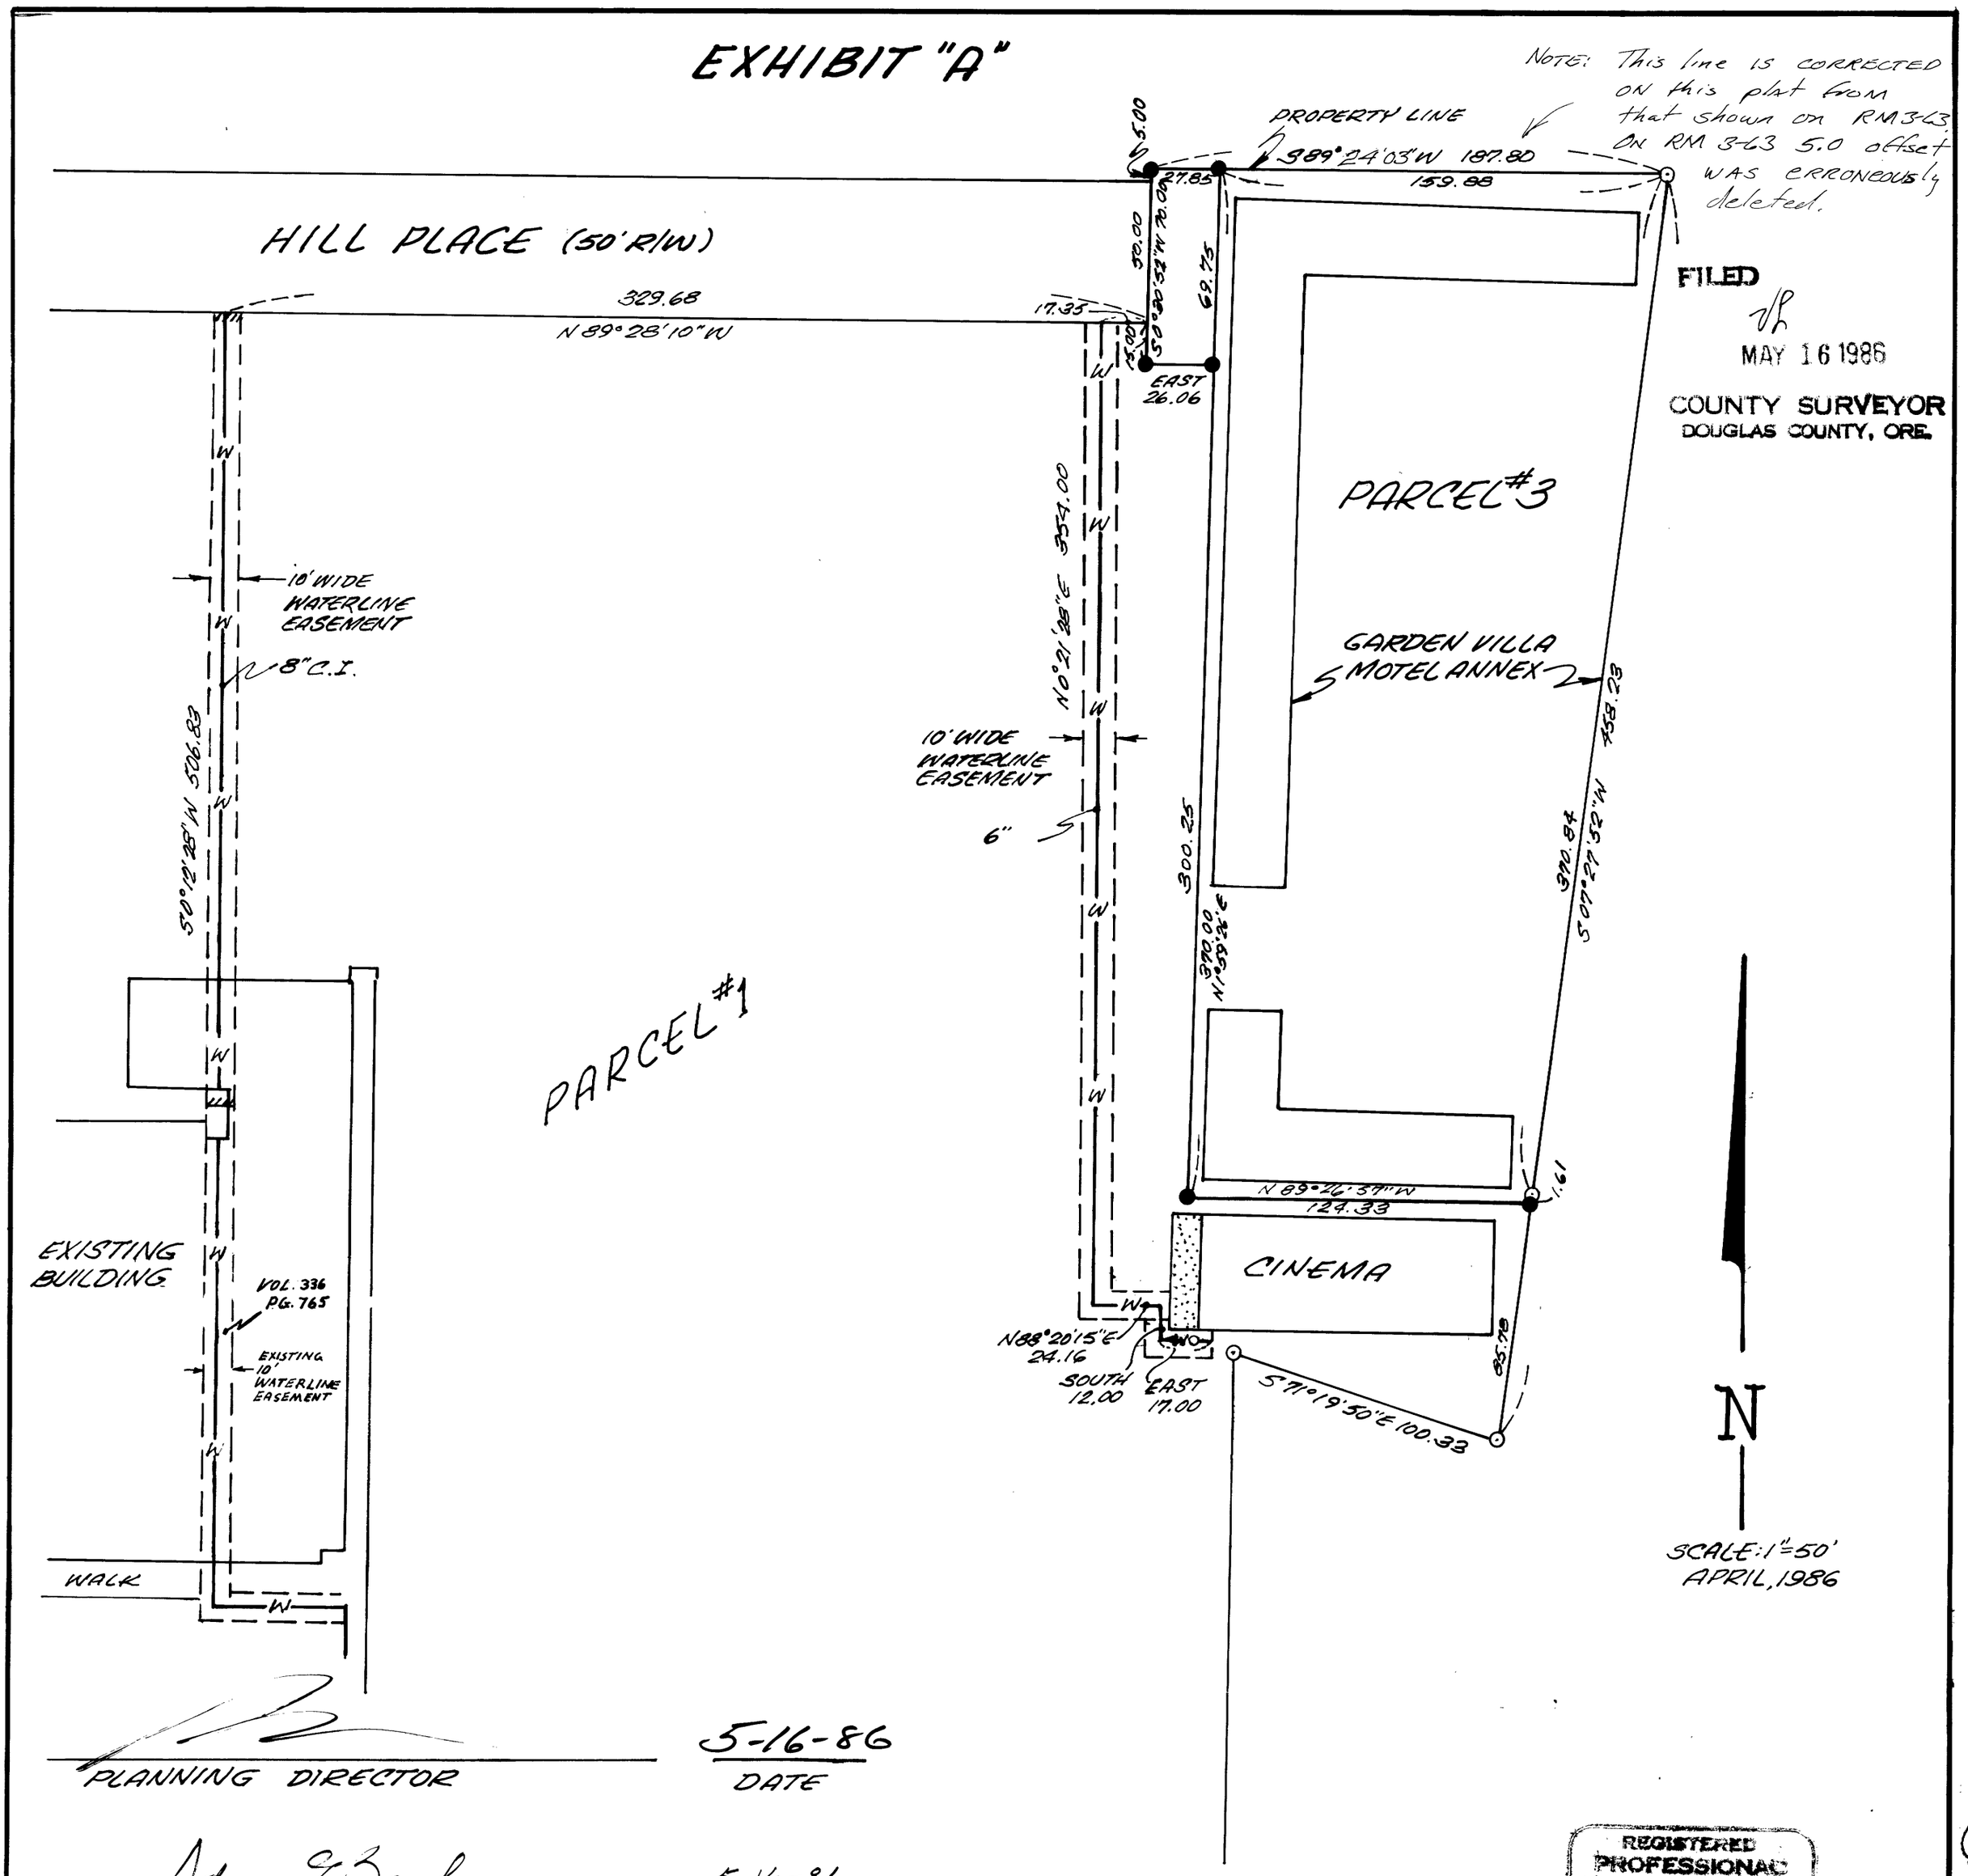


FILED
MAY 16 1986
COUNTY SURVEYOR
DOUGLAS COUNTY, ORE.

REGISTERED PROFESSIONAL LAND SURVEYOR
OREGON
DONALD A. BENTZ
839

PLANNING DIRECTOR — 5-16-86 DATE

Adney E. Bowker
DIRECTOR OF PUBLIC WORKS — 5-16-86 DATE

Francis L. Ingram
COUNTY SURVEYOR — 5-16-86 DATE

BK 9-18 80B



M100-69B