M101-10

COUNTY SURVEYORS FILE DATA
DO NOT REMOVE FROM OFFICE

FILED TF
OCT 6 1986 TF
COUNTY SURVEYOR
DOUGLAS COUNTY, ORE. TF

PROPERTY LINE SURVEY

in the N.E. 1/4, SECTION 31, TOWNSHIP 30 SOUTH, RANGE 5 WEST, WILLAMETTE MERIDIAN, DOUGLAS COUNTY, OREGON.

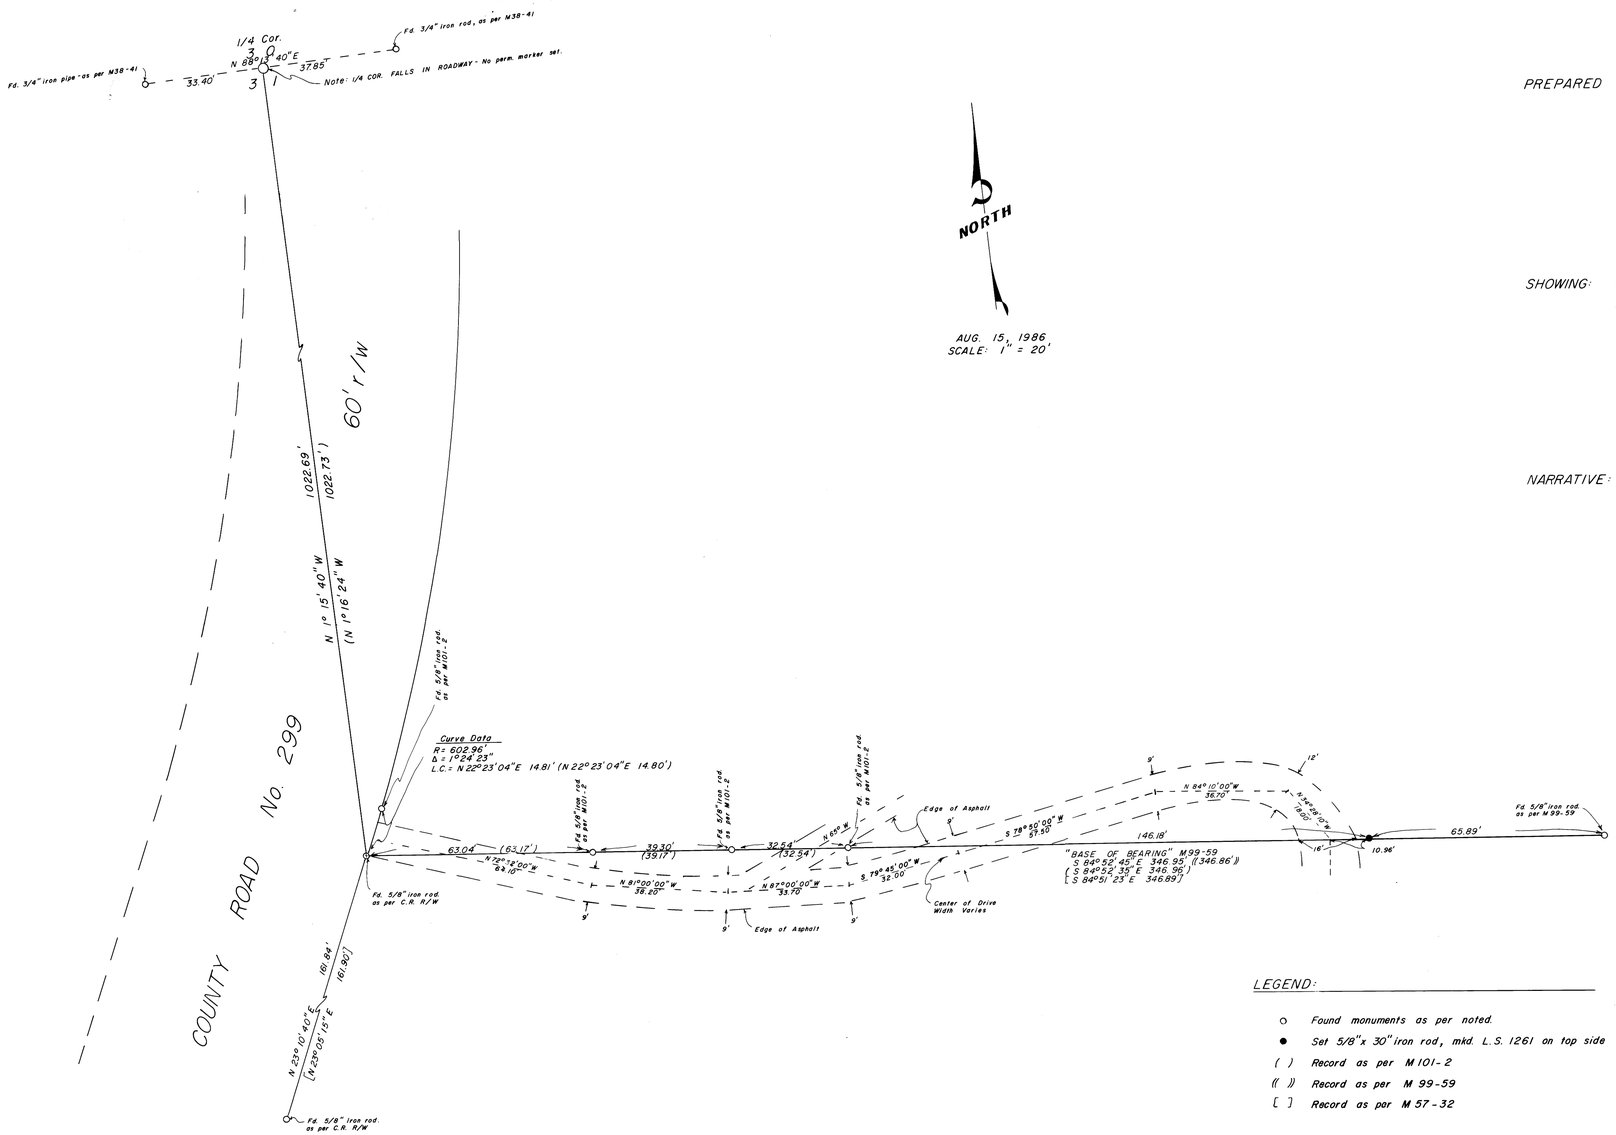

NORTH

AUG. 15, 1986
SCALE: 1" = 20'

PREPARED FOR: RICHARD and VIRGINIA MAHANEY
RT. 1 BOX 119-0
RIDDLE, OREGON. 97469

SHOWING: EXISTING ASPHALT DRIVE ALONG THE PROPERTY LINE COMMON TO PARCEL 1 and 2, MINOR LAND PARTITION. SEE M 57-32

NARRATIVE: Purpose of the survey was to show the location of the existing driveway that is located along the property line common to Parcel 1 & 2 of M57-32. Field research located said found corners as shown. The south side of Parcel 2 was used as "Base of Bearing" SEE M99-59. Said set 5/8" iron rod was set on property line as per request of property owner.

LEGEND:

- ○ Found monuments as per noted.
- ● Set 5/8"x 30" iron rod, mkd. L.S. 1261 on top side
- ( ) Record as per M 101-2
- (( )) Record as per M 99-59
- [ ] Record as per M 57-32

JOHN H. MARKHAM JR.
P. O. BOX 802
MYRTLE CREEK, OREG.
ph. 863-4590

DRAWN BY
RAYMOND F. BROWN
P. O. BOX 539
CANYONVILLE, OREG.
ph. 839-6185

REGISTERED PROFESSIONAL LAND SURVEYOR
OREGON
JULY 23, 1971
JOHN H. MARKHAM, JR.
1261

SURVEY FILE M101-10