A SURVEY FOR JIM SIMLINESS IN WOLLENBERG'S ADDITION TO THE CITY OF ROSEBURG IN THE SW¼ OF SECTION 19, T27S, R5W, W.M.

FILED
NOV 20 1986
COUNTY SURVEYOR
DOUGLAS COUNTY, ORE.

M162-73

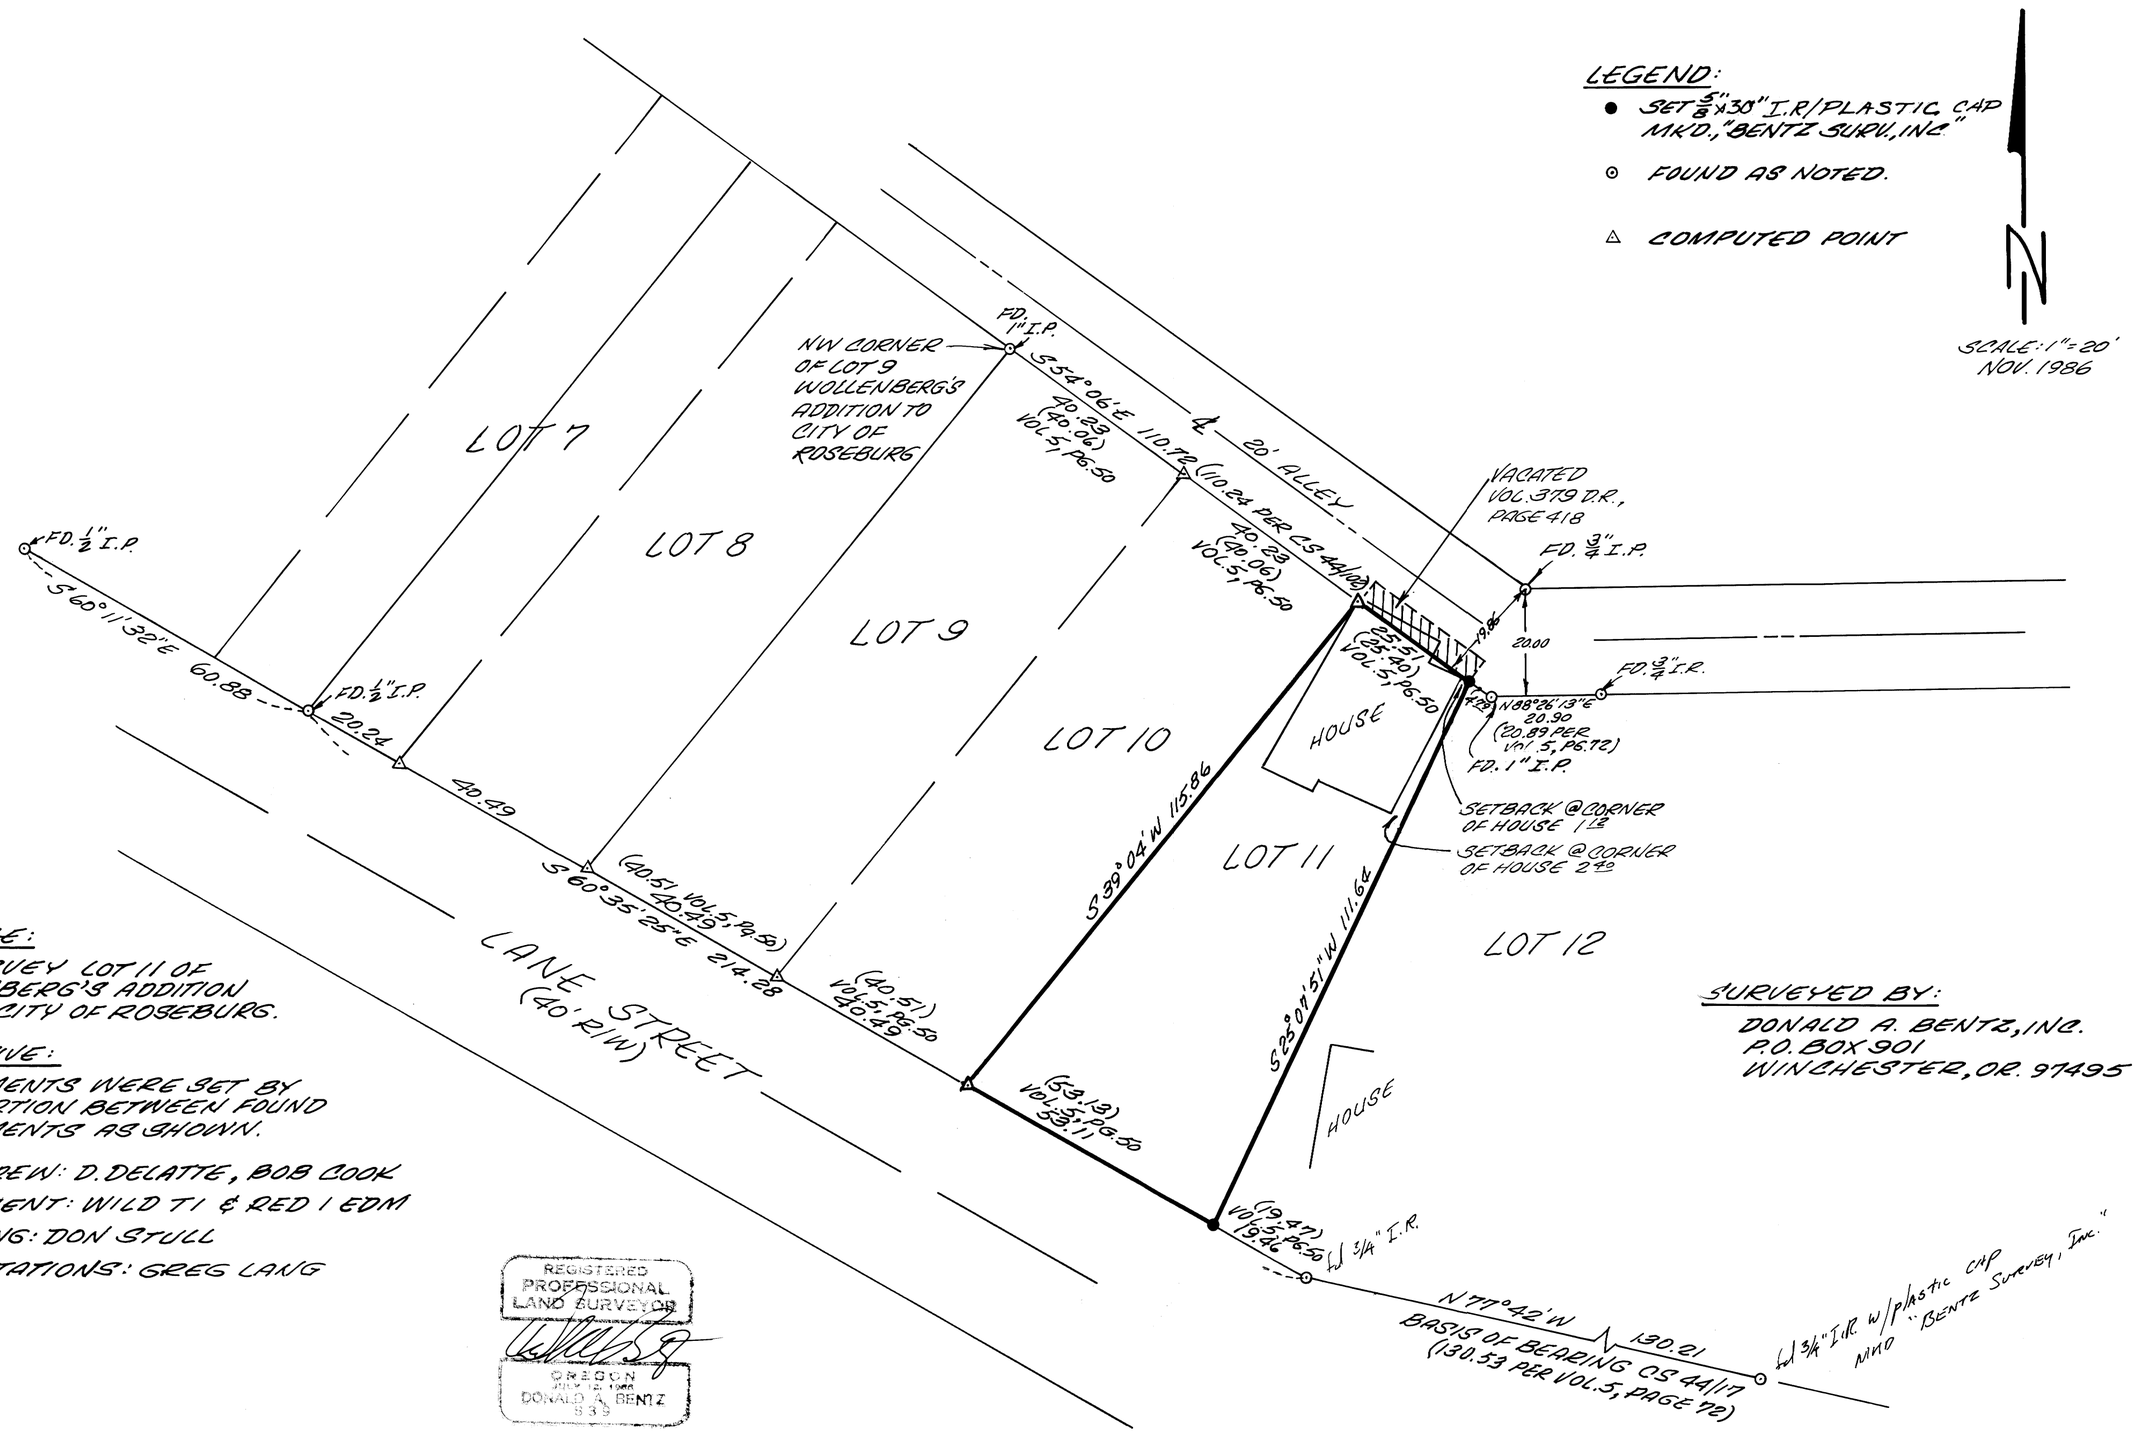

PURPOSE:

TO SURVEY LOT 11 OF WOLLENBERG'S ADDITION TO THE CITY OF ROSEBURG.

NARRATIVE:

MONUMENTS WERE SET BY PROPORTION BETWEEN FOUND MONUMENTS AS SHOWN.

FIELD CREW: D. DELATTE, BOB COOK
EQUIPMENT: WILD T1 & RED 1 EDM
DRAFTING: DON STULL
COMPUTATIONS: GREG LANG

REGISTERED PROFESSIONAL LAND SURVEYOR
OREGON
JULY 12, 1966
DONALD A. BENTZ
838

SURVEYED BY:

DONALD A. BENTZ, INC.
P.O. BOX 901
WINCHESTER, OR. 97495

M162-73