M103-40

COUNTY SURVEYORS FILE DATA
DO NOT REMOVE FROM OFFICE

FILED
FEB 19 1987
COUNTY SURVEYOR
DOUGLAS COUNTY, ORE.

PROPERTY LINE ADJUSTMENT

IN PORTIONS OF LOTS 21&22, UNION HEIGHTS HOMESITES
IN THE SE1/4 SEC. 8, T. 25 S., R. 5W.W.M., DOUGLAS COUNTY, OR

JANUARY 1987

SCALE : 1" = 40'

FOR: A.F. GOSSET

BY: AA SURVEYING SERVICE, INC.
2566 N.E. STEPHENS ST.
ROSEBURG, OREGON 97470
TEL.(503) 672-2096

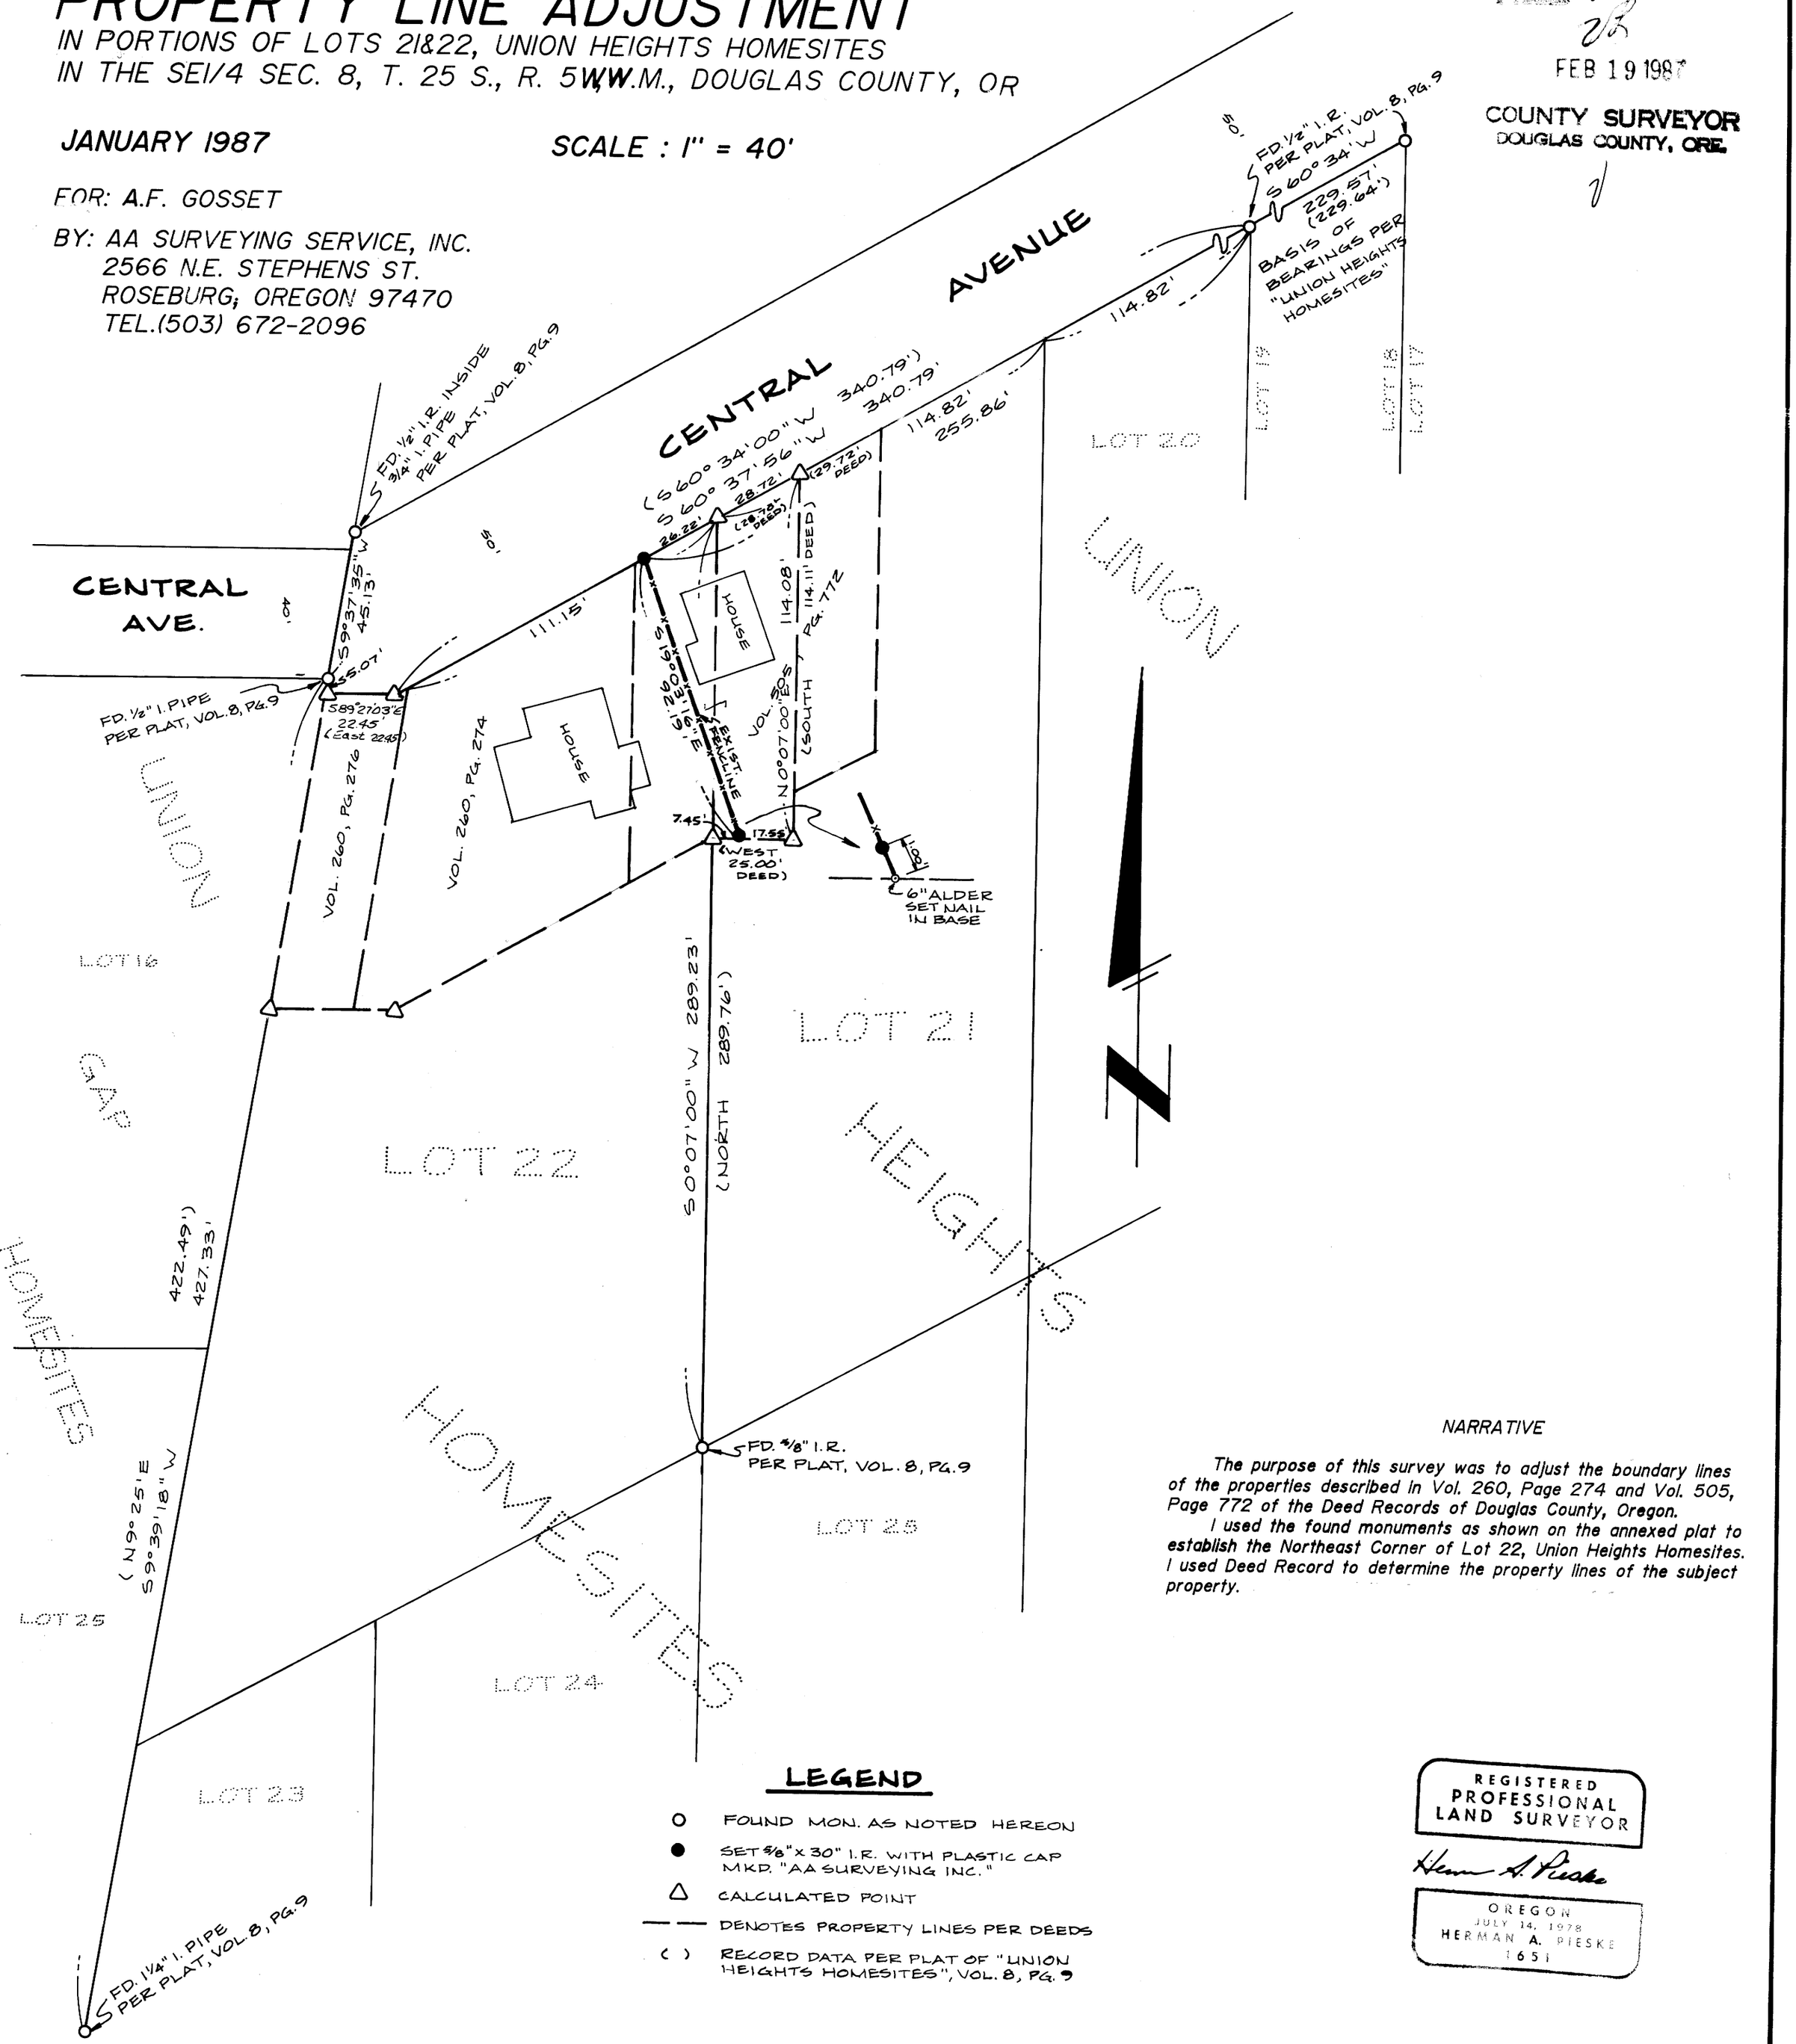

LEGEND

- O FOUND MON. AS NOTED HEREON
- ● SET 5/8" x 30" I.R. WITH PLASTIC CAP MKD. "AA SURVEYING INC."
- △ CALCULATED POINT
- — — DENOTES PROPERTY LINES PER DEEDS
- ( ) RECORD DATA PER PLAT OF "UNION HEIGHTS HOMESITES", VOL. 8, PG. 9

NARRATIVE

The purpose of this survey was to adjust the boundary lines of the properties described in Vol. 260, Page 274 and Vol. 505, Page 772 of the Deed Records of Douglas County, Oregon.

I used the found monuments as shown on the annexed plat to establish the Northeast Corner of Lot 22, Union Heights Homesites. I used Deed Record to determine the property lines of the subject property.

REGISTERED PROFESSIONAL LAND SURVEYOR
Herman A. Pieske
OREGON
JULY 14, 1978
HERMAN A. PIESKE
1651

682-86

MAP FILE M103-40