B-288

COUNTY SURVEYORS FILE DATA
DO NOT REMOVE FROM OFFICE

FILED
FEB 20 1987
COUNTY SURVEYOR
DOUGLAS COUNTY, ORE.

SURVEY NARRATIVE TO COMPLY WITH PARAGRAPH 209.250 OREGON REVISED STATUTES

MAP FILE M103-42

(SEE 1986 OSDF SURVEY OF SECTION 35, T.22S.,R.12W., DOUGLAS COUNTY SURVEYORS FILE NO. M100-38)

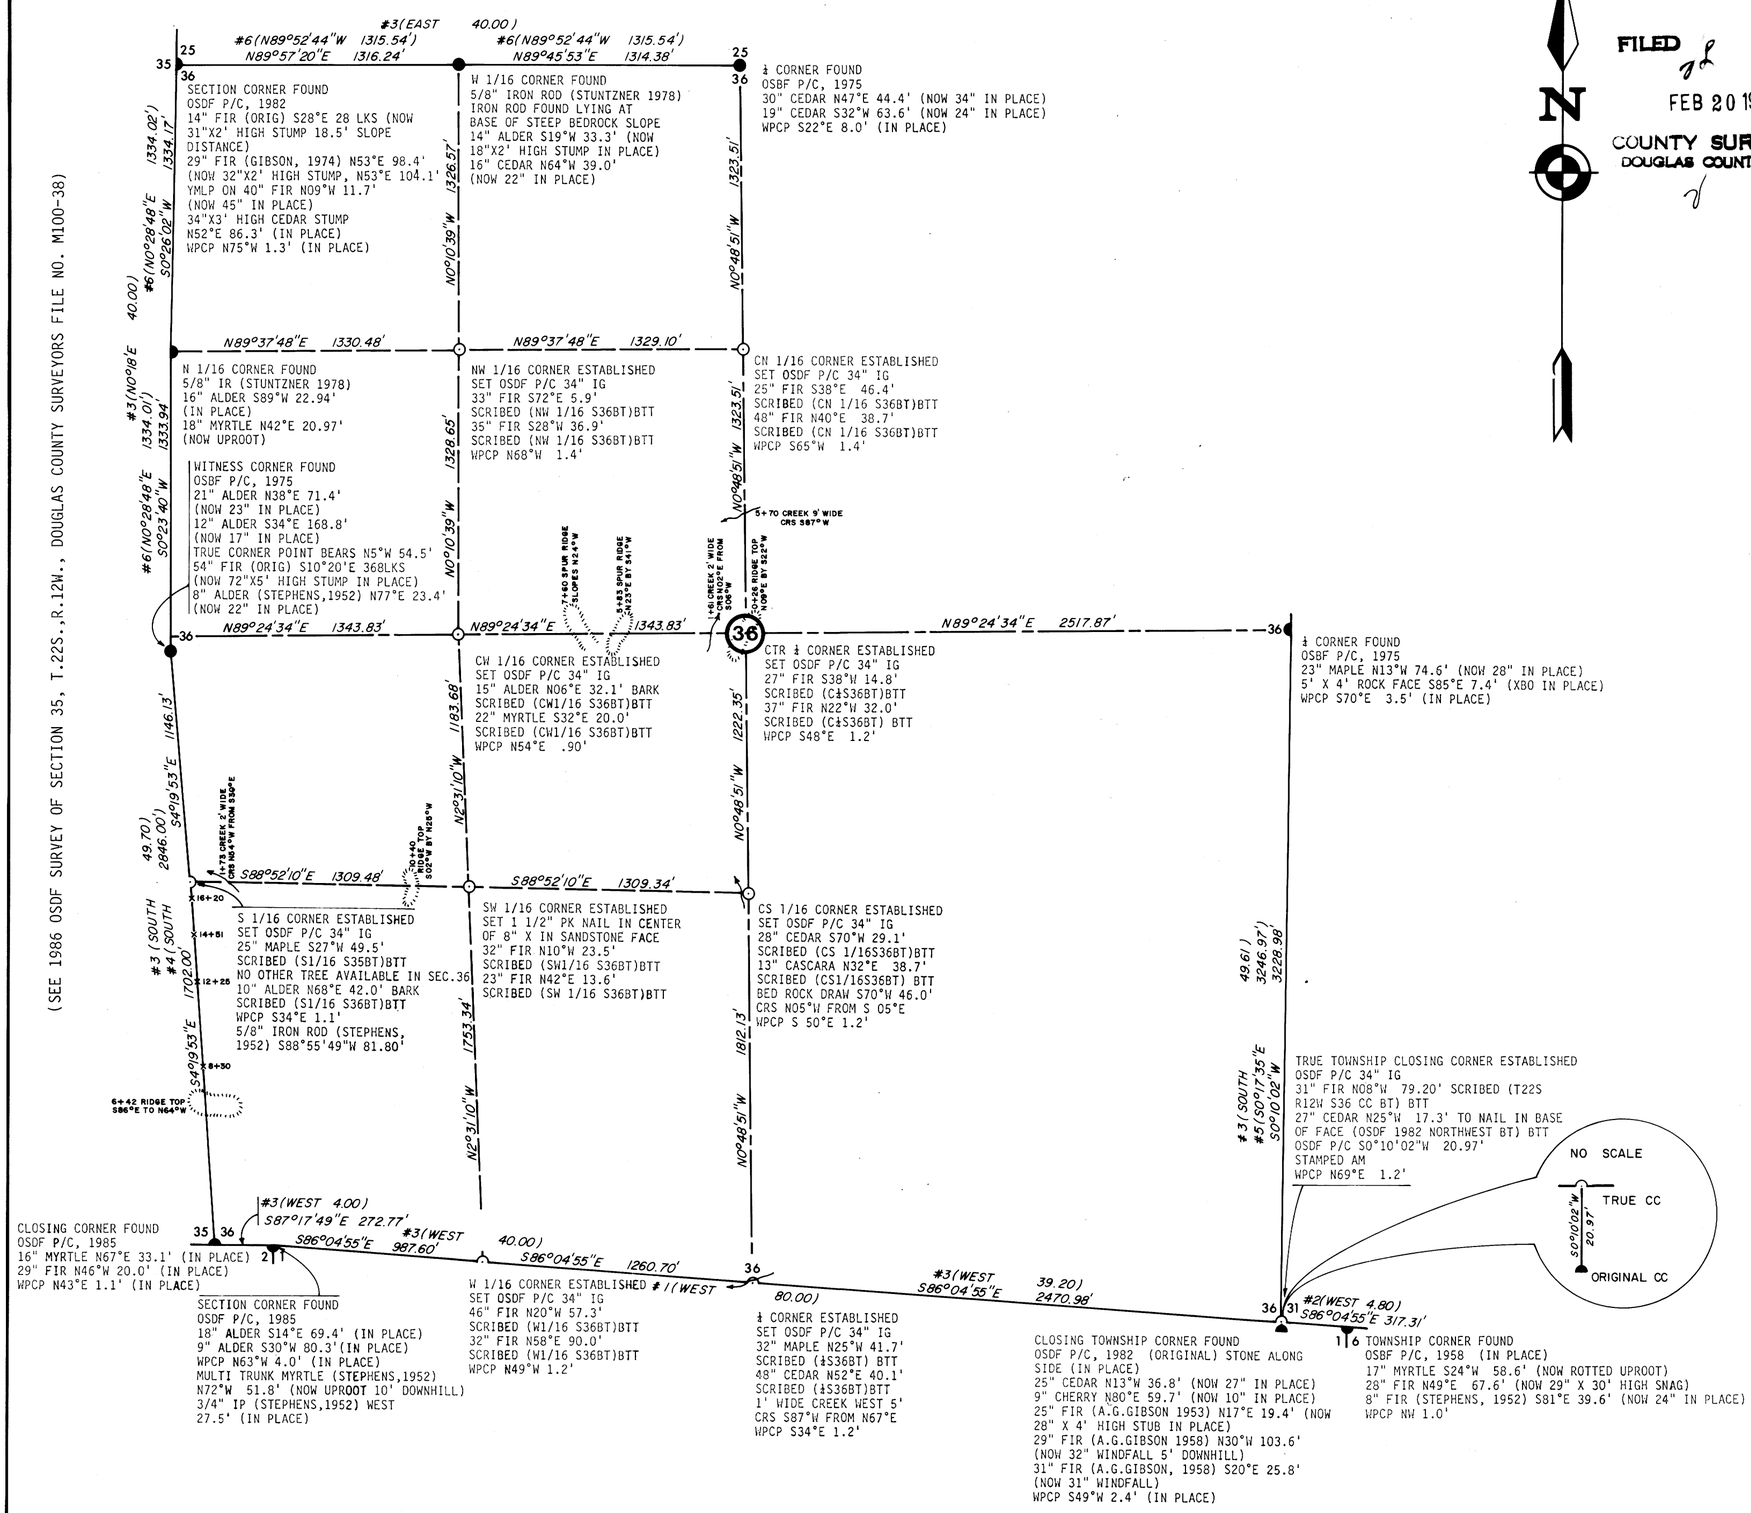

LEGEND

- OSBF P/C = OREGON STATE BOARD OF FORESTRY 1½" X 36 GALVANIZED IRON PIPE WITH 3" BRONZE CAP
- OSDF P/C = OREGON STATE DEPARTMENT OF FORESTRY 1 ½" X 36" ALUMINUM PIPE WITH 3 3/4" ALUMINUM CAP AND MAGNETIC INSERT
- ⊙ = MONUMENTS SET
- ● = MONUMENTS FOUND
- WPCP = 4"x4"X72" WHITE PAINTED CEDAR POST
- IG = IN GROUND
- BT = BEARING TREE
- BTT = BEARING TREE TAG
- IR = IRON ROD
- YMLP = YELLOW METAL LOCATION POSTER
- CRS = COURSE
- ← (TB &P) = TRUE BLAZED AND POSTED
- X = CARSONITE BOUNDARY MARKER AND STATION
- ESTABLISHED = NEW CORNERS SET
- #1 = RECORD BEARINGS AND DISTANCES IN CHAINS (WILLIAM P.WRIGHT, 1880, CONTRACT NO.341)
- #2 = RECORD BEARINGS AND DISTANCES IN CHAINS (WILLIAM R.WIPPLE, 1894, CONTRACT NO.612)
- #3 = RECORD BEARINGS AND DISTANCES IN CHAINS (CHARLES A.SLANG, 1910, CONTRACT NO.793)
- #4 = RECORD BEARINGS AND DISTANCES (CLIFFORD A.STEPHENS, 1952)
- #5 = RECORD BEARINGS AND DISTANCES (OREGON STATE BOARD OF FORESTRY 1975)
- #6 = RECORD BEARINGS AND DISTANCES (RONALD E.STUNTZNER, 1978)

PURPOSE

TO SEPARATE STATE FOREST LANDS AND PRIVATE LANDS LOCATED IN SECTION 36 TOWNSHIP 22 SOUTH, RANGE 12 WEST, WILLAMETTE MERIDIAN

PROCEDURE

A RANDOM TRAVERSE WAS USED TO CONNECT THE CONTROLLING CORNERS GOVERNING THE SUBDIVISION OF SECTION 36, TOWNSHIP 22 SOUTH, RANGE 12 WEST, WILLAMETTE MERIDIAN. THIS SECTION WAS SUBDIVIDED USING THE PROCEDURES AS OUTLINED IN THE "MANUAL OF INSTRUCTIONS FOR THE SURVEY OF THE PUBLIC LANDS OF THE U.S." BEARING TO ACCESSORIES FOR ESTABLISHED CORNERS WERE TAKEN WITH A HAND COMPASS SET AT 20°30' EAST MAGNETIC DECLINATION. NEW CORNERS AND ACCESSORIES MARKED ACCORDING TO "MANUAL OF INSTUCTION FOR THE SURVEY OF THE PUBLIC LANDS OF THE U.S". DISTANCES MEASURED TO BEARING TREE FACES. FOR DETAILED REPORT ON FOUND CORNERS SEE COUNTY RECORDS.

BASIS OF BEARING

SOLAR OBSERVATION, ALTITUDE METHOD

SURVEY FOR:
STATE OF OREGON - DEPARTMENT OF FORESTRY

SECTION 36, T.22S., R.12W., W.M.

DOUGLAS COUNTY, OREGON
THEODOLITE AND EDM SURVEY BY:
LLOYD D. SMITH, J. MC INTOSH
A. KOREIVA, T. VAN VLEET
DRAWN BY: T. VAN VLEET
DECEMBER 30, 1986
SCALE: 1"= 500'

SURVEY BY:

REGISTERED PROFESSIONAL LAND SURVEYOR
Lloyd D. Smith
OREGON
JULY 22, 1977
LLOYD D. SMITH
1101

LLOYD D. SMITH
300 5TH ST. BAY PARK
COOS BAY, OREGON

B-288
OSFD 1/23/87

MAP FILE M103-42