COUNTY SURVEYORS FILE DATA
DO NOT REMOVE FROM OFFICE

SURVEY FOR MYRL BARKHURST
IN THE NE¼ SEC. 7, T29S, R4W, W.M.

FILED
APR 13 1987
COUNTY SURVEYOR
DOUGLAS COUNTY, ORE.

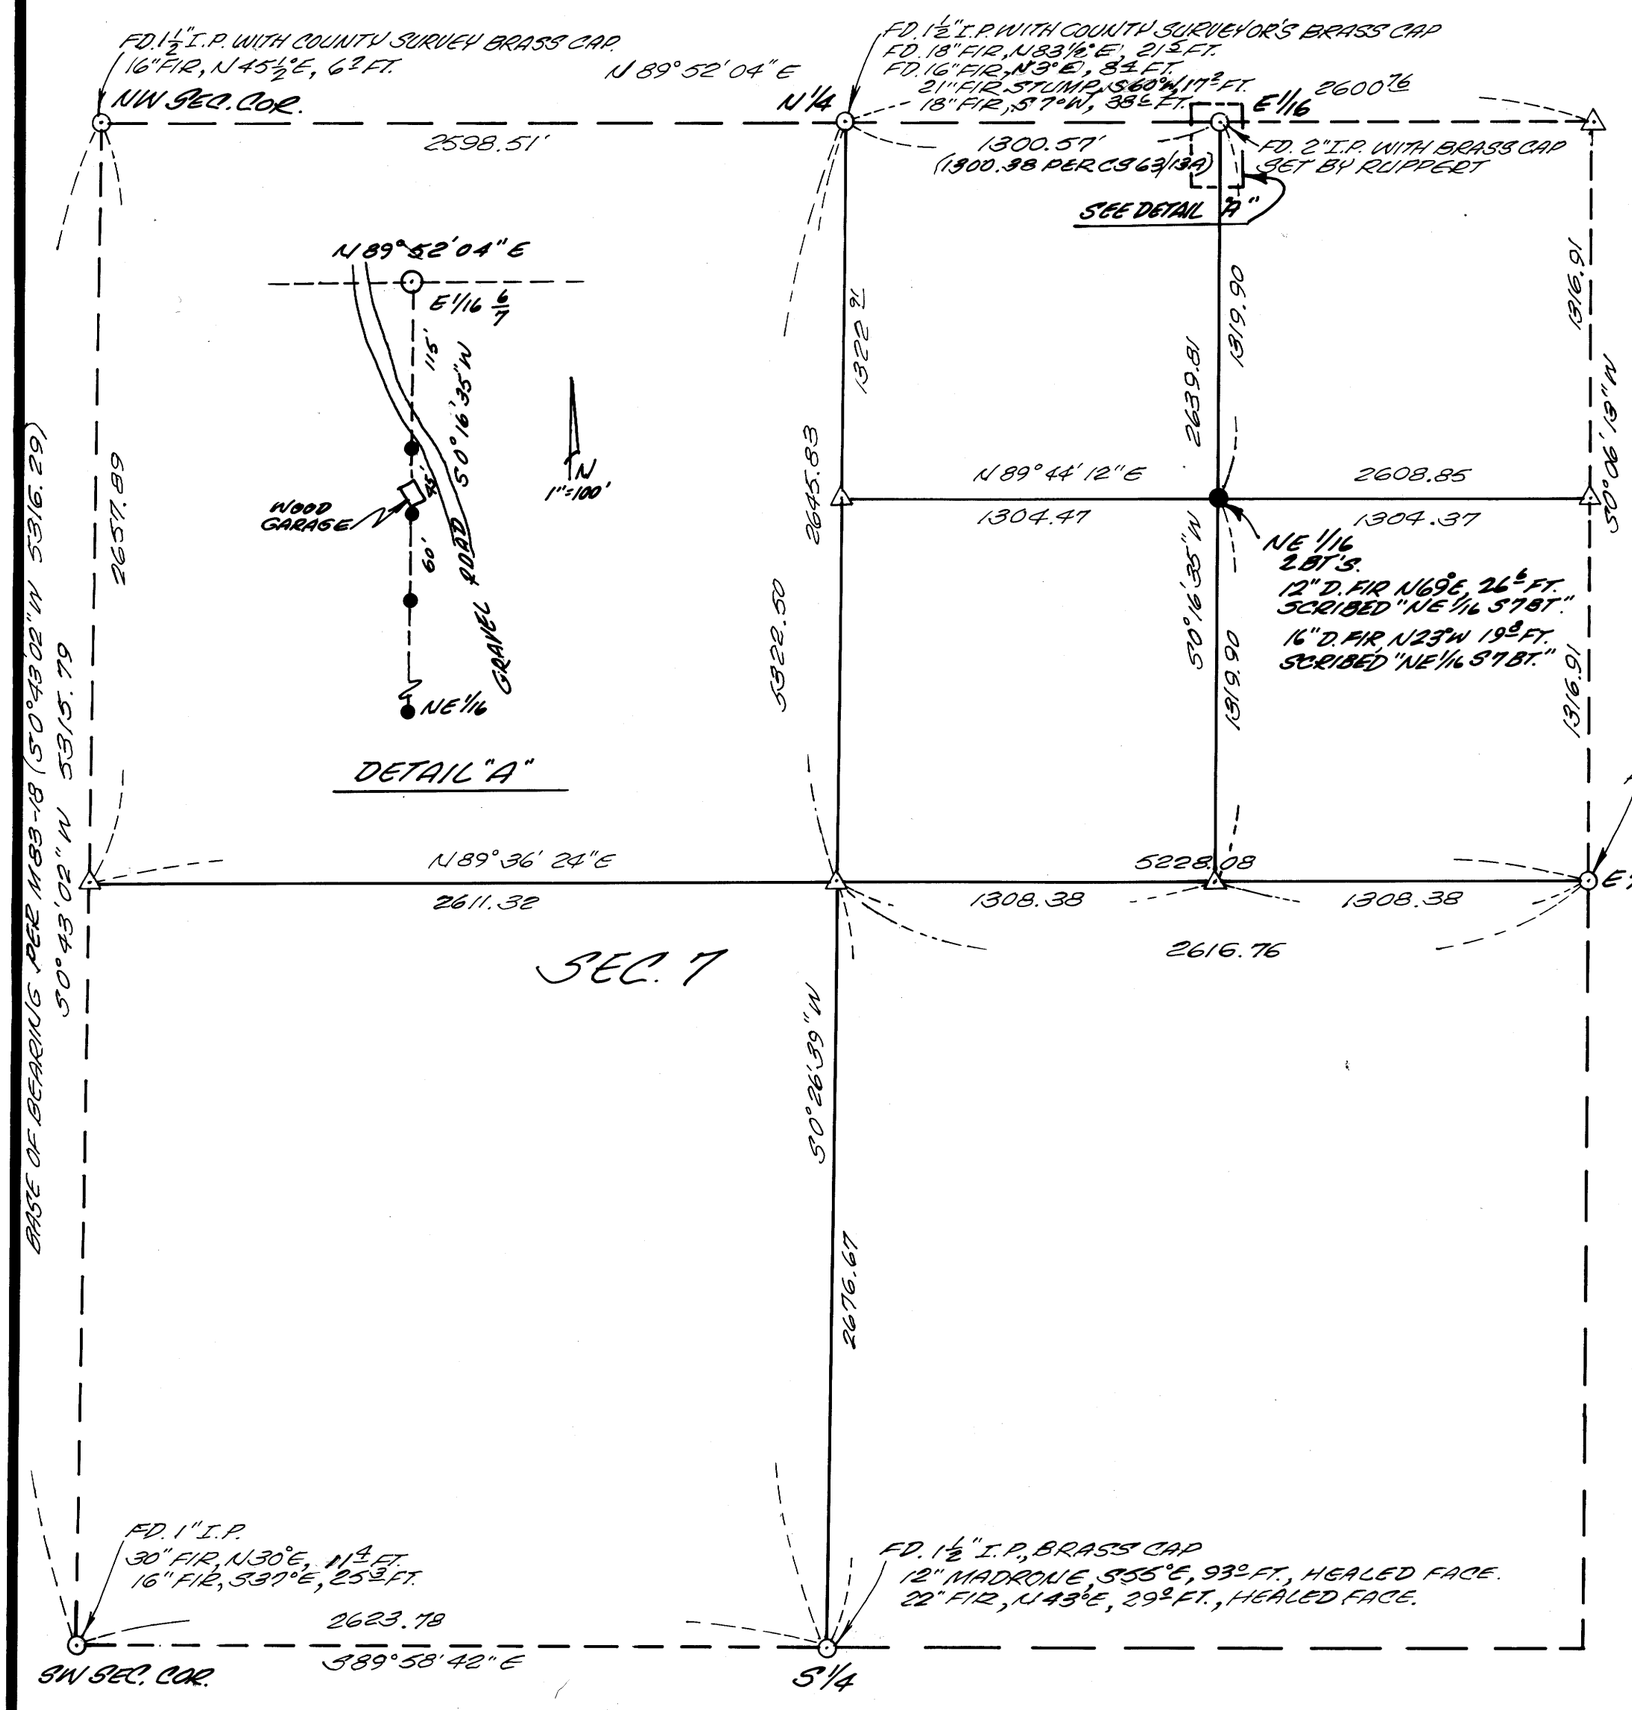

SCALE: 1" = 500'
MAR., 1987

LEGEND:

- ● 5/8" x 30" I.P. WITH CAP MARKED "BENTZ SUR. INC."
- ○ FOUND AS NOTED
- ( ) RECORD DATA
- △ COMPUTED POINT

SURVEYED BY:

DONALD A. BENTZ, INC.
P.O. BOX 901
WINCHESTER, OR. 97495

SURVEYED FOR:

MYRL & MIGNONETTE BARKHURST
561 BIG LICK LN.
MYRTLE CREEK, OR. 97457

SURVEY NARRATIVE

PURPOSE: TO SET NE 1/16 CORNER OF SEC. 7 AND FLAG THE LINE NORTH TO THE E 1/16 OF SEC. 7 COMPUTED NE SEC. COR. BY PROJECTION FROM E 1/16 PER RUPPERT SURVEY, C.S. 63/13A.

FIELD CREW: DAVE DELATTE, JIM ARTMAN

EQUIPMENT: WILD T-1 & RED 1 EDM.

COMPUTATIONS: DAVE DELATTE

DRAFTING: DON STULL

REGISTERED
PROFESSIONAL
LAND SURVEYOR

OREGON
JULY 12, 1968
DONALD A. BENTZ
839

M 163-75