PROPERTY SURVEY IN LOT 13, BLOCK 2, PLAT O, SUTHERLIN LAND AND WATER CO., IN THE N.E. 1/4, SECTION 19, T.25S., R.5W., W.M., SUTHERLIN, OREGON

COUNTY SURVEYORS FILE DATA
DO NOT REMOVE FROM OFFICE

MAP FILE M104-4

FOR: LYLE E. & VIRGINIA L. BLOOM

SURVEYOR: ROBERT L. DOLAN
RT. 1 BOX 1820
SUTHERLIN, OR. 97479

DATE: MAY 1987

SCALE: 1" = 100'

Legend:
- ○ FOUND AS SHOWN
- ● SET 5/8" X 30" IRON ROD W/CAP (L.S. 1076)

NARRATIVE: SURVEY TO MONUMENT PROPERTY CORNERS.

NOTE "A": POINTS ESTABLISHED AT RECORD DEED DISTANCES.

NOTE "B": POINT COMPUTED BY BEARING - BEARING INTERSECTION.

NOTE: ROAD RIGHT-OF-WAY WIDTHS ON COMSTOCK ROAD ARE LESS THEN RECORD.

INSTRUMENTS: THEODOLITE - DISTANCE METER

FILED
MAY 7 1987
COUNTY SURVEYOR
DOUGLAS COUNTY, ORE.

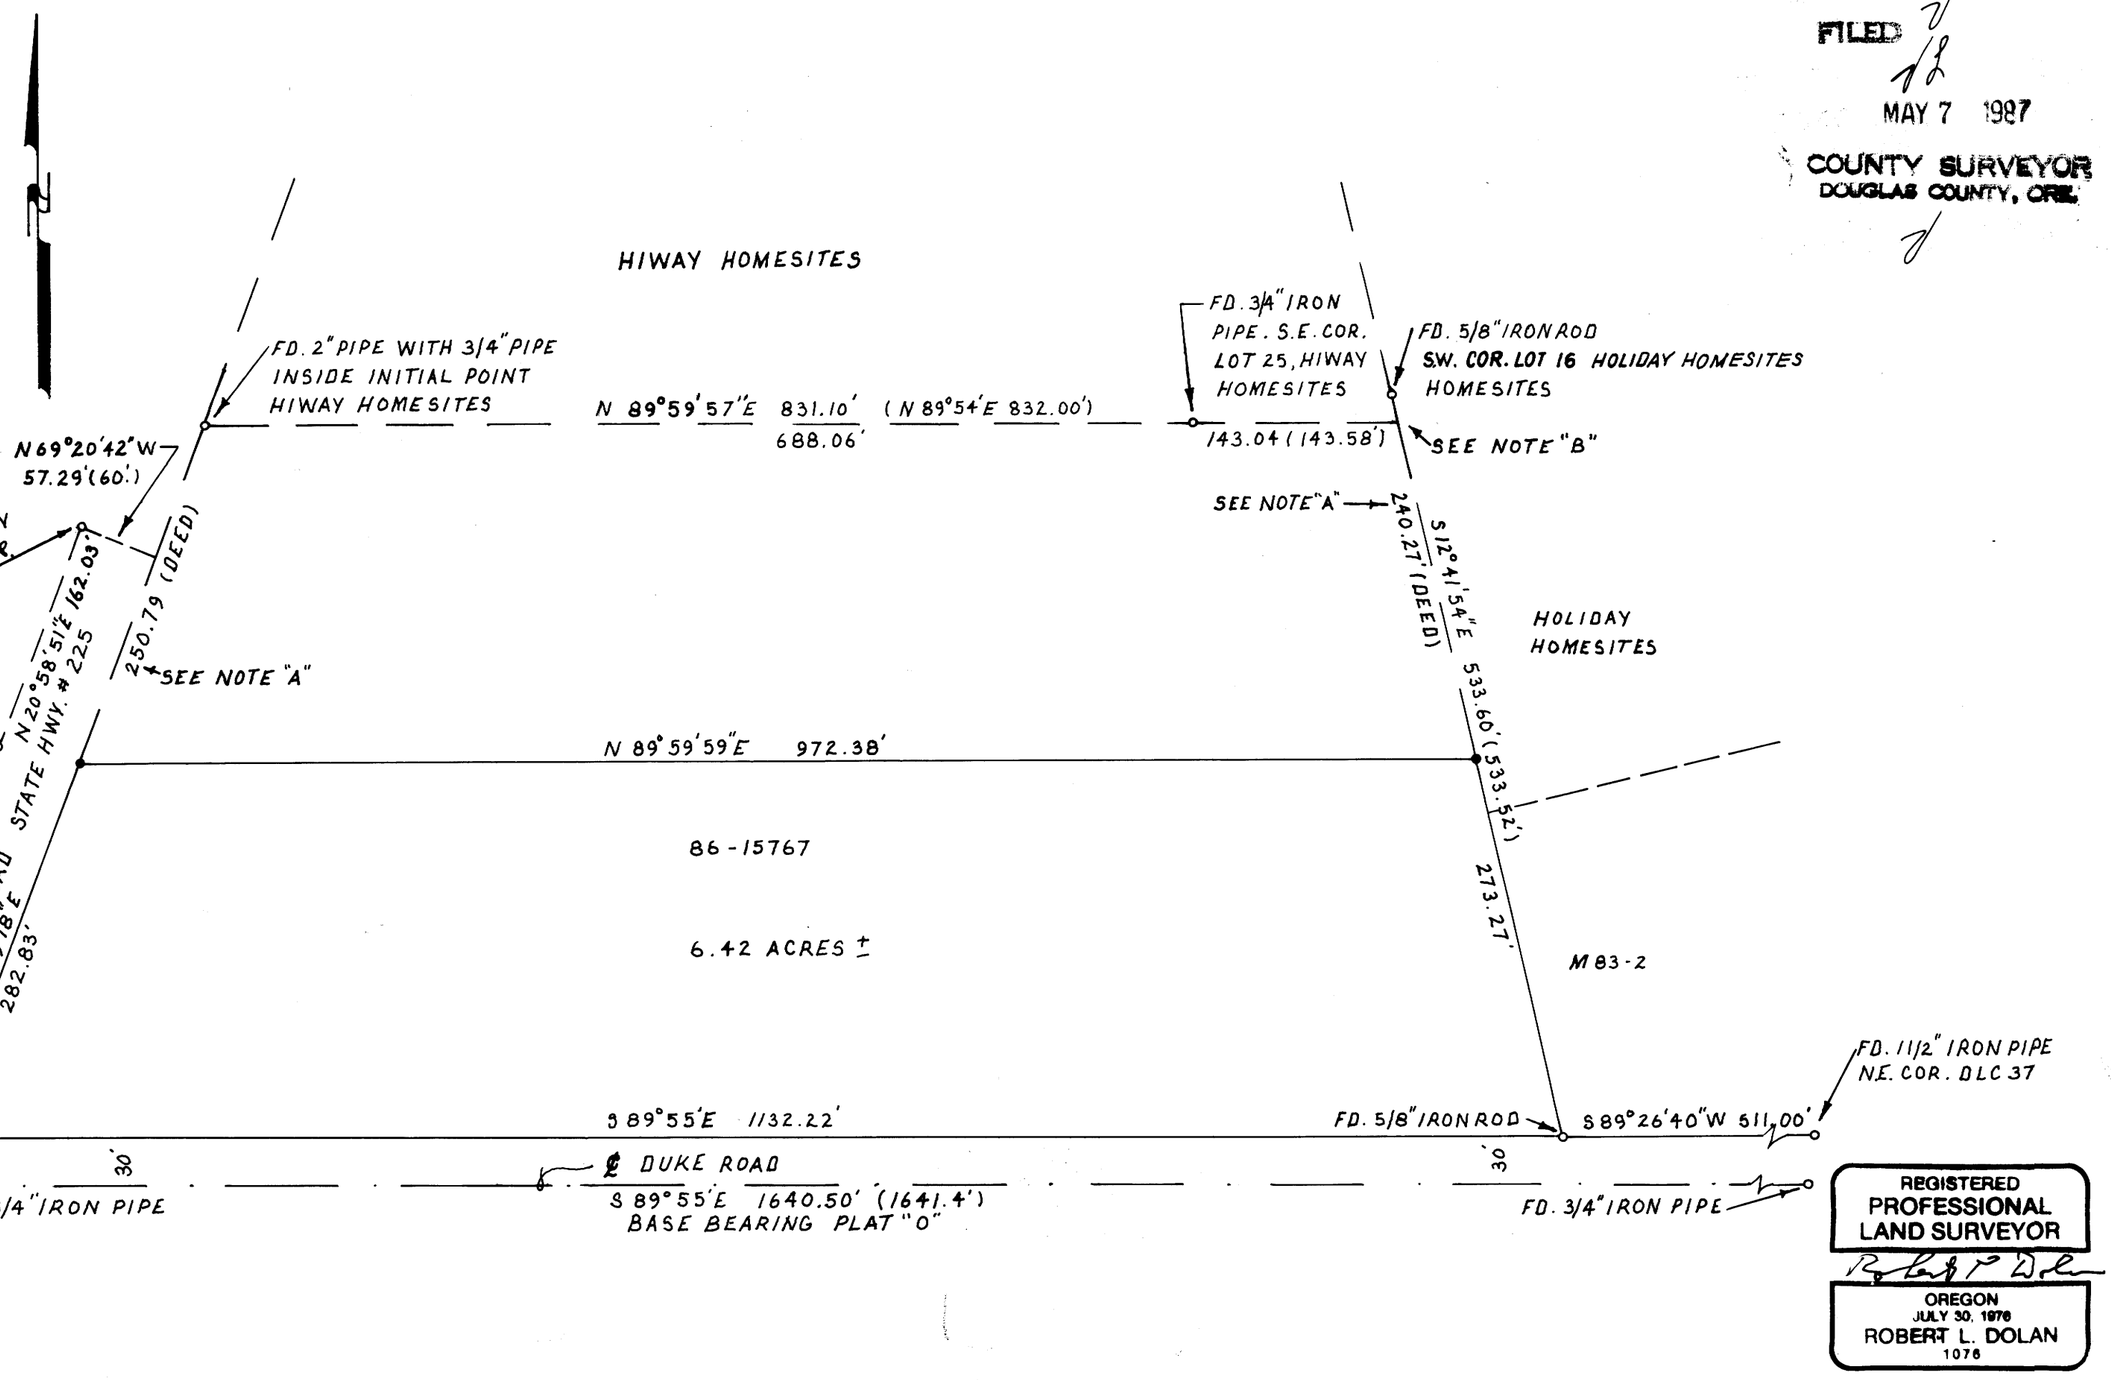

REGISTERED
PROFESSIONAL
LAND SURVEYOR
Robert L. Dolan
OREGON
JULY 30, 1976
ROBERT L. DOLAN
1076

MAP FILE M104-4