COUNTY SURVEYORS FILE DATA
DO NOT REMOVE FROM OFFICE

SURVEY TO LOCATE E. & W. LINES OF MOST EASTERLY PARCEL OF M 17-14 LOCATED IN D.L.C. #40., SEC. 20, T. 27 S., R. 5 W. W.M., DOUGLAS CO. ORE.

SEP. 1987

FILED TF
SEP 14 1987
COUNTY SURVEYOR
DOUGLAS COUNTY, ORE.

MAP FILE M 104 - 56

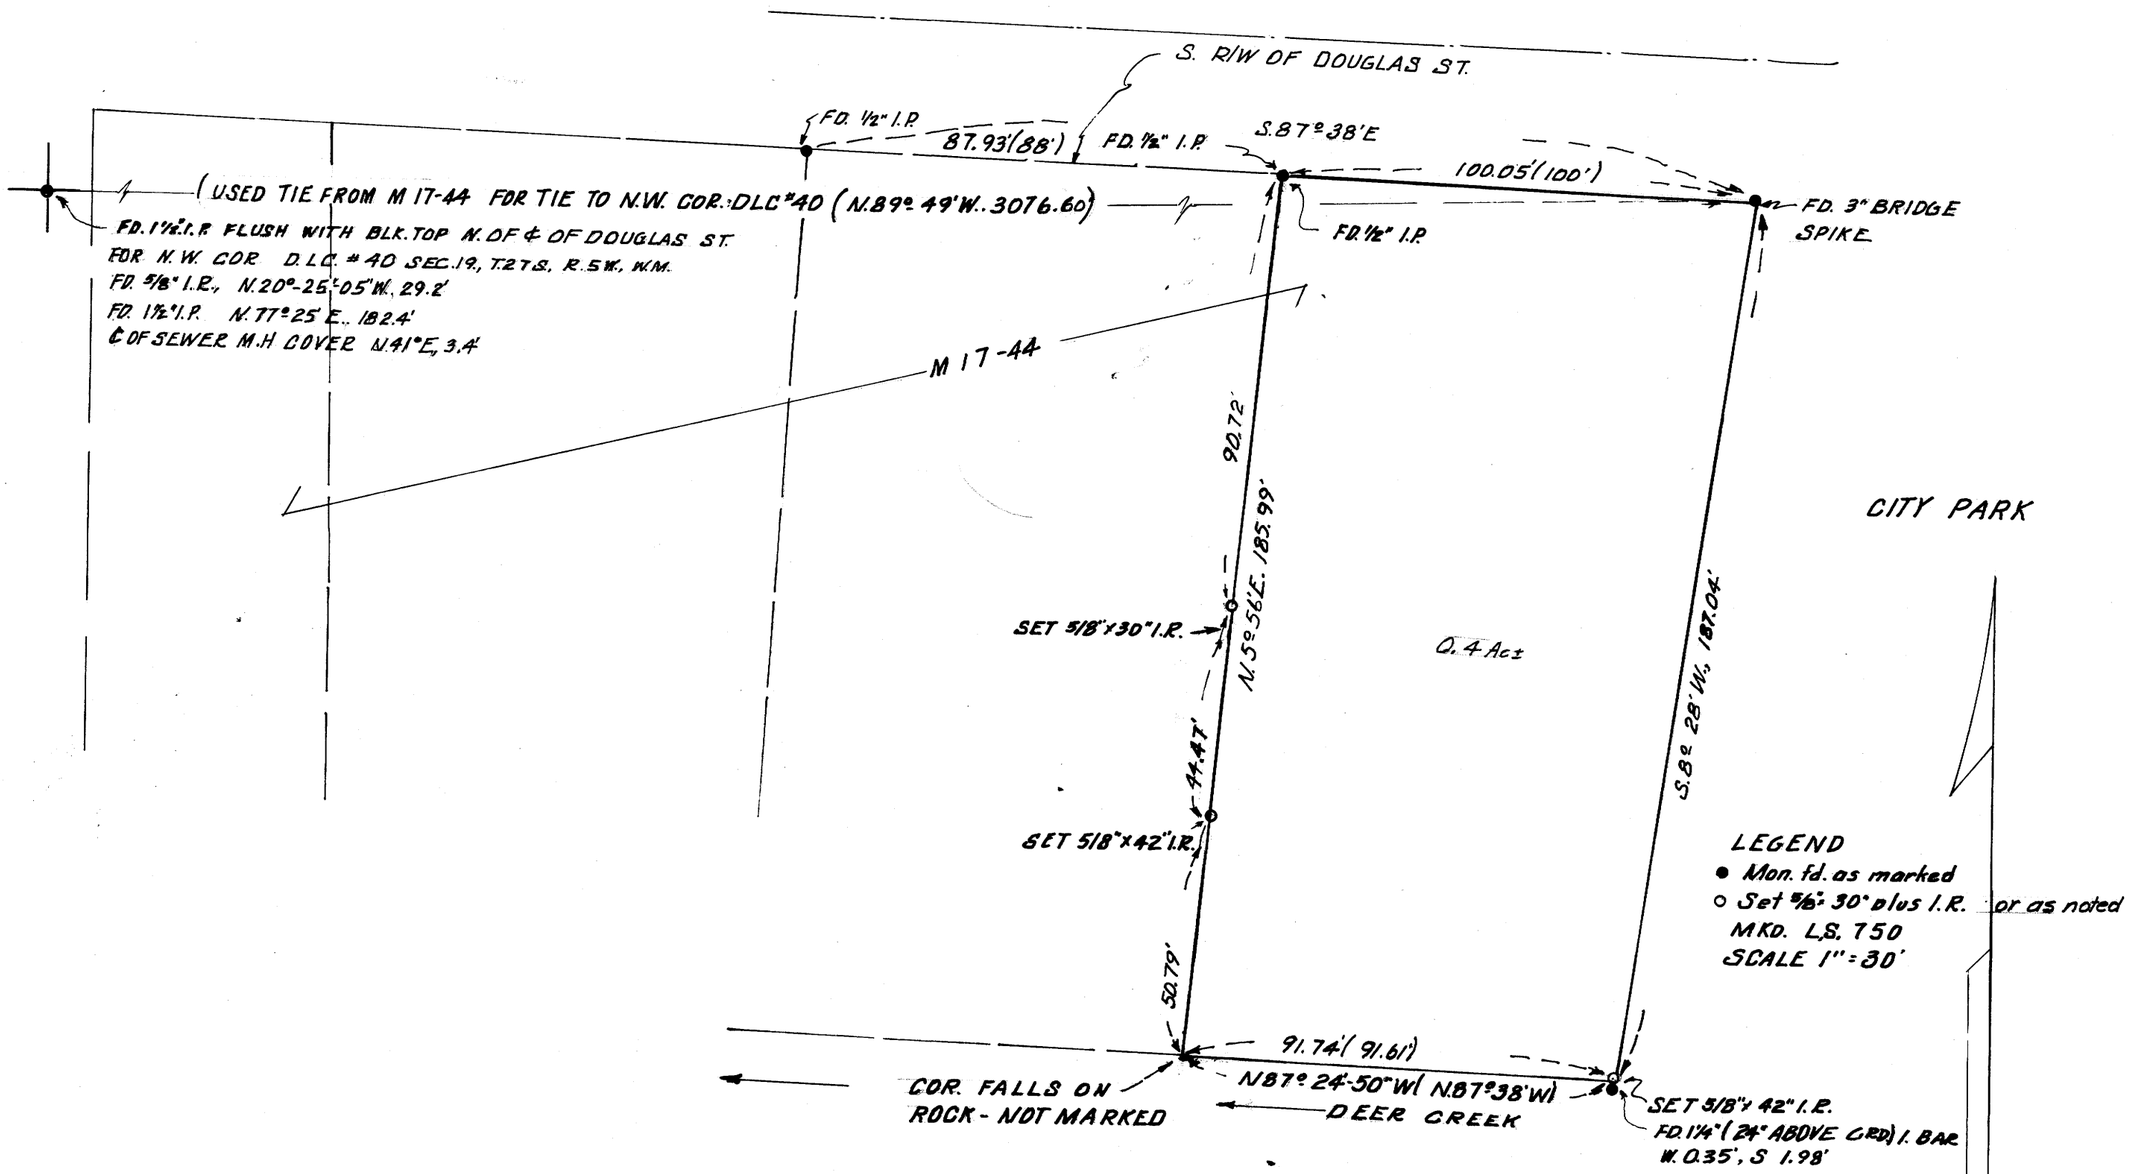

For KIETH WEIKUM
981 QUAIL LANE
ROSEBURG, ORE
Ph. 672-4222

REGISTERED PROFESSIONAL LAND SURVEYOR
Herbert L. Northcraft
OREGON JULY 6, 1965
HERBERT L. NORTHCRAFT
750

Survey & Map by
Herbert L. Northcraft
3520 Olalla Rd.,
Winston, Oregon 679-8692

Narrative - Fd. Monuments noted along Douglas St. & 1 1/4" shaft on East line and Electric pole "stubbed", being set by a newer pole East of line, as indication of lines. Douglas street monuments used as a base bearing N.87° 38'W., to establish E & W lines. S.E. Cor. set by record distance & bearing. S.W. Cor. fell on basalt bed rock in the flood area. Used record dist. and bearing to set other points on line. Did not set S.W. Corner point.

MAP FILE M 104 - 56