MAP FILE M 105 - 1

COUNTY SURVEYORS FILE DATA
DO NOT REMOVE FROM OFFICE

SURVEY FOR DEED DESCRIPTIONS
IN LOTS 16 & 17, BL. 2, GLENGARRY FRUITLANDS
IN The N.E. 1/4 of SEC. 19, T. 28S., R. 5W.W.M.
FOR HOWARD CAMPBELL
by BRUCE ROGERS
1420 N.W. GROVE LANE
Roseburg, Or.
SEPT., 1987
1" = 100'

FILED
OCT 21 1987
COUNTY SURVEYOR
DOUGLAS COUNTY, ORE.

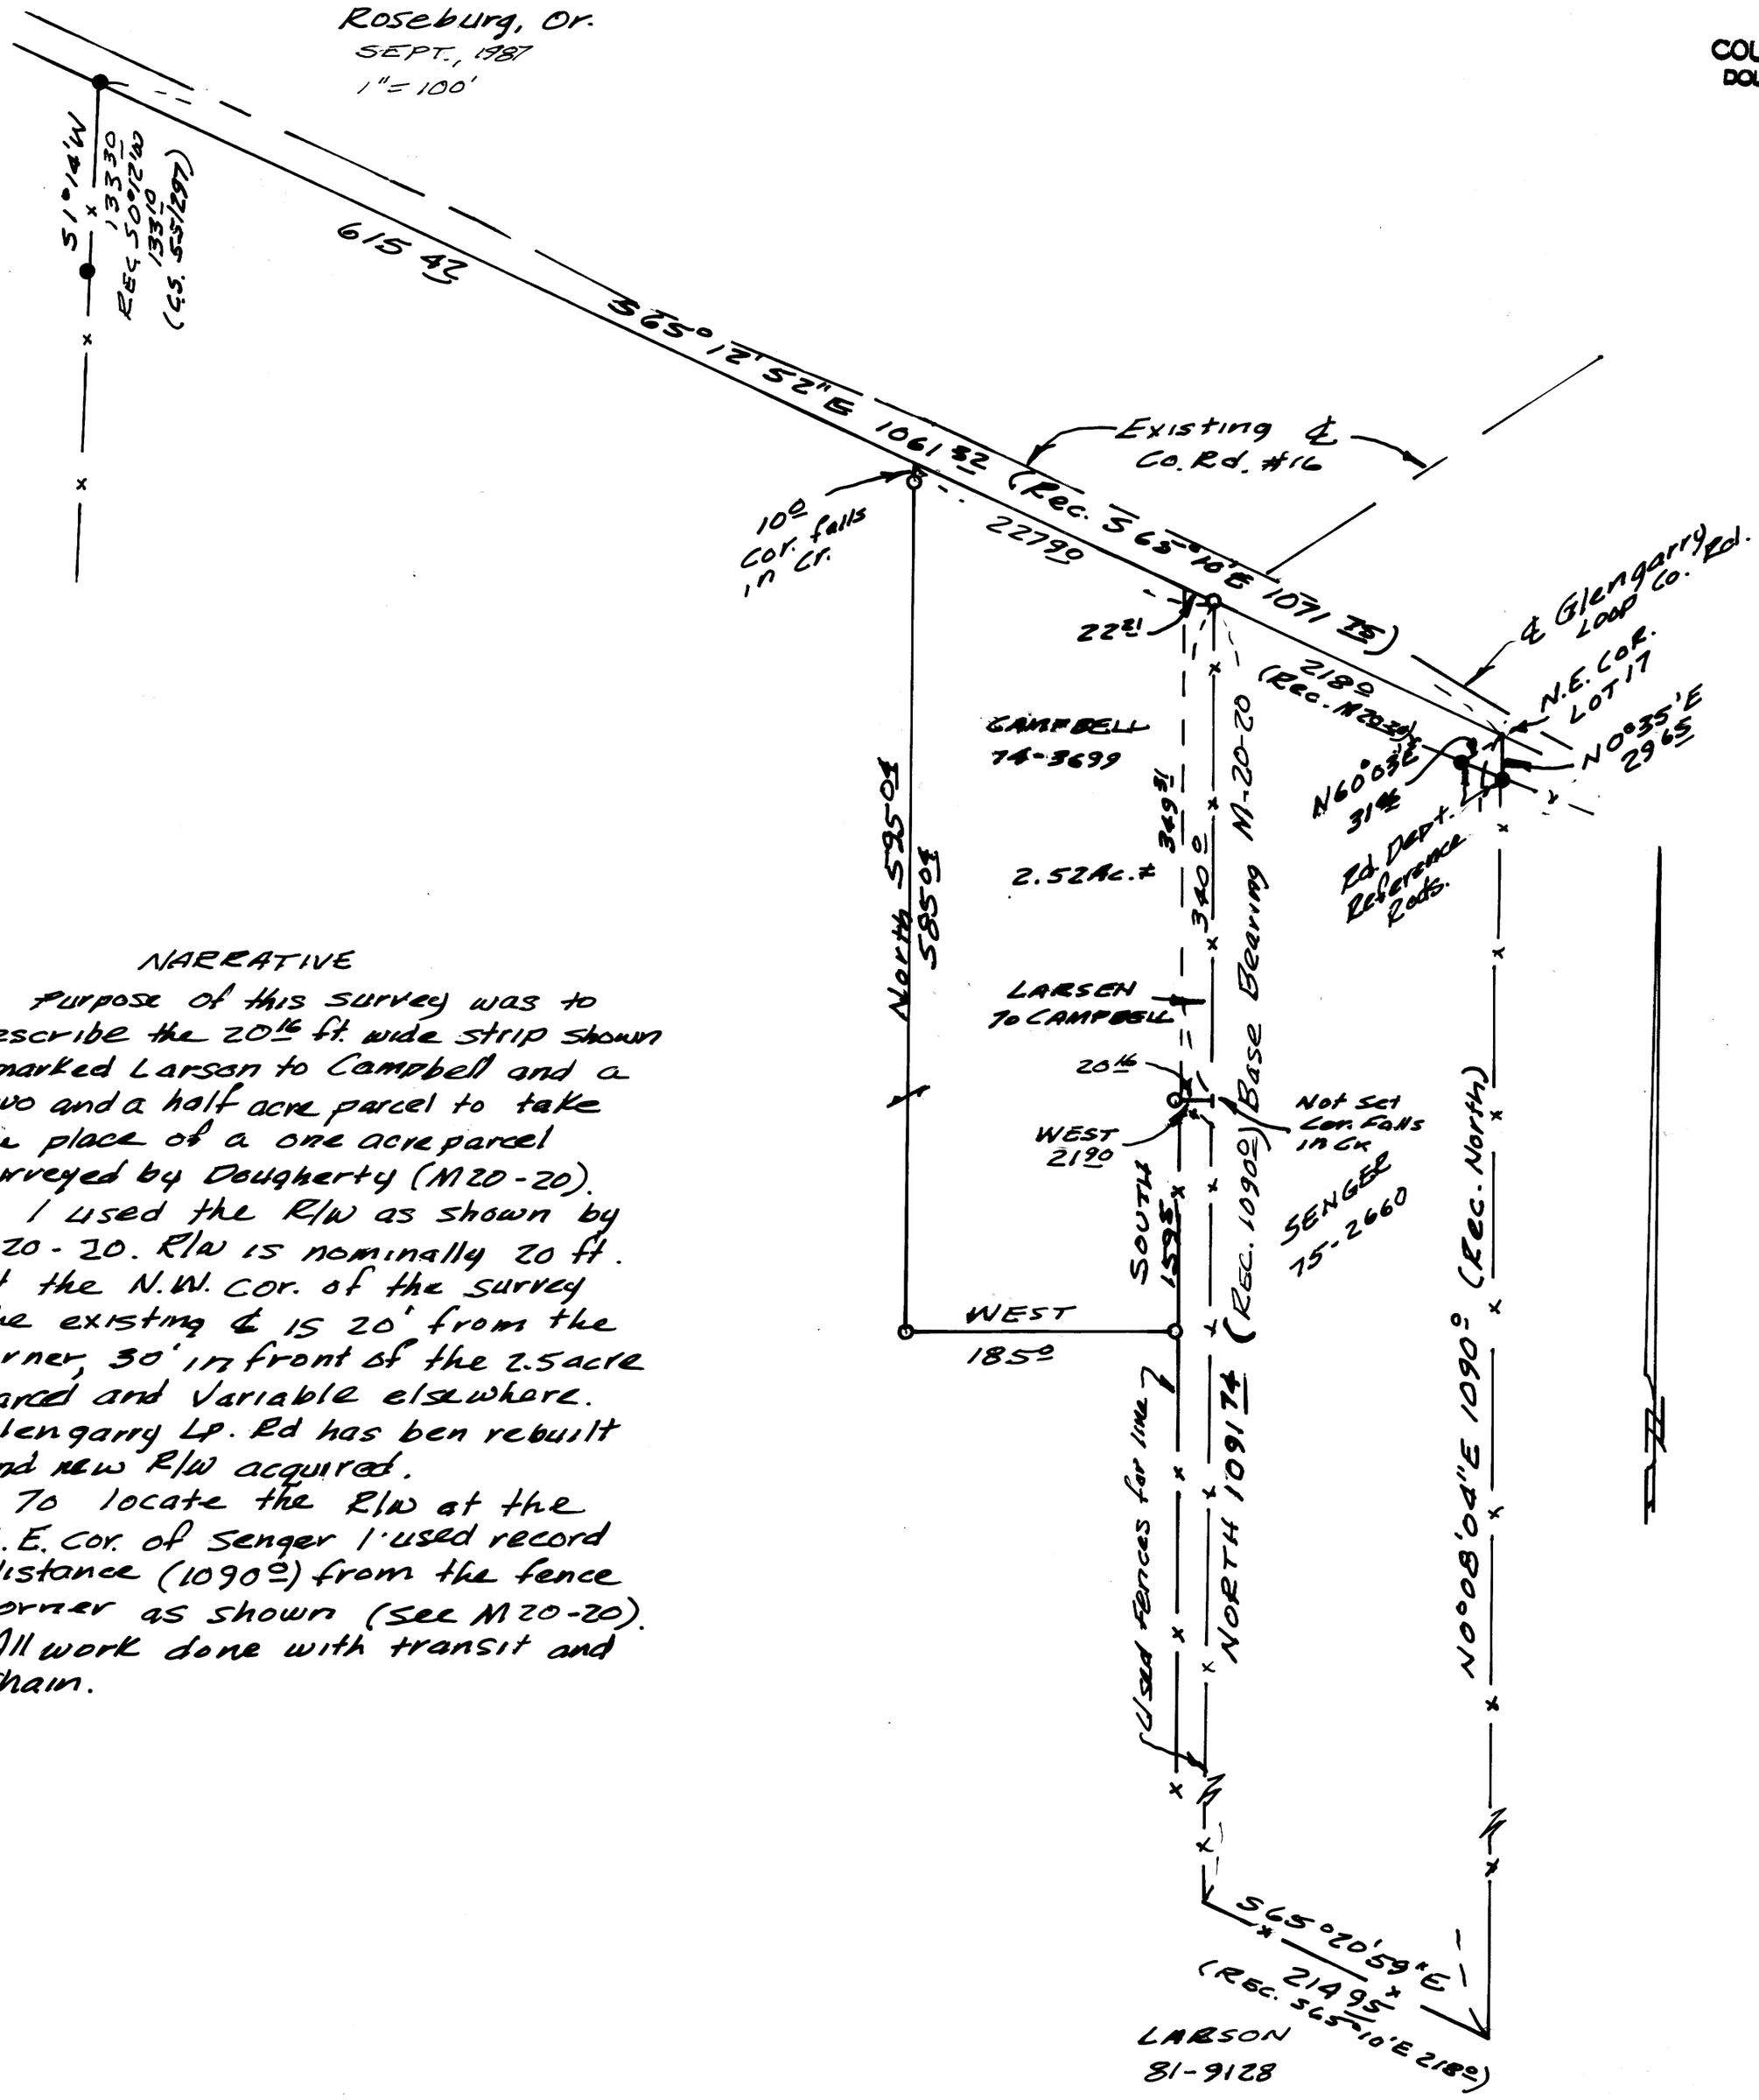

NARRATIVE

Purpose of this survey was to describe the 20.16 ft. wide strip shown (marked Larson to Campbell and a two and a half acre parcel to take the place of a one acre parcel surveyed by Dougherty (M20-20).

I used the R/W as shown by M 20-20. R/W is nominally 20 ft. At the N.W. Cor. of the survey the existing ℄ is 20' from the corner, 30' in front of the 2.5 acre parcel and Variable elsewhere. Glengarry Lp. Rd has ben rebuilt and new R/W acquired.

To locate the R/W at the N.E. Cor. of Senger I used record distance (1090.0) from the fence corner as shown (see M 20-20). All work done with transit and chain.

REGISTERED
OREGON
LAND SURVEYOR
Bruce R. Rogers
JULY 10, 1964
BRUCE R. ROGERS
660

● Fd. 5/8" Iron Rods (C.S. 55/297 & Rd. Dept.)
○ Set 5/8" Iron Rods 30" long with cap marked L.S. 660

MAP FILE M 105 - 1