MAP FILE M105-22

PROPERTY SURVEY IN A PORTION OF LOT 2, BLOCK 1, PLAT I, SUTHERLIN LAND AND WATER CO., IN THE N.E. 1/4, SECTION 14, T.25S., R.5W., W.M., DOUGLAS COUNTY, OREGON.

COUNTY SURVEYORS FILE DATA
DO NOT REMOVE FROM OFFICE

FILED
DEC 15 1987
COUNTY SURVEYOR
DOUGLAS COUNTY, ORE.

FOR · JACK L. & WENDY L. FENNELL

BY · ROBERT L. DOLAN
RT. 1 BOX 1820
SUTHERLIN, OR. 97479

DATE · NOVEMBER 1987

SCALE · 1"=50'

Legend · ○ FD. AS NOTED
● SET 5/8" x 30" IRON ROD W/CAP (L.S. 1076)

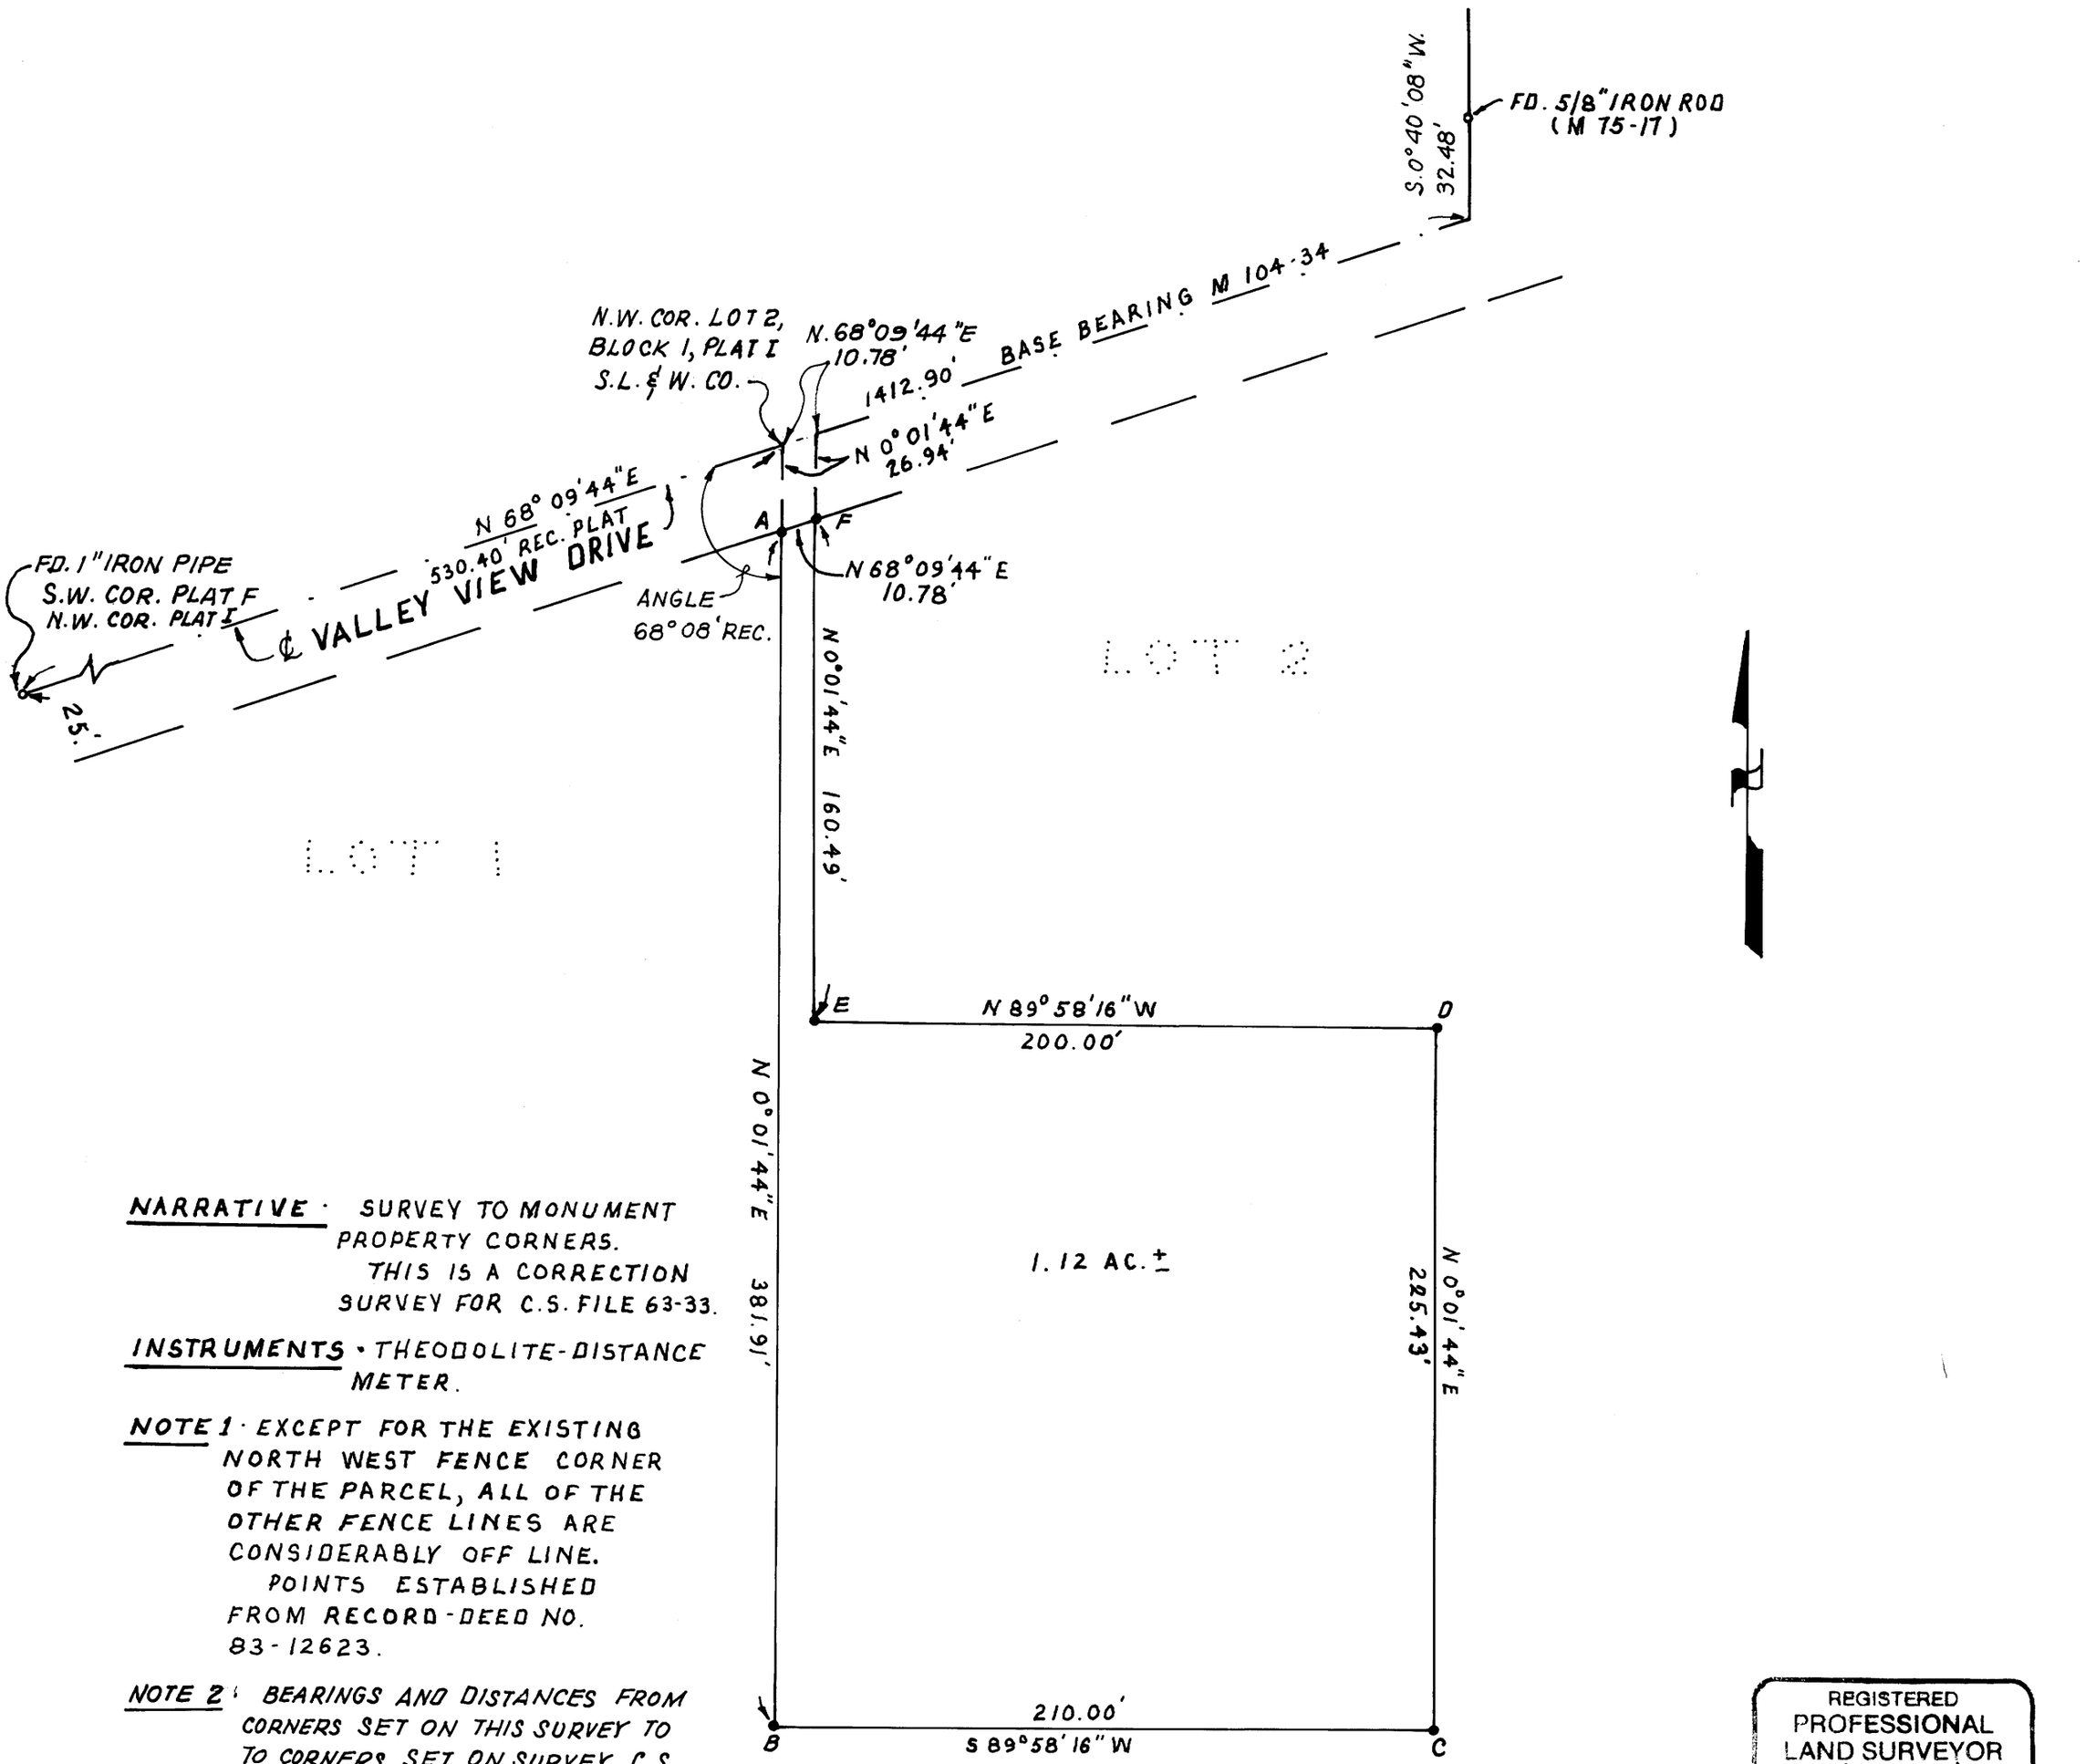

NARRATIVE · SURVEY TO MONUMENT PROPERTY CORNERS. THIS IS A CORRECTION SURVEY FOR C.S. FILE 63-33.

INSTRUMENTS · THEODOLITE-DISTANCE METER.

NOTE 1 · EXCEPT FOR THE EXISTING NORTH WEST FENCE CORNER OF THE PARCEL, ALL OF THE OTHER FENCE LINES ARE CONSIDERABLY OFF LINE. POINTS ESTABLISHED FROM RECORD-DEED NO. 83-12623.

NOTE 2 · BEARINGS AND DISTANCES FROM CORNERS SET ON THIS SURVEY TO TO CORNERS SET ON SURVEY C.S. FILE NO. 63/33

A - S. 67° 28'30"W., - 0.29 FT.
B - N. 89° 42'55"W., - 4.02 FT.
C - S. 63° 06'09"W., - 4.52 FT.
D - S. 41° 25'15"W., - 2.75 FT.
E - S. 87° 14'04"W., - 1.87 FT.
F - S 67° 28' 24"W., - 0.29 FT.

REGISTERED
PROFESSIONAL
LAND SURVEYOR
Robert L Dolan
OREGON
JULY 30, 1976
ROBERT L. DOLAN
1076

M105-22