COUNTY SURVEYORS FILE DATA
DO NOT REMOVE FROM OFFICE

FILED
DEC 29 1987
COUNTY SURVEYOR
DOUGLAS COUNTY, ORE.

C.S. File 63/55 M105-28

SURVEY OF SOUTH 1/2 SECTION 9, T22S, R12W, W.M. DOUGLAS COUNTY, OREGON FOR INTERNATIONAL PAPER COMPANY BY

ROBERTS SURVEYING INC.
29 WEST 29TH STREET
EUGENE, OREGON 97405

DECEMBER 15, 1987

WEST 1/4 CORNER SECTION 9
NOT TIED THIS SURVEY

CENTER 1/4 CORNER SECTION 9
FD. 1985 BRASS CAP SET IN C.S. M98-54
21" FIR, S44°W, 22.4' (SCRIBE VIS.), 1985 B.T.
26" FIR, N02°W, 15.6' (SCRIBE VIS.), 1985 B.T.

EAST 1/4 CORNER SECTION 9
FD. 1982 BRASS CAP SET IN C.S. RM3-59
20" FIR , S80°E, 84.2' (SCRIBE VIS.) , 1982 B.T.
30" HEMLOCK, S47°W, 74.6' (BARK SCRIBED), 1982 B.T.

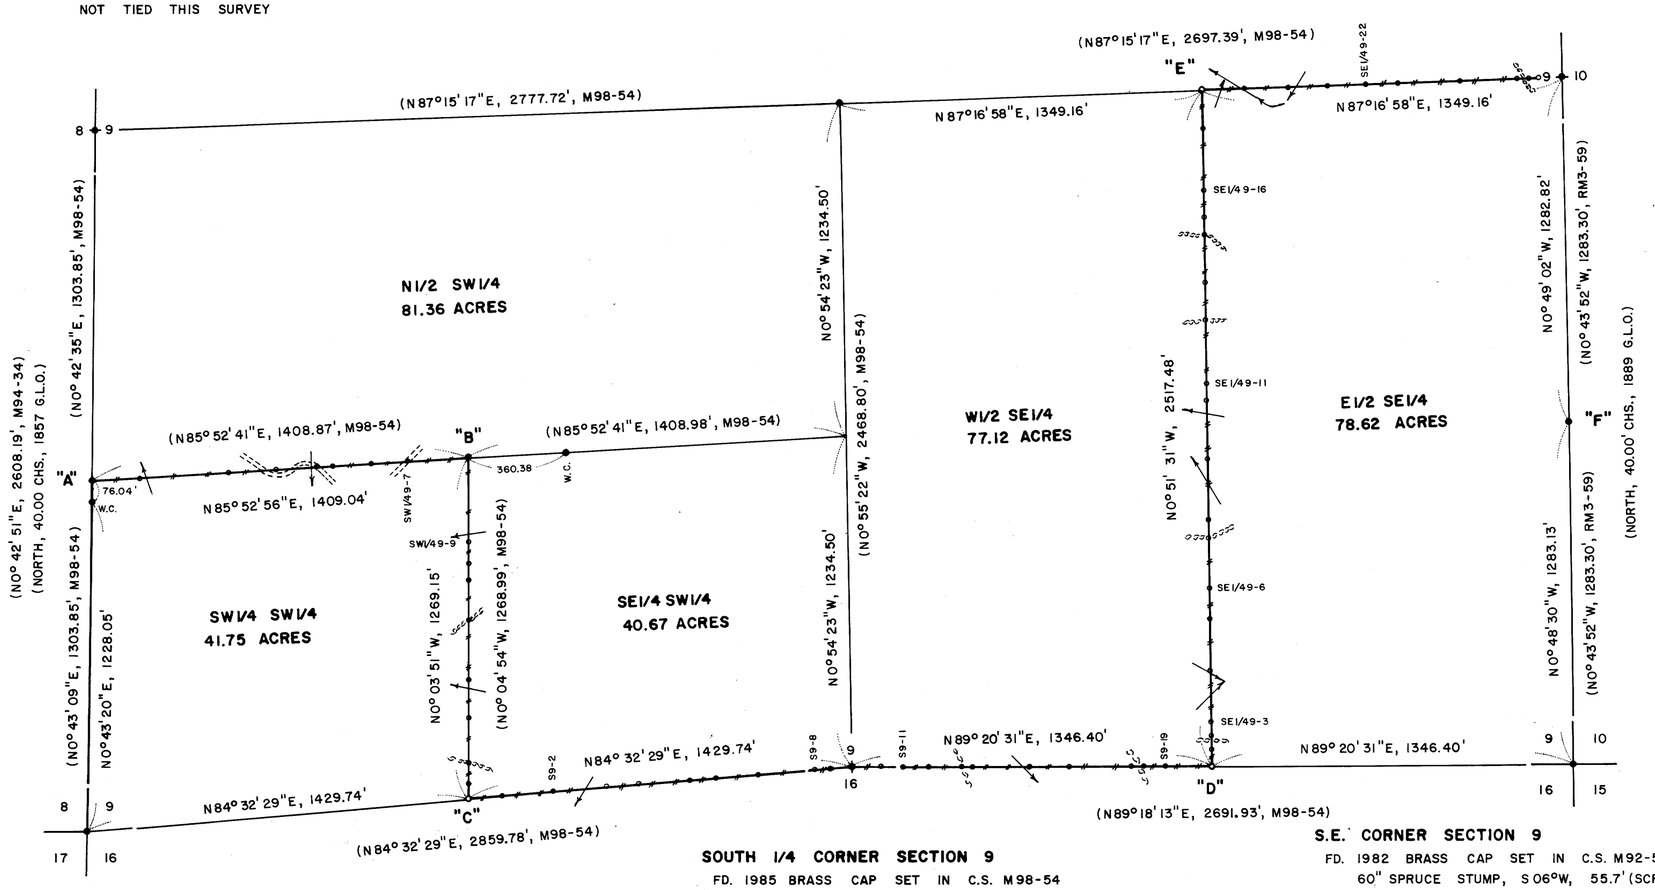

SCALE 1" = 400'

SOUTH 1/4 CORNER SECTION 9
FD. 1985 BRASS CAP SET IN C.S. M98-54
30" DOWNED HEMLOCK, N60°W, 25.5' (SCRIBE VIS.), 1889 B.T.
60" SPRUCE STUMP , S62°E, 24.4' (NO MARKS) , 1889 B.T.
16" FIR , S27°W, 12.0' (SCRIBE VIS.), 1985 B.T.
22" FIR , EAST , 19.5' (SCRIBE VIS.), 1985 B.T.

S.E. CORNER SECTION 9
FD. 1982 BRASS CAP SET IN C.S. M92-57.
60" SPRUCE STUMP, S06°W, 55.7' (SCRIBE VIS.) , 1889 B.T.
12" HEMLOCK , S25°E, 17.0' (SCRIBE VIS.) , 1982 B.T.
12" ALDER , N46°E, 38.4' (BARK SCRIBED), 1982 B.T.
16" ALDER , N31°W, 37.6' (BARK SCRIBED), 1982 B.T.
16" HEMLOCK , S43°W, 55.4' (SCRIBE VIS.) , 1982 B.T.

S.W. CORNER SECTION 9
FD. 1982 DOUGLAS COUNTY BRASS CAP
36" SPRUCE STUMP, N07°E, 47.5' (SCRIBE VIS.), 1857 B.T.
14" CEDAR , N31°W, 14.7' (SCRIBE VIS.), 1982 C.S.B.T.
14" CEDAR , S73°W, 22.4' (SCRIBE VIS.), 1982 C.S.B.T.
15" CEDAR , S36°E, 18.7' (SCRIBE VIS.), 1982 C.S.B.T.
19" SPRUCE , N85°E, 22.7' (SCRIBE VIS.), 1982 C.S.B.T.

"A" SOUTH 1/16 CORNER SECTION 9
FD. 1983 BRASS CAP SET IN C.S. M94-34 AND MARKED S 1/16 W.C. TRUE CORNER BEARS N0°43'20"E, 76.04'.
13" HEMLOCK, N74°W, 45.4' (SCRIBE VIS.) , 1983 B.T.
17" ALDER , N19°E, 14.5' (BARK SCRIBED), 1983 B.T.
SET 60" ALUMINUM POST IN SWAMP FOR TRUE 1/16 CORNER.

"B" S.W. 1/16 CORNER SECTION 9
FD. 1985 BRASS CAP SET IN C.S. M98-54 AND MARKED S.W. 1/16 W.C. TRUE CORNER BEARS S85°52'56"W, 360.38'.
10" SPRUCE, N54°W, 10.1' (SCRIBE VIS.), 1985 B.T.
10" SPRUCE, N67°E, 16.0' (SCRIBE VIS.), 1985 B.T.
SET 60" ALUMINUM POST IN SWAMP FOR TRUE 1/16 CORNER.

"C" WEST 1/16 CORNER SECTION 9
SET 5/8" x 36" ALUMINUM ROD WITH 3 1/4" ALUMINUM CAP. (BURIED PURPLE M.M. UNDER 36" ALUMINUM ROD)
12" FIR, N40°E, 8.7' (SCRIBED/PAINTED RED)
23" FIR, S35°E, 9.9' (SCRIBED/PAINTED RED)

"D" EAST 1/16 CORNER SECTION 9
SET 5/8" x 36" ALUMINUM ROD WITH 3 1/4" ALUMINUM CAP. (BURIED PURPLE M.M. UNDER 36" ALUMINUM ROD)
18" ALDER , S 84°W, 32.5' (BARK SCRIBED/PAINTED RED)
18" SPRUCE, N02°E, 50.7' (SCRIBED/PAINTED RED)

"E" C.E. 1/16 CORNER SECTION 9
SET 5/8" x 36" ALUMINUM ROD WITH WITH 3 1/4" ALUMINUM CAP. (BURIED PURPLE M.M. UNDER 36" ALUMINUM ROD)
9" FIR, N06°E, 6.0' (SCRIBED/PAINTED RED)
26" FIR, S64°E, 6.9' (SCRIBED/PAINTED RED)

"F" SOUTH 1/6 CORNER SECTION 9
FD. 1982 BRASS CAP SET IN C.S. RM3-59
12" FIR, S69°E, 22.1' (SCRIBE VIS.), 1982 B.T.
13" FIR, S14°W, 15.7' (SCRIBE VIS.), 1982 B.T.

		LOCATION OF BURIED MAGNETIC MARKERS			
S. 1/16	0'	EAST (AL. POST)	S9-15	667'	EAST (M.M. & AL. POST)
SW1/4 9-1	172'	EAST (M.M. & AL. POST)	S9-16	816'	EAST (M.M.)
SW1/4 9-2	504'	EAST (M.M. & AL. POST)	S9-17	1042'	EAST (M.M. & AL. POST)
SW1/4 9-3	686'	EAST (M.M. & AL. POST)	S9-18	1091'	EAST (M.M.)
SW1/4 9-4	835'	EAST (M.M.)	S9-19	1168'	EAST (M.M.)
SW1/4 9-5	893'	EAST (M.M. & AL. POST)	E. 1/16	1346'	EAST (M.M. & AL. POST)
SW1/4 9-6	1041'	EAST (M.M.)	SE1/4 9-1	63'	NORTH (M.M.)
SW1/4 9-7	1176'	EAST (M.M. & AL. POST)	SE1/4 9-2	112'	NORTH (M.M. & AL. POST)
SW 1/16	1409'	EAST (AL. POST)	SE1/4 9-3	161'	NORTH (M.M.)
SW1/4 9-9	312'	SOUTH (M.M. & AL. POST)	SE1/4 9-4	357'	NORTH (M.M. & AL. POST)
SW1/4 9-10	396'	SOUTH (M.M.)	SE1/4 9-5	551'	NORTH (M.M. & AL. POST)
SW1/4 9-11	461'	SOUTH (M.M.)	SE1/4 9-6	658'	NORTH (M.M.)
SW1/4 9-12	605'	SOUTH (M.M. & AL. POST)	SE1/4 9-7	851'	NORTH (M.M. & AL. POST)
SW1/4 9-13	828'	SOUTH (M.M.)	SE1/4 9-8	914'	NORTH (M.M.)
SW1/4 9-14	972'	SOUTH (M.M. & AL. POST)	SE1/4 9-9	1141'	NORTH (M.M. & AL. POST)
SW1/4 9-15	1141'	SOUTH (M.M.)	SE1/4 9-10	1359'	NORTH (M.M.)
SW1/4 9-16	1214'	SOUTH (M.M.)	SE1/4 9-11	1419'	NORTH (M.M. & AL. POST)
W. 1/16	1269'	SOUTH (M.M. & AL. POST)	SE1/4 9-12	1658'	NORTH (M.M. & AL. POST)
S9-1	124'	EAST (M.M.)	SE1/4 9-13	1799'	NORTH (M.M.)
S9-2	316'	EAST (M.M. & AL. POST)	SE1/4 9-14	1973'	NORTH (M.M. & AL. POST)
S9-3	514'	EAST (M.M.)	SE1/4 9-15	2040'	NORTH (M.M.)
S9-4	634'	EAST (M.M. & AL. POST)	SE1/4 9-16	2137'	NORTH (M.M. & AL. POST)
S9-5	831'	EAST (M.M.)	SE1/4 9-17	2372'	NORTH (M.M.)
S9-6	924'	EAST (M.M. & AL. POST)	C.E. 1/16	2518'	NORTH (M.M. & AL. POST)
S9-7	1087'	EAST (M.M.)	SE1/4 9-19	159'	EAST (M.M. & AL. POST)
S9-8	1297'	EAST (M.M. & AL. POST)	SE1/4 9-20	323'	EAST (M.M.)
S9-9	1350'	EAST (M.M.)	SE1/4 9-21	476'	EAST (M.M. & AL. POST)
S. 1/4	1430'	EAST (AL. POST)	SE1/4 9-22	615'	EAST (M.M.)
S9-10	108'	EAST (M.M.)	SE1/4 9-23	733'	EAST (M.M. & AL. POST)
S9-11	195'	EAST (M.M. & AL. POST)	SE1/4 9-24	967'	EAST (M.M. & AL. POST)
S9-12	291'	EAST (M.M.)	SE1/4 9-25	1182'	EAST (M.M.)
S9-13	412'	EAST (M.M. & AL. POST)	SE1/4 9-26	1224'	EAST (M.M. & AL. POST)
S9-14	450'	EAST (M.M.)	SE1/49-27	1261'	EAST (M.M.)
S9-15	667'	EAST (M.M. & AL. POST)	E. 1/4	1349'	EAST (AL. POST)

LEGEND

- ● CORNERS FOUND AND USED FOR CONTROL
- ○ CORNERS SET, 5/8" ALUMINUM RODS WITH 3 1/4" ALUMINUM CAPS. CAPS STAMPED S-T-R, DATE AND P.L.S. 1039.
- LINES MARKED AND BLAZED THIS SURVEY.
- ( ) DATA OF RECORD, 1857 AND 1889 G.L.O. SURVEYS. ALSO C.S. RM3-59 AND C.S. M98-54.
- (M.M.) INDICATES LOCATION OF BURIED MAGNETIC MARKERS. MARKERS ARE FLUORESCENT ORANGE IN COLOR AND ARE BURIED, 12" TO 18" DEEP, ALONG LINE AS SHOWN.
- BASIS OF BEARING, WEST 1/2 OF SOUTH LINE SECTION 9 FROM C.S. M98-54.
- DISTANCES TO B.T.'S ARE CENTER MEASURE.
- ALL NEW B.T.'S ARE SCRIBED AND HAVE AN ALUMINUM WASHER STAMPED "P.L.S. 1039" NAILED TO LOWER BLAZE. SCRIBED BLAZES ARE PAINTED RED.
- ALL NEW B.T.'S HAVE A 8" STEEL SPIKE DRIVEN INTO THE CENTER OF THE TREE TO SERVE AS A CHAINING POINT FOR MEASURED DISTANCES.

REGISTERED PROFESSIONAL LAND SURVEYOR
Lee Roberts
OREGON
L. D. ROBERTS
1039

NARRATIVE

THE PURPOSE OF THIS SURVEY IS TO POST AND BLAZE THE NORTH AND EAST SIDES OF THE SW1/4 OF THE SW1/4, THE SOUTH SIDE OF THE SE1/4 OF THE SW1/4, THE SOUTH SIDE OF THE SW1/4 OF THE SE1/4, THE N-S CENTERLINE OF THE SE1/4 AND THE E1/2 OF THE E1/2 OF THE E-W CENTERLINE OF SECTION 9. ALL CONTROLLING CORNERS WERE FOUND IN THE FIELD AS SET IN C.S. M94-34, C.S. M98-54, C.S. RM3-59 AND C.S. M92-57. THE WEST 1/16 CORNER AND THE EAST 1/16 CORNER BETWEEN SECTIONS 9 AND 16 WERE SET HALFWAY BETWEEN THE SOUTH 1/4 CORNER AND THE S.W. SECTION CORNER AND THE S.E. SECTION CORNER OF SECTION 9 RESPECTIVELY, AS SHOWN. THE C.E. 1/16 CORNER WAS SET HALFWAY BETWEEN THE EAST 1/4 CORNER AND THE CENTER 1/4 CORNER OF SECTION 9. A CLOSED MEANDER, WILD T-16 THEODOLITE AND DI-4L E.D.M., TRAVERSE WAS RUN ALONG ALL LINES TO BE BLAZED AND POSTED. OFFSETS WERE COMPUTED FROM THIS MEANDER TRAVERSE TO THE TRUE PROPERTY LINE. PROPERTY LINES WERE MARKED WITH RED PAINTED BLAZES, RED RIBBON, YELLOW INTERNATIONAL PAPER BOUNDARY LINE SIGNS ATTACHED TO 60" ALUMINUM POSTS AND FLUORESCENT ORANGE MAGNETIC MARKERS. ALUMINUM POSTS AND BURIED MAGNETIC MARKERS ARE REFERENCED BY A 4" x 6" ALUMINUM BOUNDARY LINE TAG NAILED TO A NEARBY TREE. TAG NOTES BEARING AND DISTANCE FROM TREE TO ALUMINUM POST OR BURIED MAGNETIC MARKER.

C.S. File M105-28 63/55