FILED

MAR 25 1988

COUNTY SURVEYOR
DOUGLAS COUNTY, ORE.

SURVEY FOR COR. RESTORATION

BLOCK 33, AMENDED PLAT OF SUTHERLIN

SE 1/4, SEC. 17 & SW 1/4, SEC. 16 T.25S., R.5W.W.M.
MARCH, 1988 SCALE 1"=50'

FOR: DARLENE B. LOOMIS
P.O. BOX 715
SUTHERLIN, OR 97479

BY: BAUGHMAN TECHNICAL SERVICE INC.
433 S.E. MAIN STREET
ROSEBURG, OR 97470
PHONE 673-0966

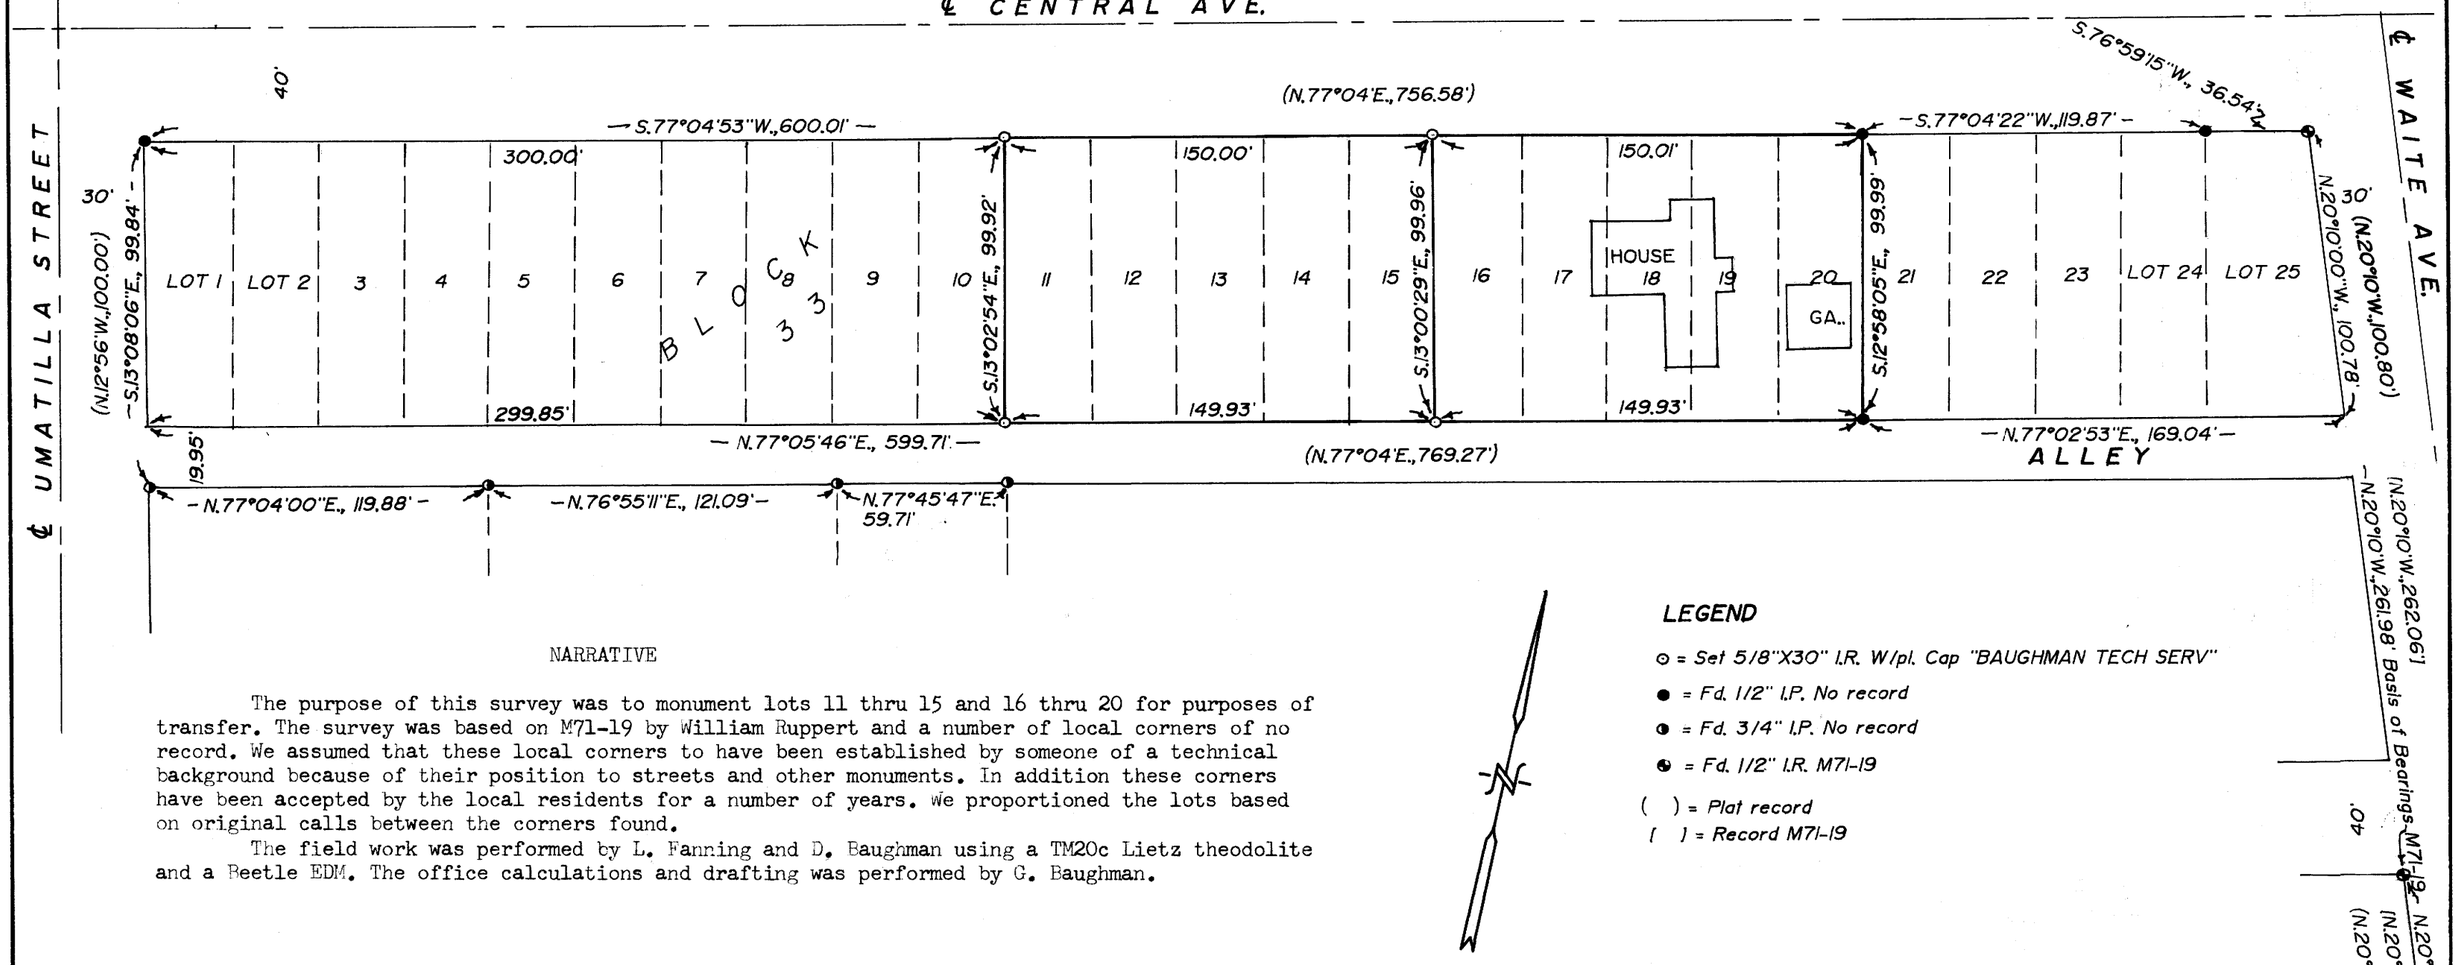

LEGEND

⊙ = Set 5/8"X30" I.R. W/pl. Cap "BAUGHMAN TECH SERV"
● = Fd. 1/2" I.P. No record
◑ = Fd. 3/4" I.P. No record
◕ = Fd. 1/2" I.R. M71-19
( ) = Plat record
[ ] = Record M71-19

NARRATIVE

The purpose of this survey was to monument lots 11 thru 15 and 16 thru 20 for purposes of transfer. The survey was based on M71-19 by William Ruppert and a number of local corners of no record. We assumed that these local corners to have been established by someone of a technical background because of their position to streets and other monuments. In addition these corners have been accepted by the local residents for a number of years. We proportioned the lots based on original calls between the corners found.

The field work was performed by L. Fanning and D. Baughman using a TM20c Lietz theodolite and a Beetle EDM. The office calculations and drafting was performed by G. Baughman.

REGISTERED
PROFESSIONAL
LAND SURVEYOR

Glenn L. Baughman

OREGON
JULY 10, 1973
GLENN L. BAUGHMAN
836

COUNTY SURVEYORS FILE DATA
DO NOT REMOVE FROM OFFICE

MAP FILE M-105-70

MAP FILE M-105-70