COUNTY SURVEYORS FILE DATA
DO NOT REMOVE FROM OFFICE

M106-44

LOT LINE ADJUSTMENT SURVEY FOR FRED EARWOOD

IN LOTS 25 THROUGH 30, BLOCK SIX, THIRD ADDITION TO CASCADE ESTATES, ALL LYING IN THE CITY OF SUTHERLIN AND THE NW1/4 OF SEC 15 & NE 1/4 OF SEC 16 T25S, R5W, W.M.

FILED
JUL 25 1988
COUNTY SURVEYOR
DOUGLAS COUNTY, OREGON

REGISTERED PROFESSIONAL LAND SURVEYOR
OREGON
JULY 12, 1968
DONALD A. BENTZ
839

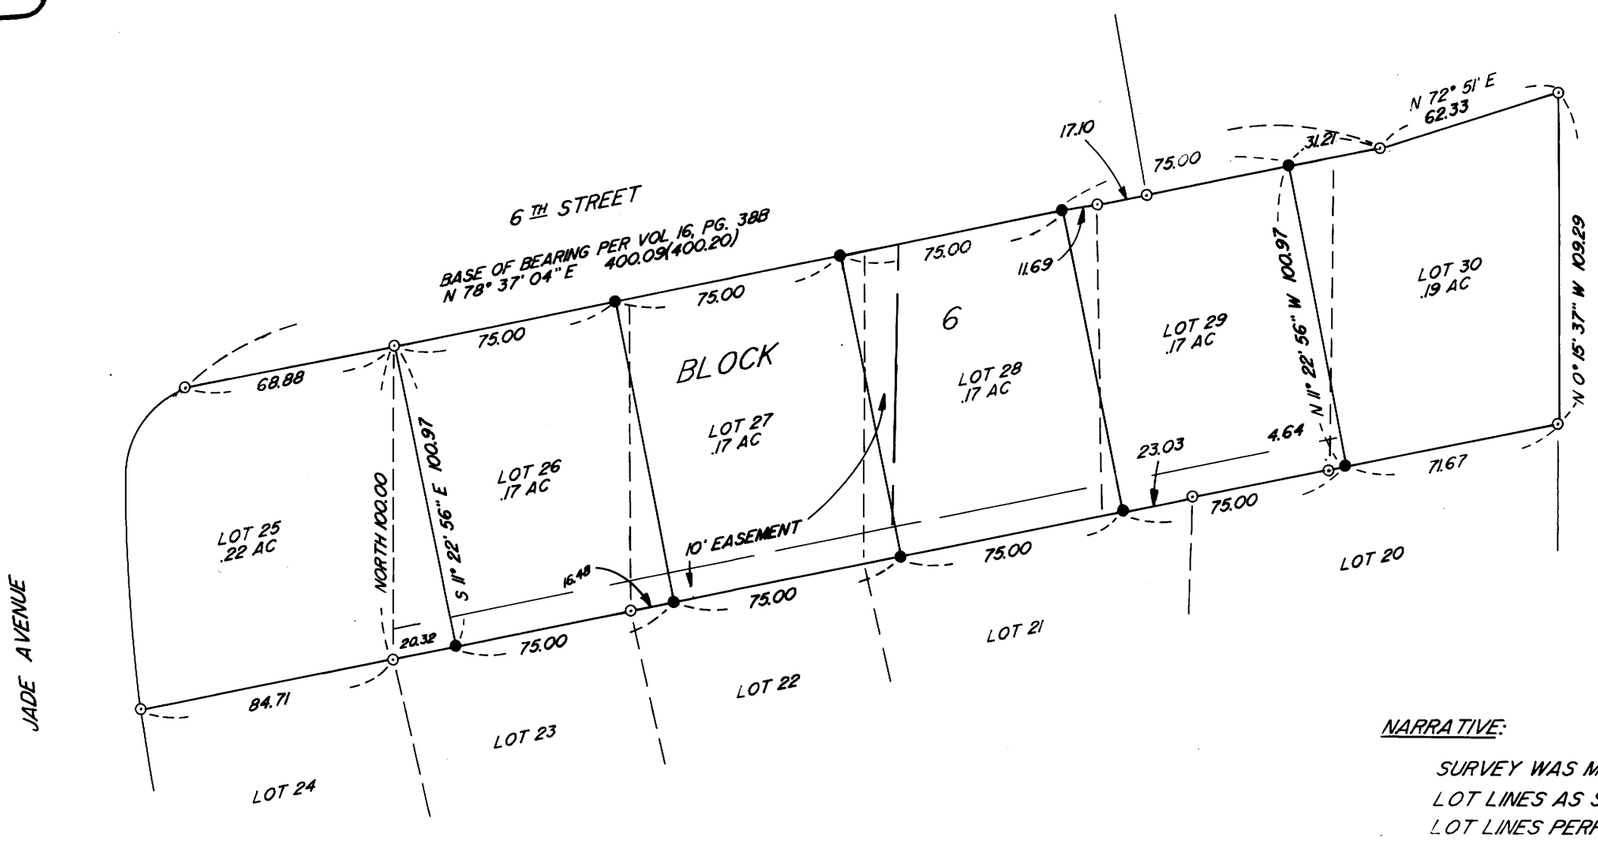

SCALE
1"=50'
JUNE 1988

LEGEND

○ — FD 5/8" IRON ROD UNLESS NOTED

● — SET 5/8" x 30" IRON ROD W/CAP MKD "BENTZ SURV. INC."

– – – — ORIGINAL LOT LINES PER PLAT

SURVEYOR

DONALD A. BENTZ INC.
P.O. BOX 901
WINCHESTER, OR. 97495

NARRATIVE:

SURVEY WAS MADE TO ADJUST LOT LINES AS SHOWN-MAKING LOT LINES PERPENDICULAR TO 6TH STREET

FIELD WORK:

B. BROWNING, M. HOLT USING WILD T-1 & RED 1 COMP. - D. DELATTE

(SEE M 107-4 for "SIGNED" MAP)

M106-44