Bk. 10 - Pg. 83A

M106-66A

A MAJOR LAND PARTITION FOR JOHN HANNAH IN SEC 15, T28S, R6W, W. M. DOUGLAS COUNTY

SEP 9 [illegible]

COUNTY SURVEYOR FOR DOUGLAS COUNTY [illegible]

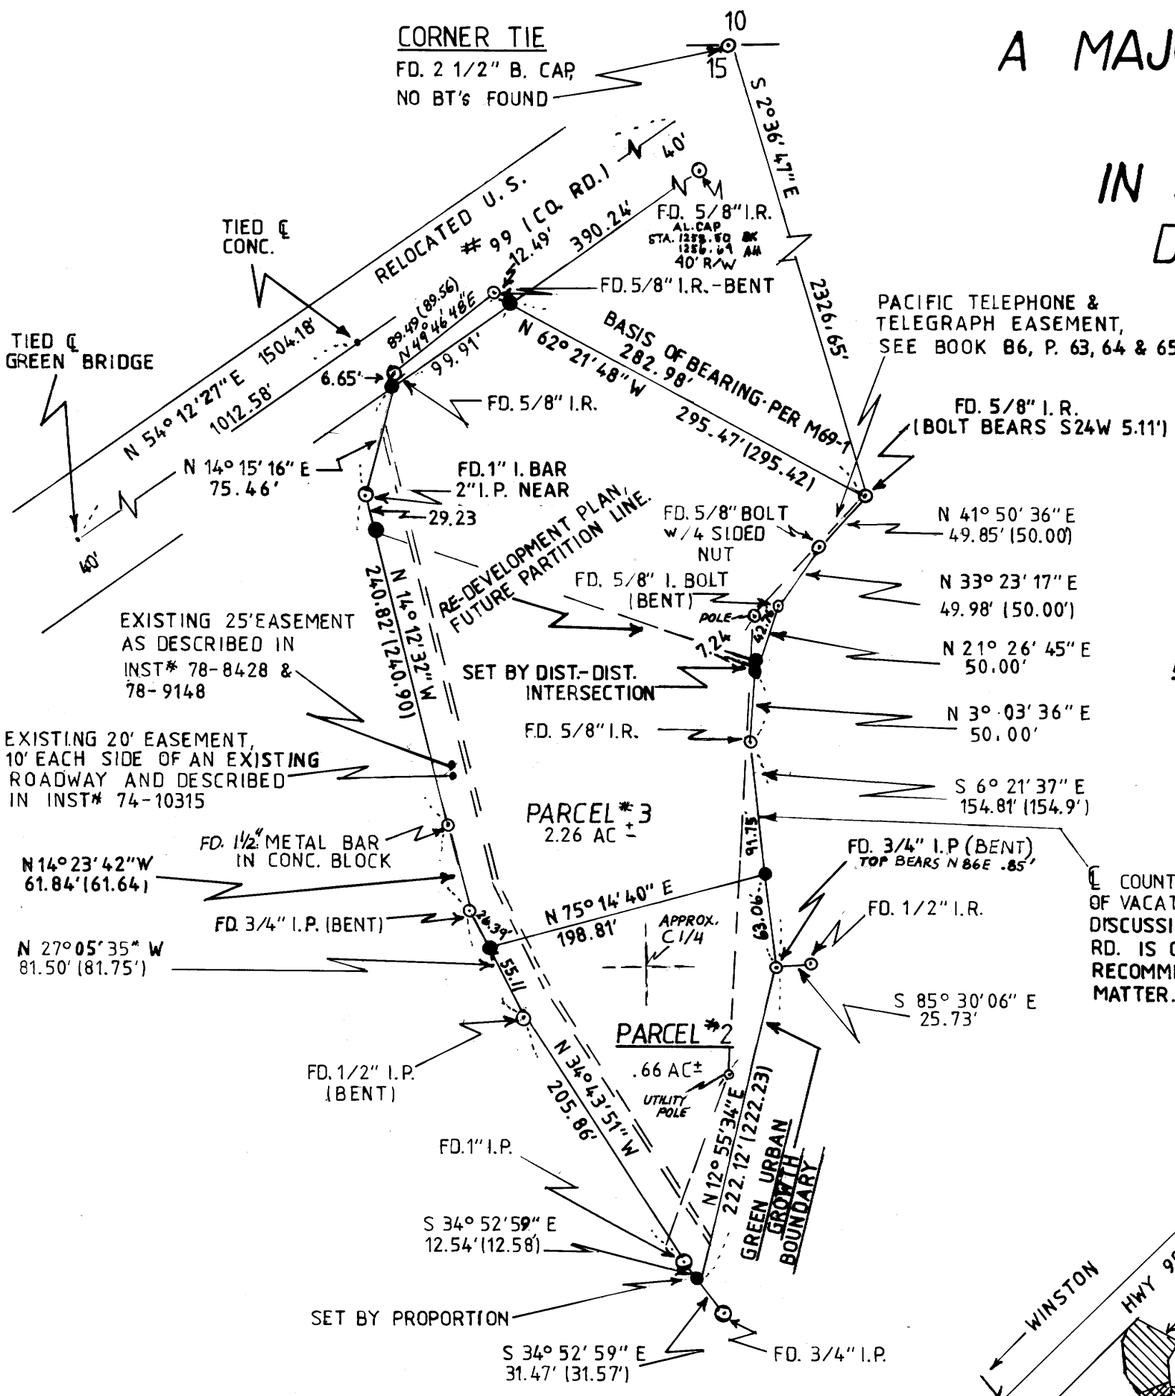

SURVEYED BY:

GREGORY D. LANG
P. O. BOX 1592
ROSEBURG, OR. 97470
(503) 679-5542

OWNER / PARTITIONER:

JOHN V. HANNAH
P. O. BOX 111
WINSTON, OR. 97496

SCALE: 1"=100'
JUNE 1988

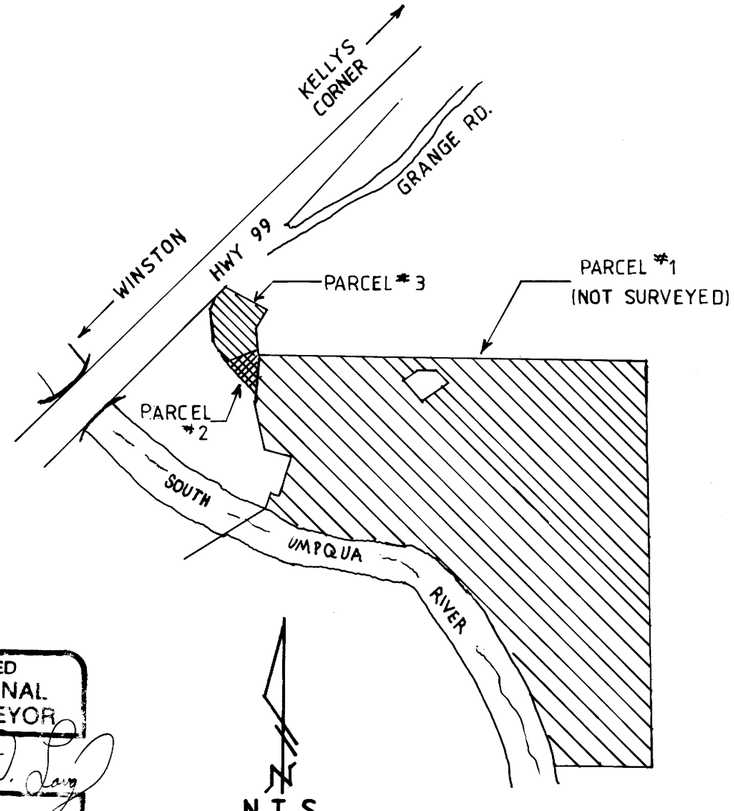

LEGEND:

⊙ — FOUND AS NOTED
● — SET 5/8" x 30" I.R. W/ PLASTIC CAP MKD. "LANG SURVEYING"
( ) — RECORD PER M69-1

NARRATIVE:

PERIMETER FOUND & ESTABLISHED PER M69-1 & M84-40 WITH THE EXCEPTION OF THE 40' COUNTY R/W CUTTING THROUGH THE NORTHWESTERLY SIDE

ZONING: PARCEL 1 - FG
PARCEL 2 & 3 - RS

SEWER: GREEN SANITARY

WATER: ROBERTS CREEK

EQUIP. USED: LIETZ TM6 & RED 1 EDM
FIELD CREW: JOHN PIKE & GREG LANG
COMPUTATIONS: GREG LANG
DRAFTING: BILL WARREN

REGISTERED PROFESSIONAL LAND SURVEYOR
Gregory D. Lang
OREGON
NOV 16, 1937
GREGORY D. LANG
1245

COUNTY SURVEYORS FILE DATA
DO NOT REMOVE FROM OFFICE

M106-66A