

(GLO - S 89°30' E, 40.2 chains)
BASIS OF BEARING
N 89°44'25" E

LEGEND

- Corner Monument Found
- Corner Set This Survey
- Aluminum Property Line Post
- Blazed Property Line
- ▲ Line Tree

NARRATIVE

The purpose of this survey was to locate and monument property corners and lines that define lands owned by International Paper Company.

The Basis of Bearing for this survey was the bearing of the line between the North East Section Corner and the North 1/4 Corner of Section 9. The bearing of this line was established in C.S. No. 60-12.

Property lines are blazed and monumented with a 6 ft aluminum property line post, at the locations specified on this plat. Magnetic markers are buried at the base of each set aluminum post. Posts are set to within ± 1 foot of true line.


Corners monumented during this survey were set per standard subdivision procedures outlined in the BLM Manual of Surveying Instructions, 1973 Edition.

This survey was performed using a NIKON NTD-2 semi total station.

Bearings and distances to bearing trees were measured with a semi total station and taken to the center of the tree at the top of the root crown. Points of measure on bearing trees are marked with a large nail.

Caps set are marked per BLM Manual of Surveying Instructions 1973 Edition and stamped with LS 1091.

Corners set in this survey consisted of a 3-1/4" Aluminum Cap set on a 3/4" X 30" Aluminum Rod.

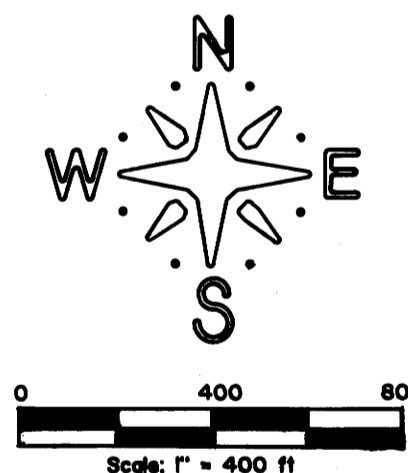

RECORD OF SURVEY
for INTERNATIONAL PAPER COMPANY
by WARD NORTHWEST INC.
in Section 9, T.21S., R.11W., W.M.
Douglas County, Oregon - 11/22/88

REGISTERED
PROFESSIONAL
LAND SURVEYOR

Robert B. Ward, Jr.

OREGON
ROBERT B. WARD, JR.
JULY 30 1976
1091

WARD NORTHWEST INC.
P.O. Box 105
Florence, Oregon 97439

COUNTY SURVEYORS FILE DATA
DO NOT REMOVE FROM OFFICE

(A) 1/4 Corner - S4,S9

FND: 2-1/2" Brass Cap (County Surveyors Office 1967) with the following accessories,
15-1/2" Fir bears N 09°45' E, 23.2 ft heated face.
17-1/2" Fir bears N 55°15' W, 11.6 ft heated face.
16" Fir bears S 09°30' E, 49.7 ft heated face.

(B) E 1/16 Corner S4,S9

SET: 3-1/4" Aluminum Cap with the following accessories,
24" Fir bears S 77° W, 49.6 ft scribed "E1/16 S9 BT"
19" Fir bears S 13° W, 53.7 ft scribed "E1/16 S9 BT"

(C) Section Corner - S3,S4,S9,S10

FND: 2-1/2" Brass Cap (County Surveyors Office 1977) with the following accessories,
25" Spruce bears N 23°15' E, 38.0 ft heated face.
19" Fir snag bears S 25° E, 11.9 ft partially heated face.
30" Fir bears S 2° E, 15.2 ft heated face.
30" Maple bears S 55°45' W, 39.2 ft heated face.
60" Fir bears N 70° W, 24.6 ft heated face.

(D) CN 1/16 Corner - S9

SET: 3-1/4" Aluminum Cap with the following accessories,
26" Fir bears S 86°30' E, 53.4 ft scribed "CN/16 S9 BT"
30" Hemlock bears S 26°30' W, 8.8 ft scribed "CN/16 S9 BT"

(E) NE 1/16 Corner - S9

SET: 3-1/4" Aluminum Cap with the following accessories,
39" Fir bears N 4° E, 37.9 ft scribed "NE1/16 S9 BT"
13" Alder bears N 82°15' W, 15.7 ft bark scribed "NE1/16 S9 BT"

(F) 1/4 Corner - S8,S9

FND: 2-1/2" Brass Cap (County Surveyors Office 1967) with the following accessories,
9" Fir bears S 06° E, 13.4 ft partially heated face - scribing visible
11" Fir bears N 87° W, 20.4 ft heated face.
18" Hemlock bears N 06° W, 103.3 ft heated face.
11" Alder bears N 25° E, 42.2 ft heated face.

(J) 1/4 Corner - S9,S16

FND: 1" Iron Rod (C.S. 55-30) with the following accessories,
40" Fir Stump bears S 60°30' E, 334.0 ft
Power Pole 10 - B bears S 73° E, 7.0 ft

15
Record shows Power Pole 10 - B
15

(G) CW 1/16 Corner - S9

SET: 3-1/4" Aluminum Cap with the following accessories,
10" Fir bears N 14° E, 14.6 ft scribed "CW1/16 S9 BT"
9" Maple bears S 69°30' E, 10.1 ft bark scribed "CW1/16 S9 BT"

(H) C1/4 Corner - S9

SET: 3-1/4" Aluminum Cap with the following accessories,
8" Fir bears N 29°15' W, 38.2 ft scribed "C1/4 S9 BT"
12" Maple bears N 54°30' E, 64.5 ft scribed "C1/4 S9 BT"

(I) Meander Corner - S9,S10 RM

FND: 3-1/4" Aluminum Cap (C.S. No. 63-59) with the following accessories,
8" Alder bears N 73° W, 15.9 ft bark scribed "MC S9 BT"
12" Alder bears N 59° E, 53.3 ft bark scribed "MC S10 BT"

