MAP FILE M107 - 64

COUNTY SURVEYORS FILE DATA
DO NOT REMOVE FROM OFFICE

SURVEY FOR DEED DESCRIPTIONS
IN LOTS 16 & 17, BL. 2, GLENGARRY FRUITLANDS
IN THE N.E. 1/4 of SEC. 19 & THE S.E. 1/4 of SEC 18,
T. 28S., R. 5 W.W.M.
FOR HOWARD CAMPBELL
by BRUCE ROGERS
200 N.E. PATTERSON
ROSEBURG, OR.
Oct., 1988 — 1" = 100'

FILED
MAR 23 1989
COUNTY SURVEYOR
DOUGLAS COUNTY, ORE.

● – Fd. 5/8" I.R. (or as noted)
Co. R/W Pins, M20-20, C.S. 55/297 & M105-1
○ – Set 5/8" X 30" I.R. with Caps Marked L.S. 660

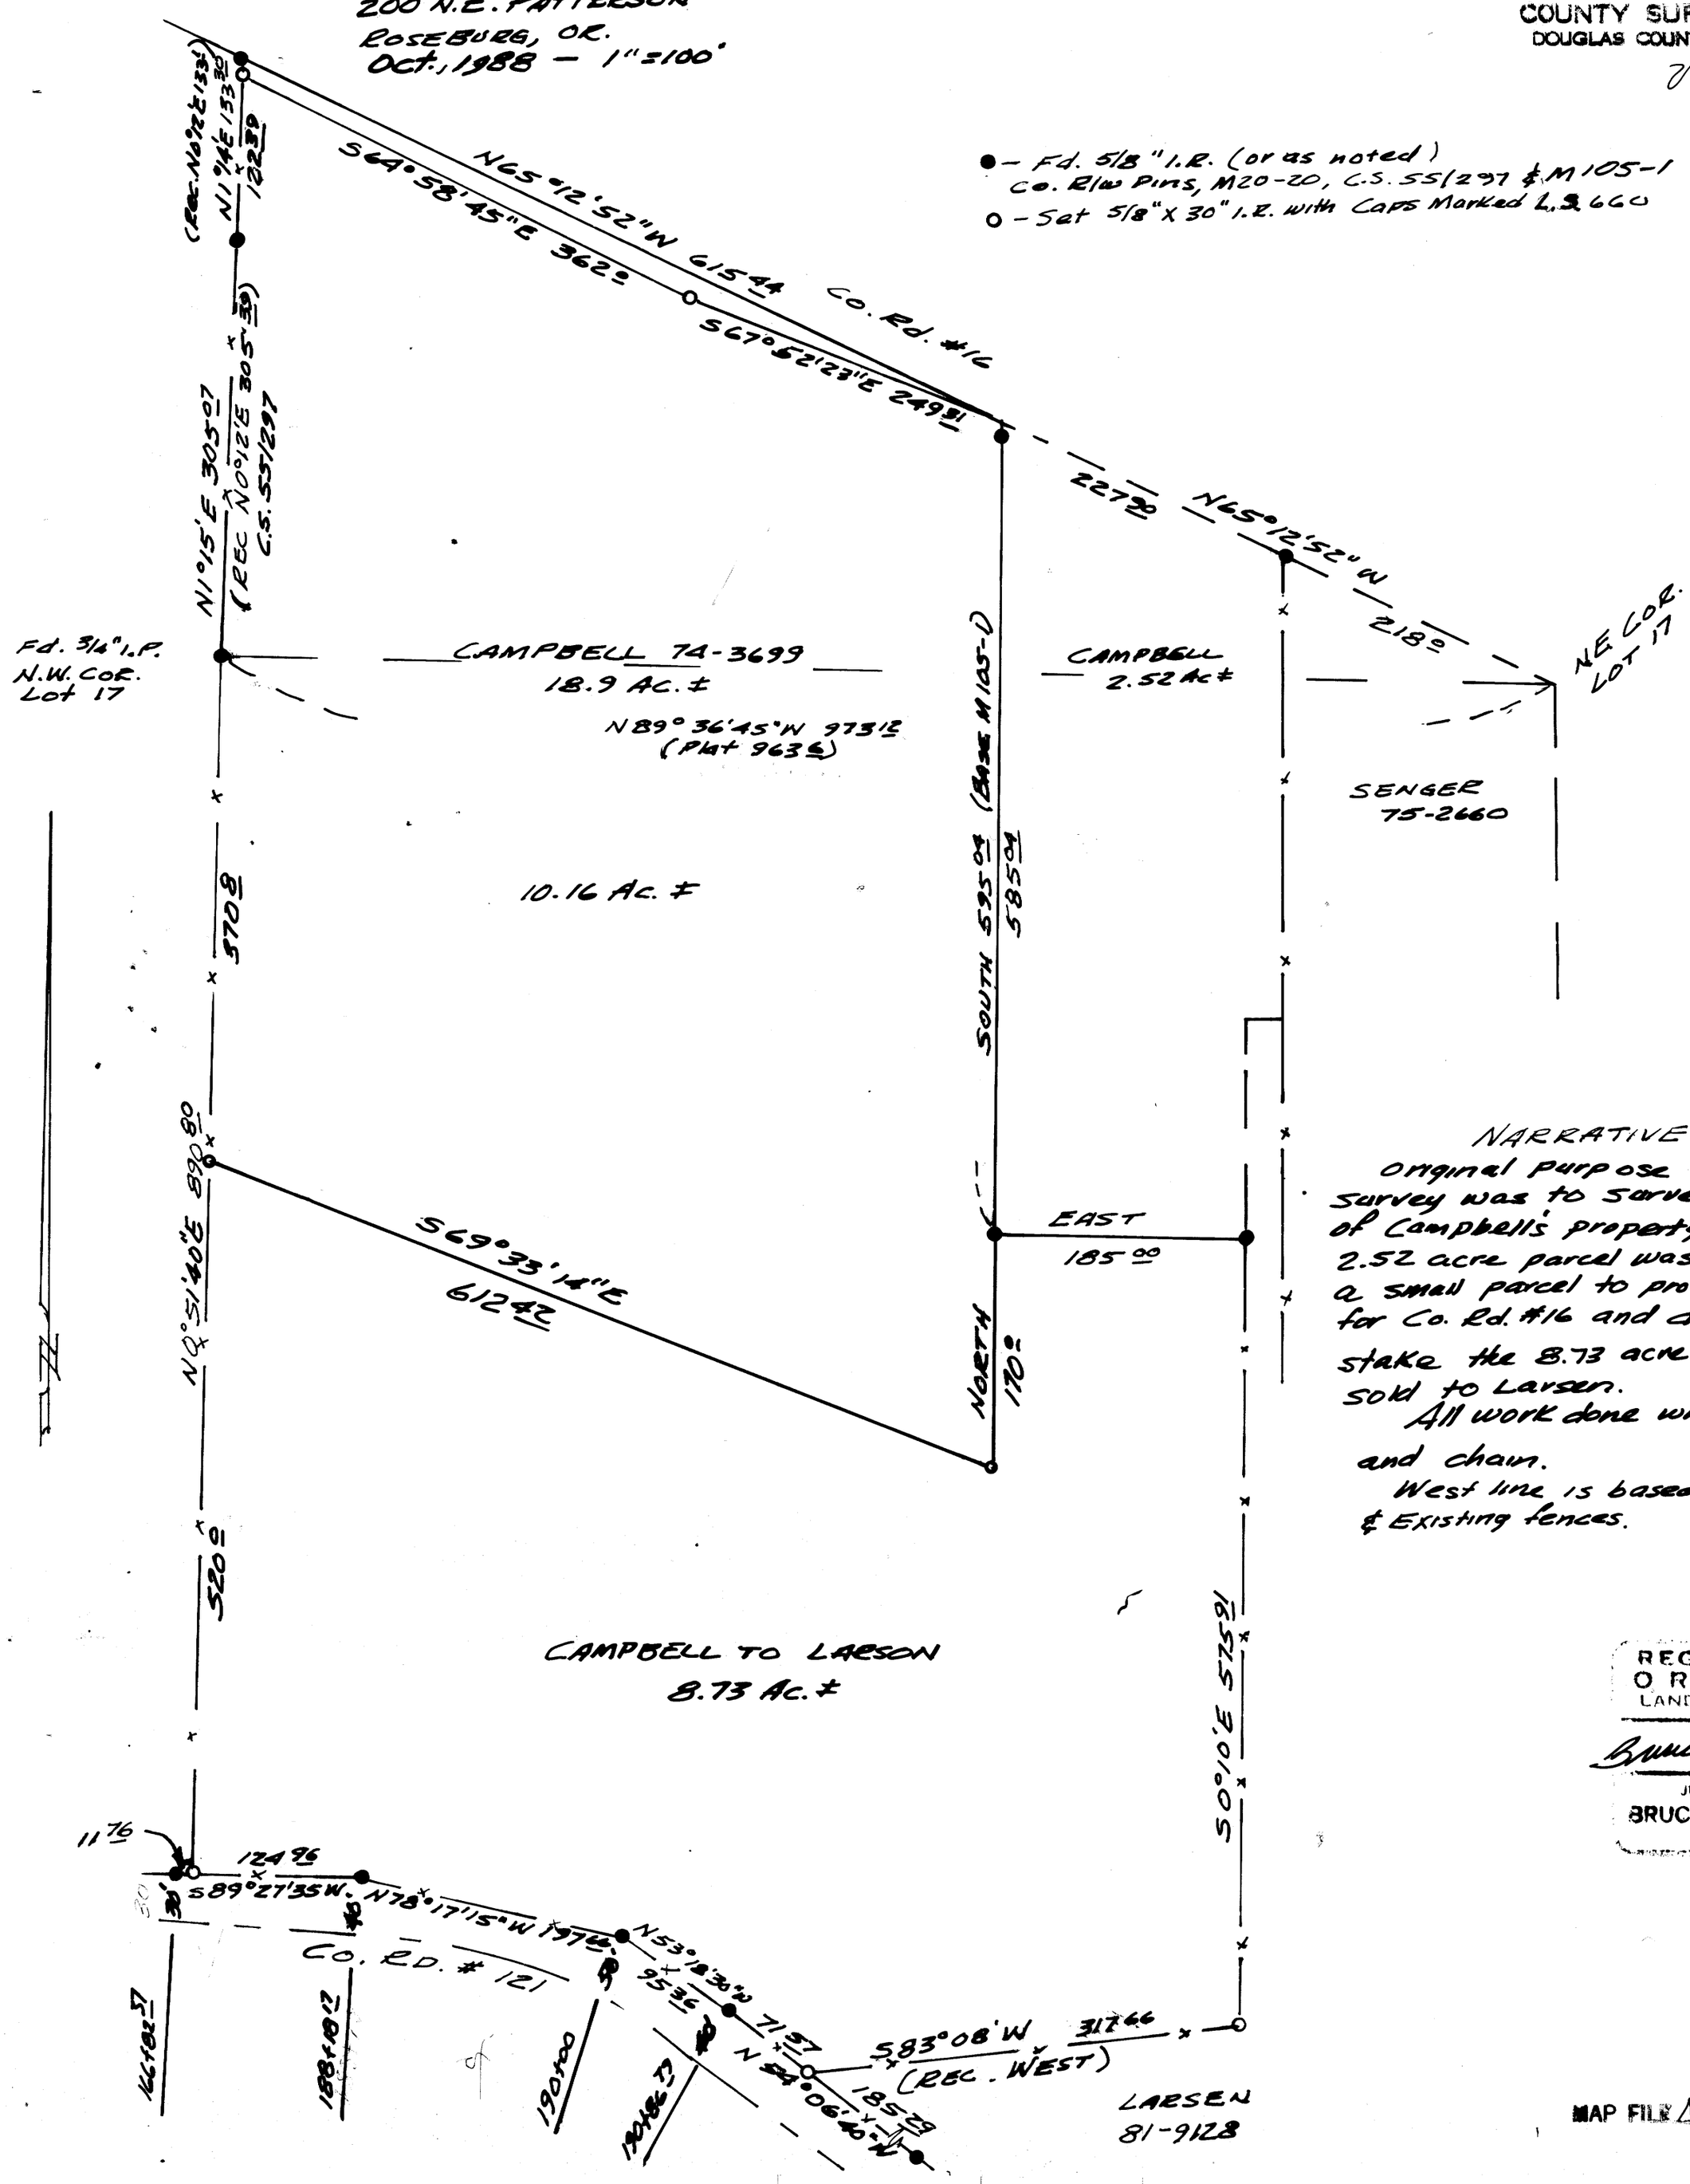

NARRATIVE

Original purpose of this survey was to survey the remainder of Campbell's property (after the 2.52 acre parcel was cut off), stake a small parcel to provide a 30' R/W for Co. Rd. #16 and describe and stake the 8.73 acre parcel Campbell sold to Larsen.

All work done with transit and chain.

West line is based on C.S 55/297 & Existing fences.

REGISTERED
OREGON
LAND SURVEYOR
Bruce R. Rogers
JULY 10, 1964
BRUCE R. ROGERS
660

MAP FILE M107 - 64