COUNTY SURVEYORS FILE DATA
DO NOT REMOVE FROM OFFICE

BK. 11 - Pg. 12A

MINOR LAND PARTITION
PART OF LOT 85, MELROSE ORCHARDS
IN THE N.E. 1/4 of SEC. 35, T.26S., 7W.W.M.
Nov., 1989

LEGAL OWNER & PARTITIONER:
ROY THOMPSON
1889 Elgarose Rd.
Roseburg, Or.

SURVEYED by BRUCE ROGERS
200 N.E. PATTERSON ST
ROSEBURG, OREGON

WATER SUPPLY: Umpqua Basin Water Ass'n.

SEWER - SEPTIC TANKS

ZONE - 5R

Note - Melrose Dr. Bearings & distances from M29-43

FILED
NOV 21 1989
COUNTY SURVEYOR
DOUGLAS COUNTY, ORE.

REGISTERED OREGON LAND SURVEYOR
Bruce R. Rogers
JULY 10 1964
BRUCE R. ROGERS
660

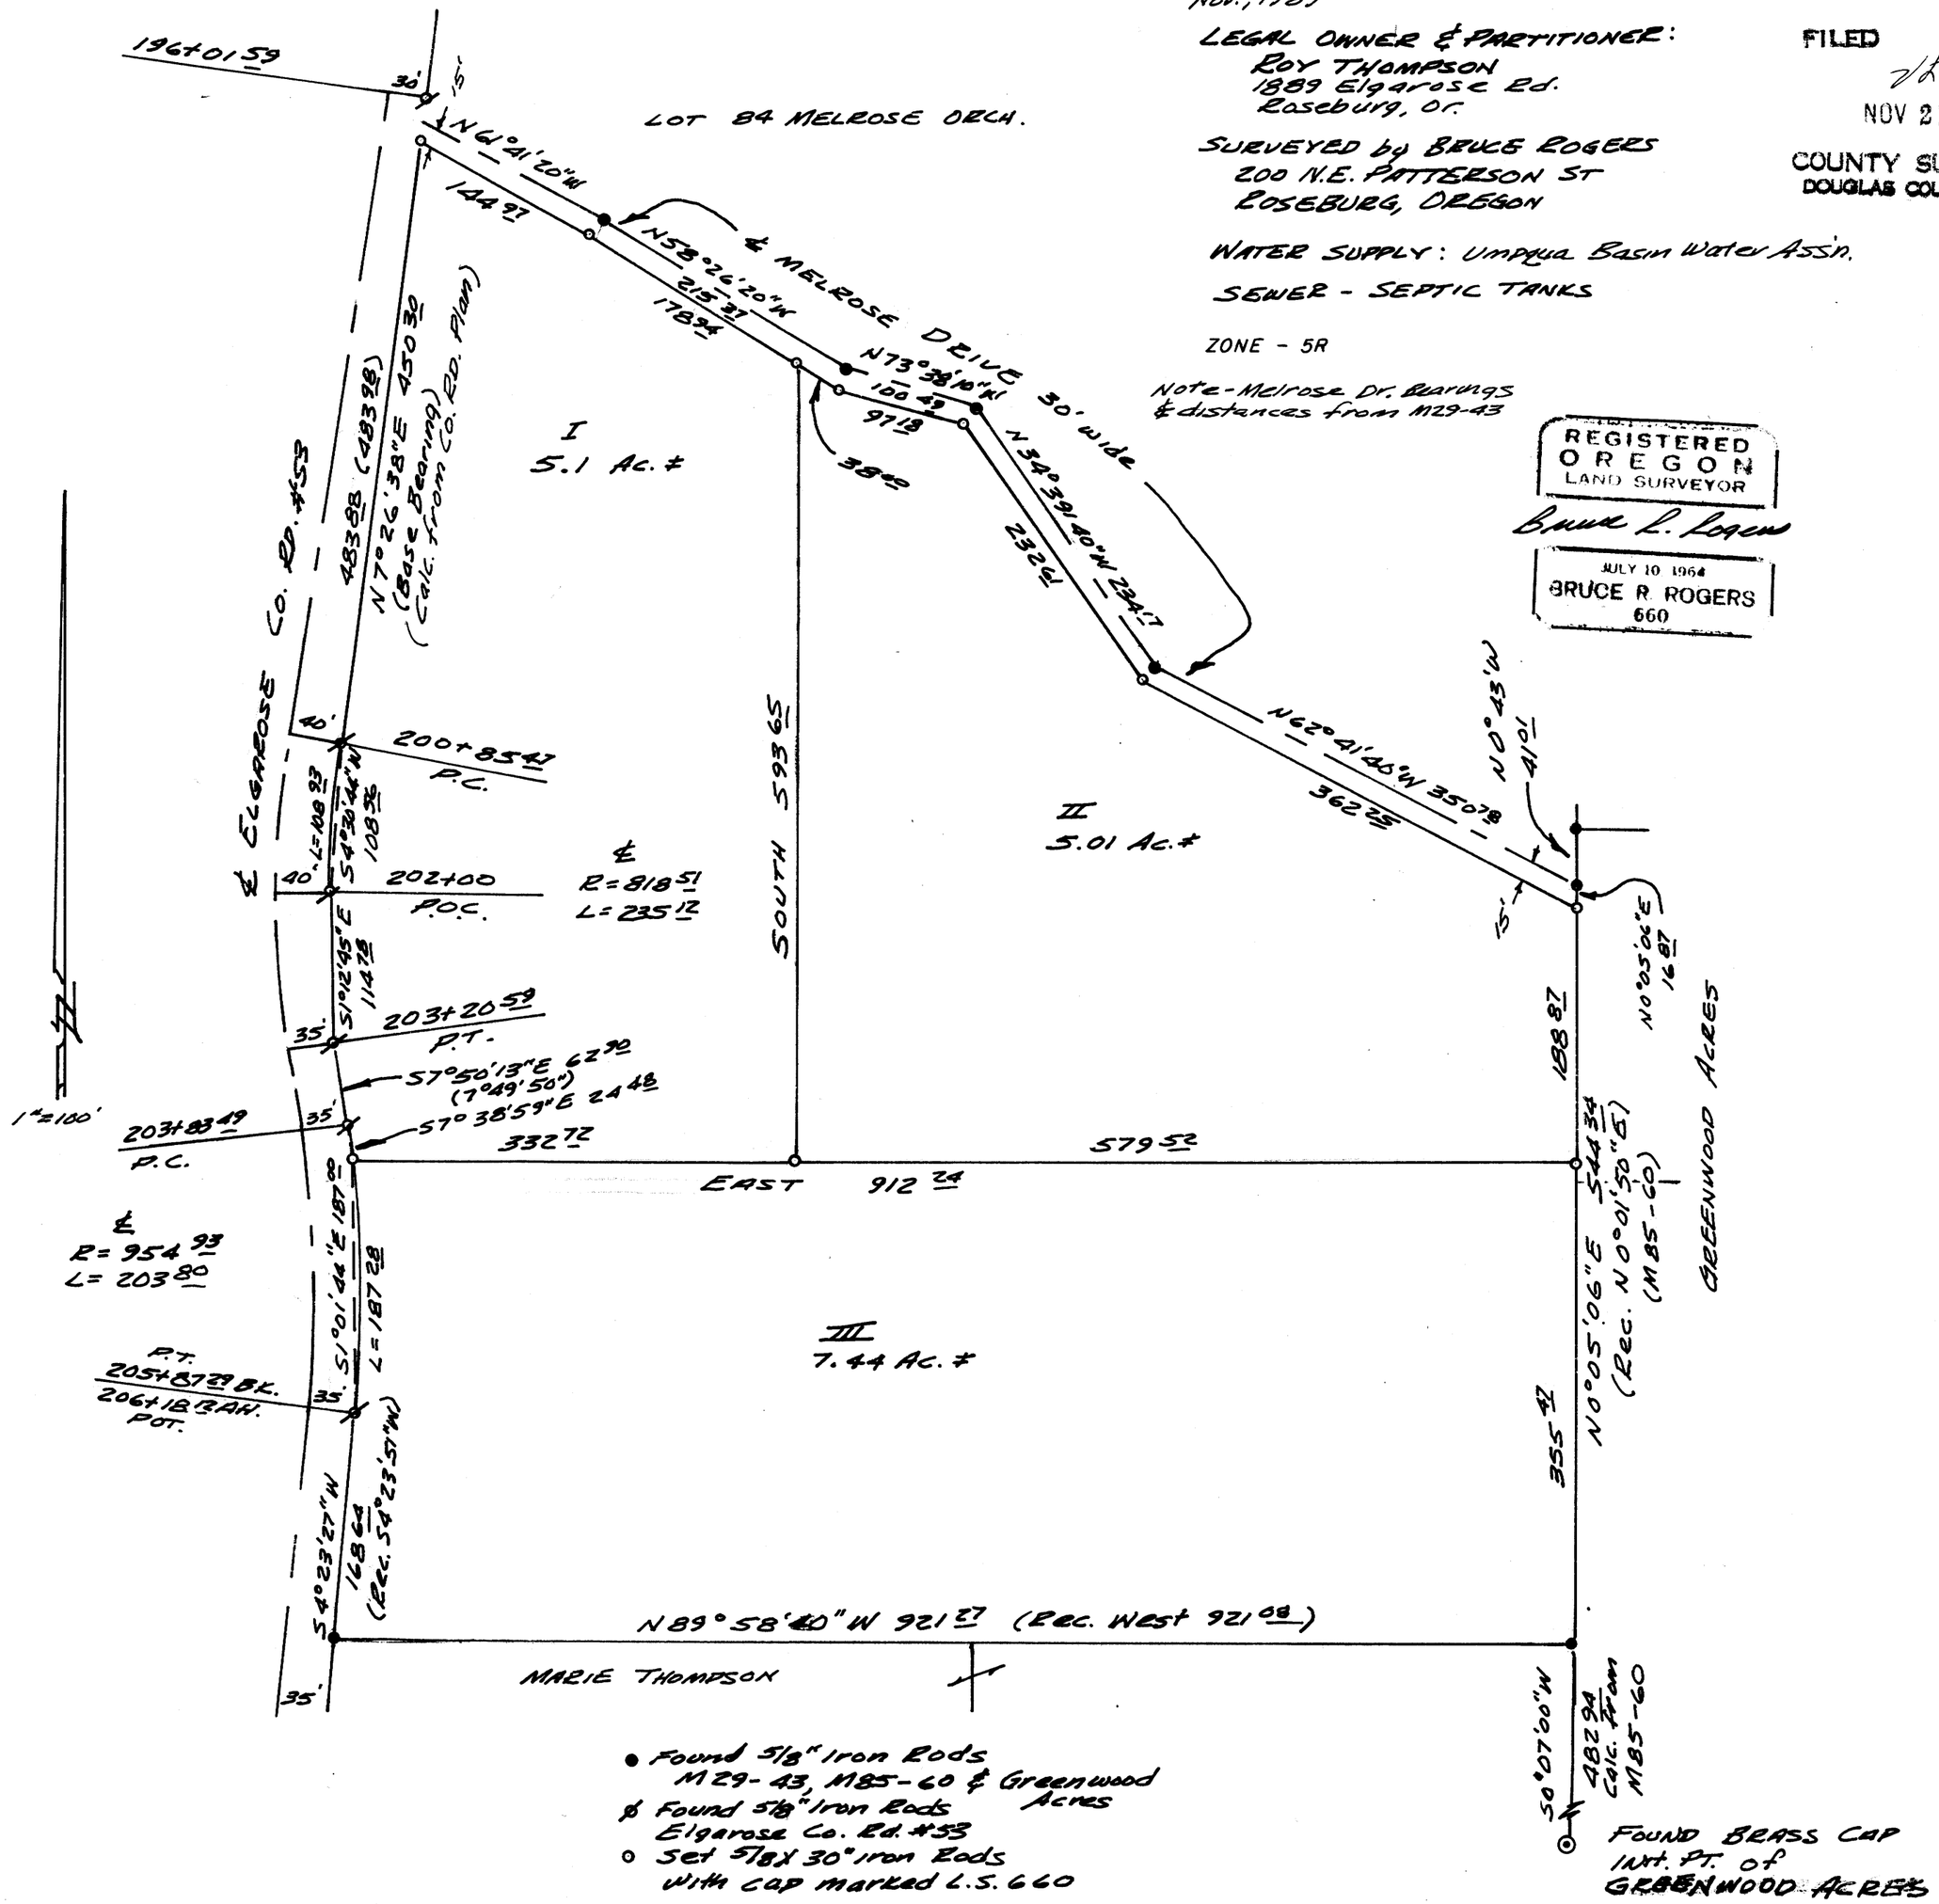

● Found 5/8" Iron Rods M29-43, M85-60 & Greenwood Acres
ø Found 5/8" Iron Rods Elgarose Co. Rd. #53
○ Set 5/8 X 30" Iron Rods with cap marked L.S. 660

MAP FILE M109-12A

MAP FILE M109-12A