RESURVEY OF LOTS 4 & 5 IN D.L.C. NO. 40
SECTION 9, T. 22S., R. 9W., W.M. DOUGLAS CO. ORE.

FILED 2/2

FEB 23 1990 TF

COUNTY SURVEYOR
DOUGLAS COUNTY, ORE.
TF

MAP FILE M42-40 - 52

CERTIFICATION:

I HEREBY CERTIFY THAT THE PLAT AND NOTES HEREON ARE A CORRECT REPRESENTATION OF THE SURVEY PERFORMED DURING THE MONTHS OF AUG.- DEC. 1989 AND IS IN ACCORDANCE WITH THE STATUTES OF THE STATE OF OREGON.

Philip R. Ekelund

PHILIP R. EKELUND PLS 1077 ORE.
900 KADORA DR. NORTH BEND, ORE. 97459
(503) 756-2764

PURPOSE: THE PURPOSE OF THIS SURVEY WAS TO RE-ESTABLISH THE LINE COMMON TO LOTS 4 & 5 IN THE SUBDIVISION OF THE Wm. GOLDEN D.L.C. #40, LOCATED IN SEC. 9 OF T.22 S. R.9 W. W.M. THE WESTERLY CORNER PIN HAD BEEN DISTURBED DURING LAND CLEARING OPERATIONS AND WAS FOUND BADLY BENT. THE OWNERS OF LOTS 4 & 5 STATED THAT THE BENT IRON ROD HAD BEEN DISTURBED AND WAS NO LONGER IN IT'S ORIGINAL POSITION. THE EASTERLY IRON ROD HAS BEEN LOST, SEARCHES BY THE FIELD CREW FOUND NO EVIDENCE OF THE ORIGINAL CORNER.

THE MONUMENTATION CONTROL TRAVERSE WAS A CLOSED LOOP HAVING A CLOSURE ACCURACY ABOVE 1:26,000 FT. THE ORIGINAL CORNERS WERE RE-ESTABLISHED BY PROPORTIONAL MEASUREMENT FROM ORIGINAL MONUMENTS AS FOUND IN THE FIELD.

EQUIPMENT USED: TOPCON GTS-2R 6 SECOND TOTAL STATION, H-P 41C CALCULATOR AND H-P 86 COMPUTER.

ASSISTING PERSONNEL WERE: PAUL DAILEY CREW CHIEF; JACK DAILEY, CHAINMAN; PROFESSIONAL SURVEYOR, PHILIP R. EKELUND.

HISTORY OF SURVEYS:

THIS SURVEY IS A RETRACEMENT OF A PORTION OF A SUBDIVISION PERFORMED BY RICHARD J. HINTZ, OCT. 11, 1971

LEGEND:

- ● FOUND 5/8" I.R.
- ○ SET 5/8" x 42" I.R.P.C. MARKED PLS 1077
- ⊕ FOUND 3/4" I.P.

BASIS OF BEARING: M42-40 (BRG. - DIST. HINTZ 1971)

DATE: 12-28-1989

SCALE: 1" = 100'

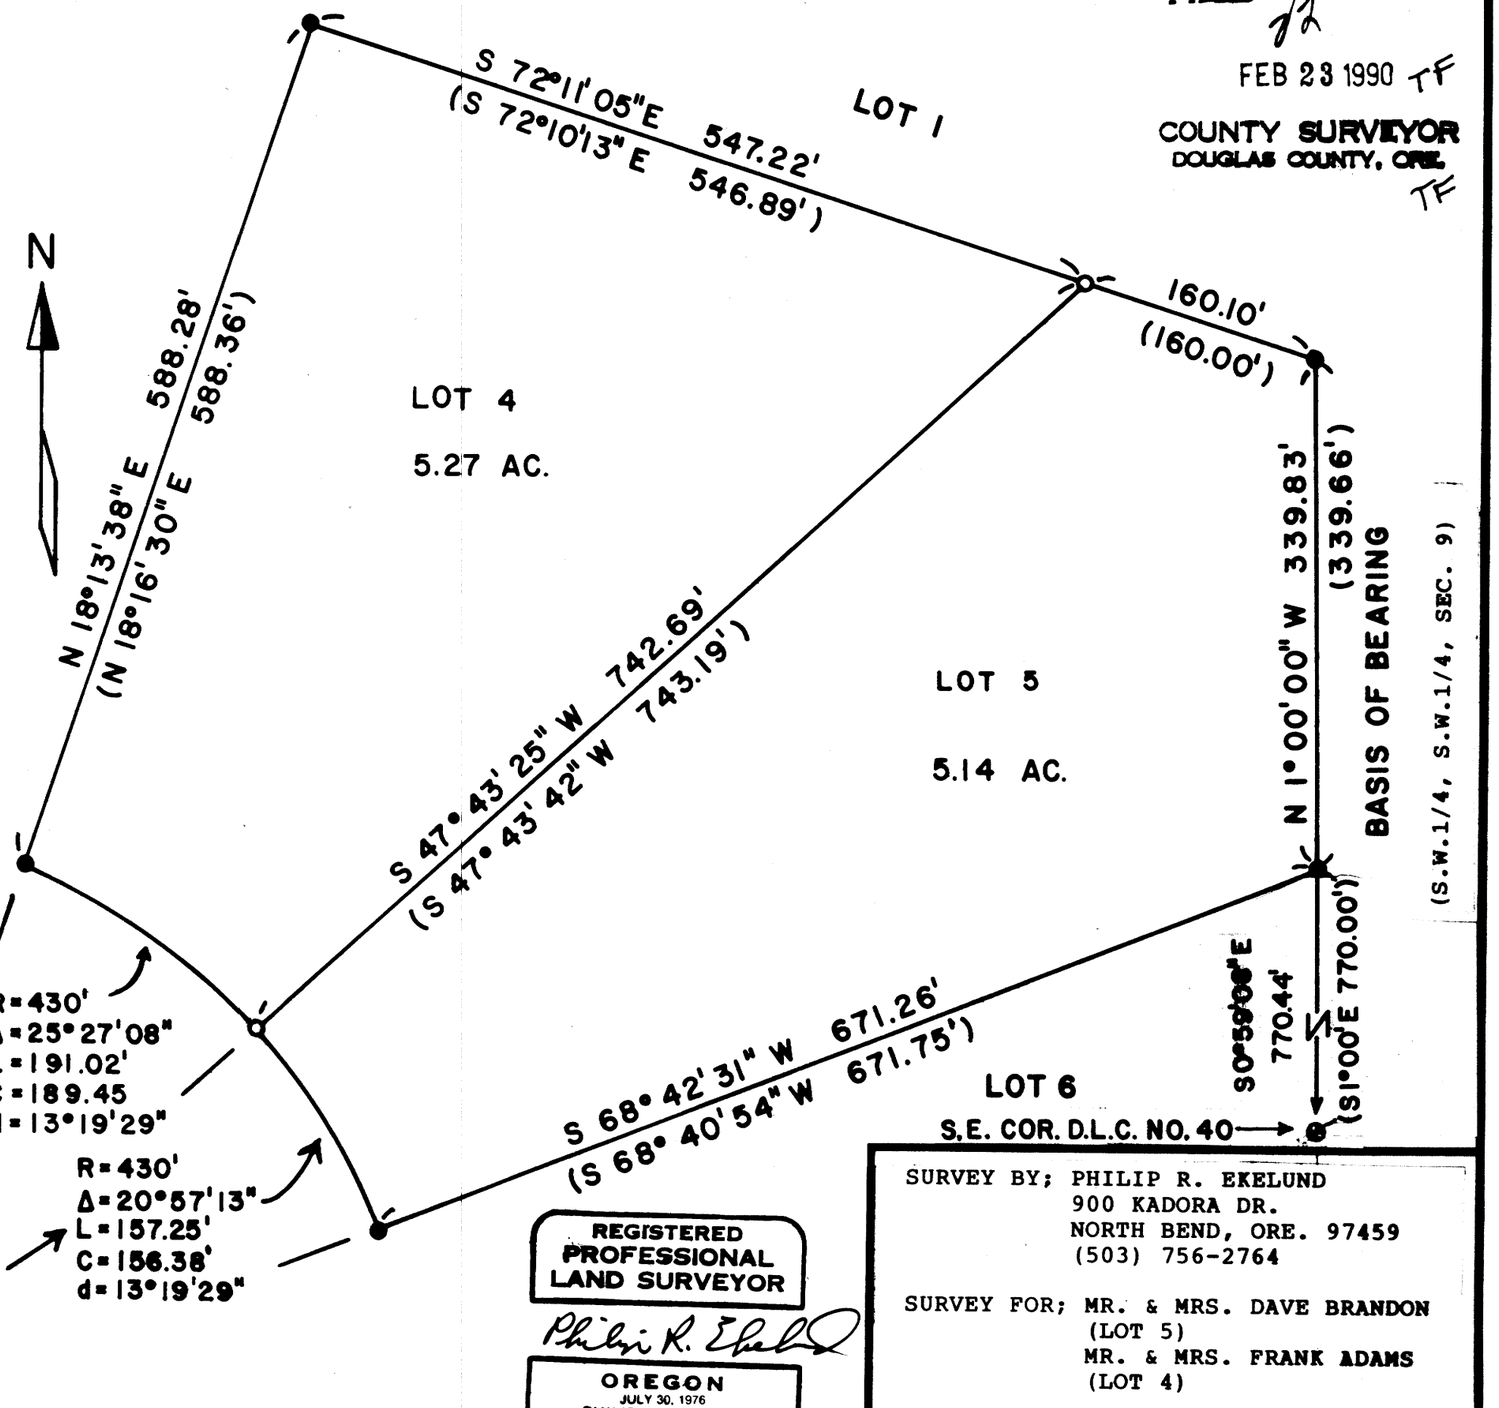

REGISTERED PROFESSIONAL LAND SURVEYOR

Philip R. Ekelund

OREGON
JULY 30, 1976
PHILIP R. EKELUND
#1077

SURVEY BY; PHILIP R. EKELUND
900 KADORA DR.
NORTH BEND, ORE. 97459
(503) 756-2764

SURVEY FOR; MR. & MRS. DAVE BRANDON
(LOT 5)
MR. & MRS. FRANK ADAMS
(LOT 4)

COUNTY SURVEYORS FILE UNIT
DO NOT REMOVE FROM OFFICE

MAP FILE M42-40 - 52