# PROPERTY SURVEY FOR DEED DESCRIPTION IN LOT 2, BLOCK 1, PLAT C, SUTHERLIN LAND & WATER CO, IN THE N.E. 1/4 OF SEC. 20, T.25S., R.5W., W.M. DOUGLAS COUNTY, OREGON

COUNTY SURVEYORS FILE DA
DO NOT REMOVE FROM OFFIC

FILED
APR 19 1990
COUNTY SURVEYOR
DOUGLAS COUNTY, ORE.

**FOR** · RANDY & KATHERINE BOYER

**BY** · ROBERT L. DOLAN
RT. 1 BOX 1820
SUTHERLIN, OR.

**SCALE** · 1" = 50'

**DATE** · MARCH, 1990

**Legend** · • SET 5/8" x 30" IRON ROD W/CAP (LS 1076)
○ FND. 5/8" IRON ROD OR AS NOTED

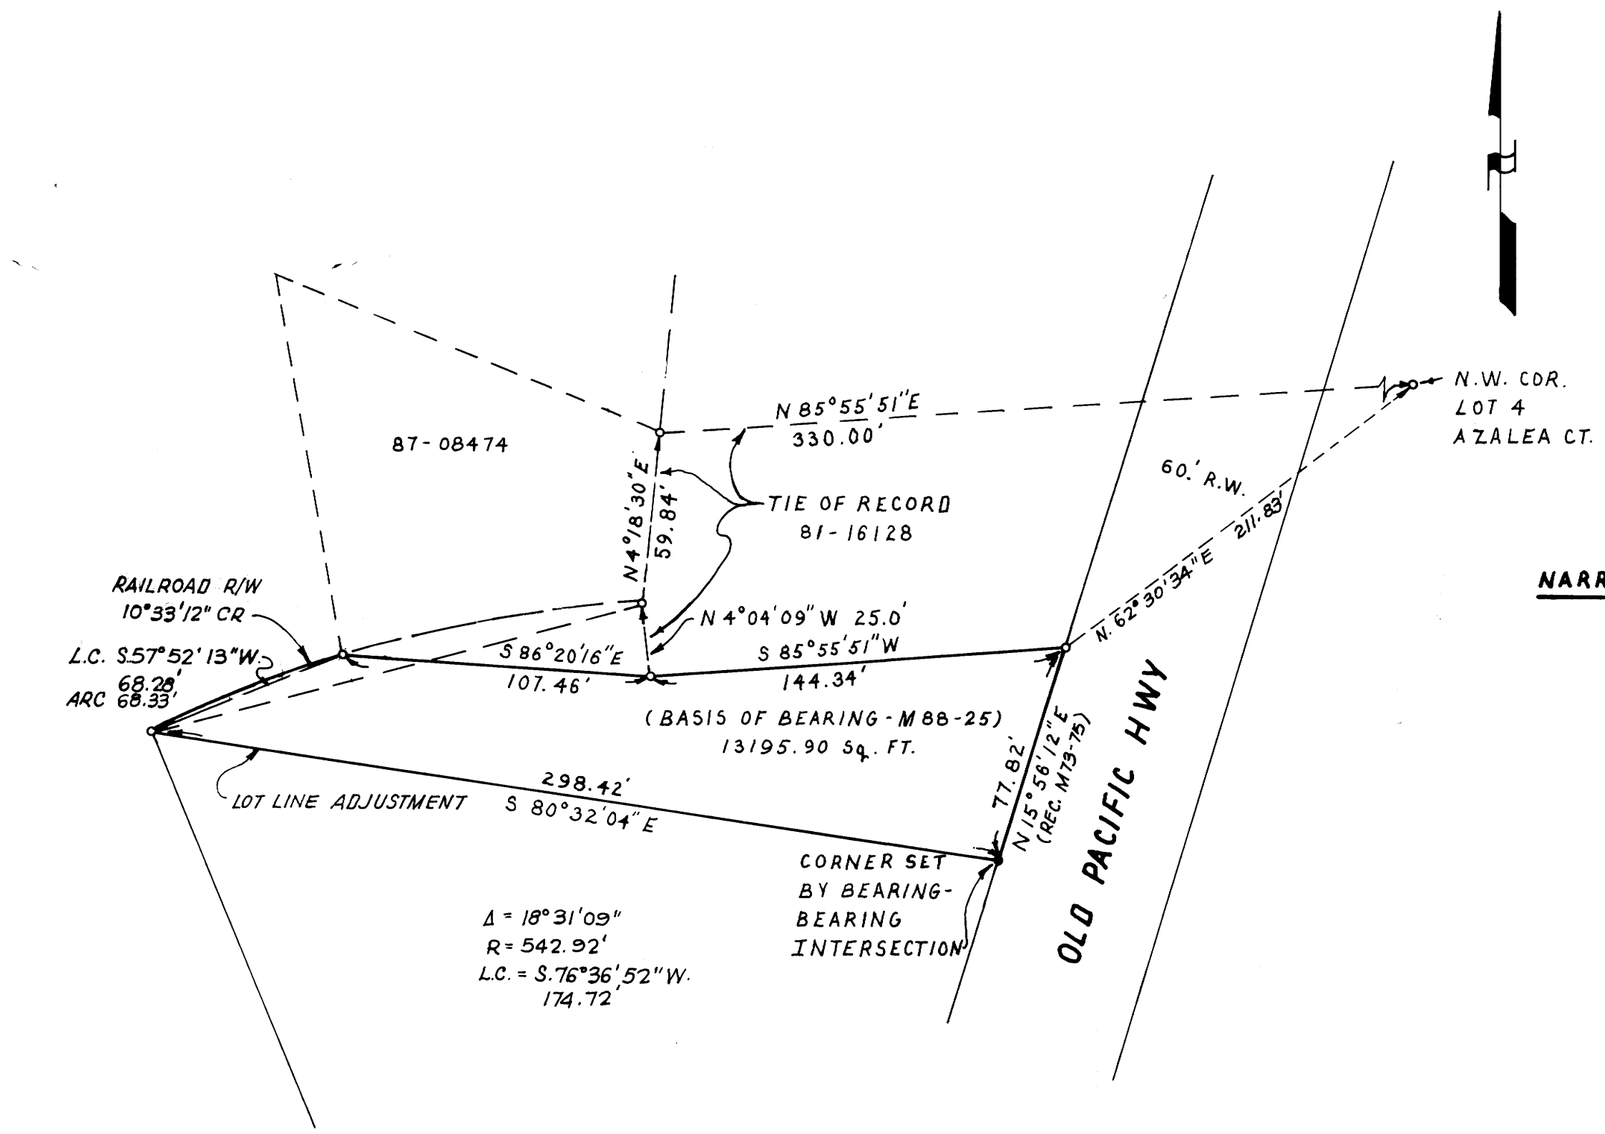


**NARRATIVE** · PINS SET FROM EXISTING PINS & DEEDS USING THEODOLITE & E.D.M.. PARCEL TO ADJOIN PARCELS DESCRIBED IN DOUGLAS COUNTY DEED RECORD NO. 81-16128 AND 87-08474.

REGISTERED
PROFESSIONAL
LAND SURVEYOR

Robert L. Dolan

OREGON
July 30, 1976
ROBERT L. DOLAN
1076

M109-78

M109-78