N.W. CORNER SECTION 6

FD. 1965 DOUGLAS COUNTY BRASS CAP AND MARKED STONE
16" FIR STUMP, N51°W, 5.7' (NO MARKS), 1855 B.T.
24" FIR STUMP, N74°E, 7.1' (NO MARKS), 1855 B.T.
6" FIR SNAG, S46°W, 4.3' (SCAR VIS.), 1965 B.T.
8" FIR, S22°E, 23.2' (SCAR VIS.), 1965 B.T.
8" FIR, S89°E, 17.2' (SCAR VIS.), 1965 B.T.
9" FIR STUMP, N03°W, 6.9' (SCAR VIS.), 1965 B.T.

NORTH 1/4 CORNER SECTION 6

FD. 1968 DOUGLAS COUNTY BRASS CAP
24" FIR, N18°E, 14.2' (SCAR VIS.), 1958 B.T.
60" FIR STUMP, S37°W, 54.2' (SCAR VIS.), 1958 B.T.
14" FIR STUMP, S56°W, 55.3' (SCAR VIS.), 1968 B.T.
20" FIR, N33°W, 16.3' (SCAR VIS.), 1968 B.T.

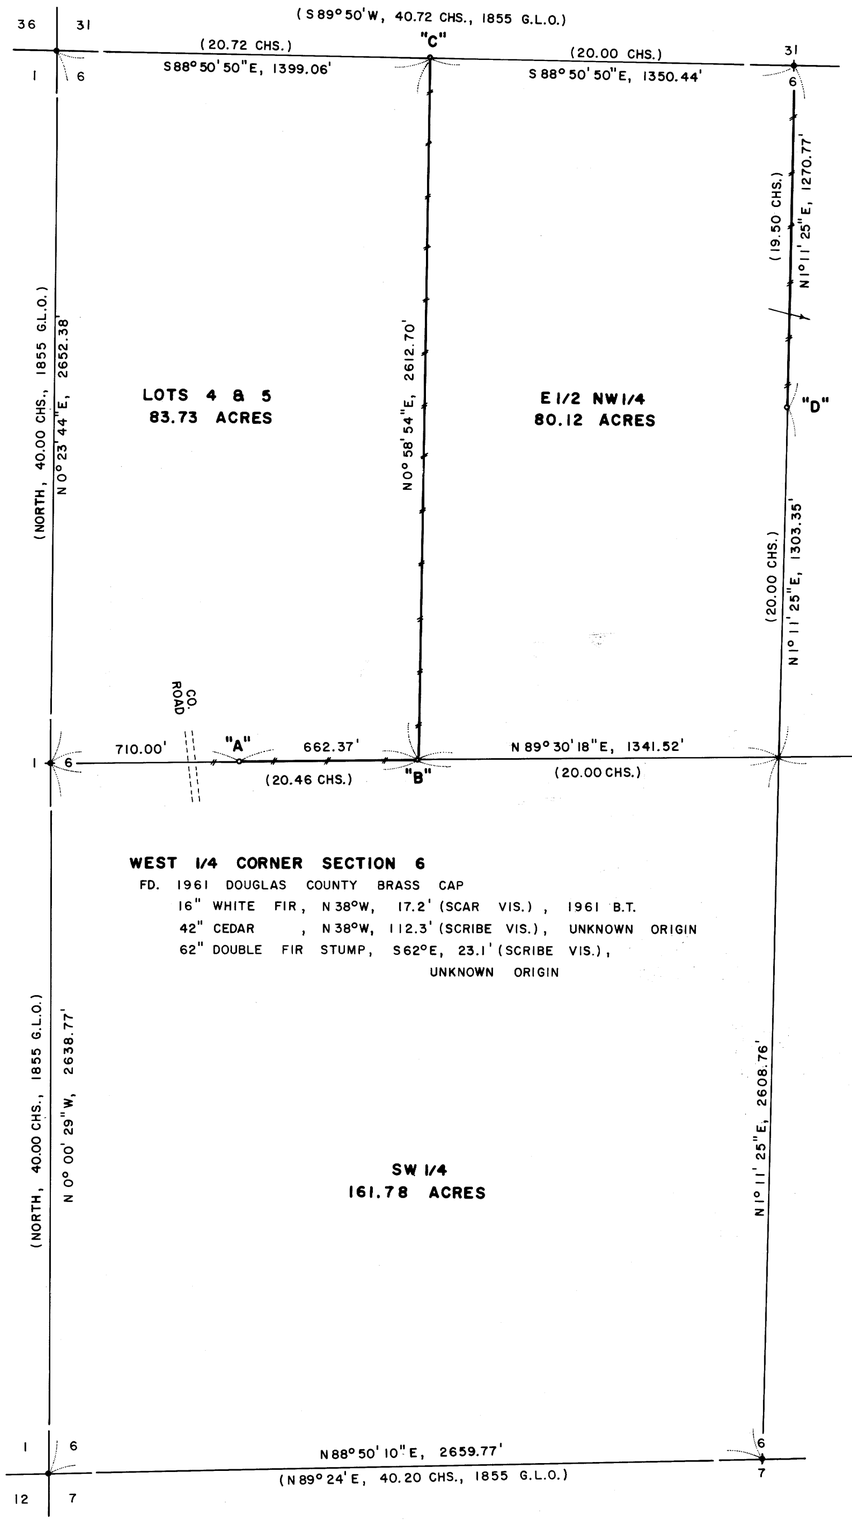

"A" POINT ON EAST-WEST ℄ SECTION 6

SET 5/8" x 30" IRON PIN WITH YELLOW PLASTIC CAP.
14" FIR, S48°E, 4.9' (SCRIBED/PAINTED RED)
14" FIR, N68°E, 14.9' (SCRIBED/PAINTED RED)

"B" C.W. 1/16 CORNER SECTION 6

SET 5/8" x 30" IRON PIN WITH YELLOW PLASTIC CAP.
9" FIR, S39°W, 13.3' (SCRIBED/PAINTED RED)
9" FIR, N58°W, 16.7' (SCRIBED/PAINTED RED)

"C" WEST 1/16 CORNER SECTION 6

SET 5/8" x 30" IRON PIN WITH YELLOW PLASTIC CAP.
11" FIR, S40°W, 22.6' (SCRIBED/PAINTED RED)
20" FIR, N61°W, 28.4' (SCRIBED/PAINTED RED)

"D" C.N. 1/16 CORNER SECTION 6

SET 5/8" x 30" IRON PIN WITH YELLOW PLASTIC CAP.
9" FIR, N31°W, 11.3' (SCRIBED/PAINTED RED)
14" FIR, S82°E, 7.1' (SCRIBED/PAINTED RED)

EAST 1/4 CORNER SECTION 6

FD. 1972 B.L.M. BRASS CAP
18" FIR, N03°E, 23.4' (SCAR VIS.), 1972 B.T.
34" FIR, N86°W, 27.8' (SCAR VIS.), 1972 B.T.

S.W. CORNER SECTION 6

FD. 1961 DOUGLAS COUNTY BRASS CAP
12" CHINQUAPIN, S62°E, 26.2' (SCAR VIS.), 1961 B.T.
16" FIR, S43°W, 42.0' (SCAR VIS.), 1961 B.T.
22" FIR, N41°W, 53.6' (SCAR VIS.), 1961 B.T.
24" FIR, N58°E, 54.1' (SCAR VIS.), 1961 B.T.

SOUTH 1/4 CORNER SECTION 6

FD. 1969 DOUGLAS COUNTY BRASS CAP
9" DOWNED FIR, N47°E, 6.0' (SCAR VIS.), 1969 B.T.
18" FIR STUMP, S76°W, 19.4' (SCAR VIS.), 1969 B.T.

MAP FILE M110 - 28

FILED
JUL 10 1990
COUNTY SURVEYOR
DOUGLAS COUNTY, ORE.

MAP FILE M110 - 28

SURVEY OF NW1/4 SECTION 6, T21S, R4W, W.M. DOUGLAS COUNTY, OREGON FOR SENECA TIMBER COMPANY BY ROBERTS SURVEYING INC. 29 WEST 29TH STREET EUGENE, OREGON 97405

JUNE 11, 1990
SCALE 1" = 400'

N

LEGEND

- • MONUMENTS FOUND AND USED FOR CONTROL.
- ° MONUMENTS SET, 5/8" x 30" IRON PINS WITH YELLOW PLASTIC CAPS. CAPS MARKED "ROBERTS P.L.S. 1039"
- ( ) DATA OF RECORD, 1855 G.L.O. SURVEY AND 1971 B.L.M. SURVEY
- LINES MARKED WITH RED PAINTED BLAZES AND RED RIBBON
- BASIS OF BEARING, SOLAR OBSERVATION.
- DISTANCES TO B.T.'S ARE CENTER MEASURE.
- ALL NEW B.T.'S ARE SCRIBED AND HAVE A BRASS WASHER STAMPED "P.L.S. 1039" NAILED TO LOWER BLAZE

REGISTERED PROFESSIONAL LAND SURVEYOR
Lee Roberts
OREGON
JULY 1, 1975
L. D. ROBERTS
1039

NARRATIVE, THE PURPOSE OF THIS SURVEY IS TO BLAZE THE FOLLOWING BOUNDARIES AND TO SET THE FOLLOWING CORNERS: 1) SET THE C.N. 1/16 CORNER AND BLAZE THE N1/2 OF THE N1/2 OF THE NORTH-SOUTH ℄. 2) SET THE WEST 1/16 CORNER ON THE NORTH LINE OF SECTION 6 AND BLAZE THE NORTH-SOUTH ℄ OF THE NW1/4. 3) SET THE C.W. 1/16 CORNER AND BLAZE THE W1/2 OF THE W1/2 OF THE EAST-WEST ℄ LYING EAST OF THE COUNTY ROAD. THE NORTH 1/4 CORNER, THE EAST 1/4 CORNER, THE SOUTH 1/4 CORNER, THE S.W. SECTION CORNER, THE WEST 1/4 CORNER AND THE N.W. SECTION CORNER WERE FOUND IN THE FIELD AS SHOWN. A SERIES OF CLOSED RANDOM TRAVERSES, USING A WILD T-16 THEODOLITE AND A DI-4L E.D.M., WERE RUN BETWEEN THE ABOVE MENTIONED CORNERS AND USED FOR CONTROL. THE COORDINATE POSITION FOR THE CENTER 1/4 CORNER WAS CALCULATED BY INTERSECTING THE NORTH-SOUTH AND EAST-WEST CENTERLINES OF SAID SECTION. CORNER "D", THE C.N. 1/16 CORNER, WAS SET BY PROPORTIONATE MEASURE USING 20.00 CHAINS AND 19.50 CHAINS RESPECTIVELY AS CALCULATED FROM THE ORIGINAL 1855 TOWNSHIP PLAT. CORNER "C", THE WEST 1/16 CORNER BETWEEN SECTIONS 6 AND 31, WAS SET BY PROPORTIONATE MEASURE USING 20.00 CHAINS AND 20.72 CHAINS RESPECTIVELY AS SHOWN ON THE ORIGINAL 1855 TOWNSHIP PLAT. CORNER "B", THE C.W. 1/16 CORNER, WAS SET BY PROPORTIONATE MEASURE USING 20.00 CHAINS AND 20.46 CHAINS RESPECTIVELY AS CALCULATED FROM SAID ORIGINAL TOWNSHIP PLAT. CORNER "A" WAS SET ON THE EAST-WEST ℄ OF SAID SECTION 6, 710.00 FEET EASTERLY (ARBITRARY DISTANCE) FROM THE WEST 1/4 CORNER AS SHOWN. A RANDOM PROPERTY LINE TRAVERSE WAS RUN ALONG ALL LINES TO BE BLAZED AND PAINTED. OFFSETS WERE COMPUTED FROM THIS RANDOM PROPERTY LINE TRAVERSE TO THE TRUE PROPERTY LINE. PROPERTY LINES WERE MARKED WITH RED PAINTED BLAZES AND RED RIBBON.

COUNTY SURVEYORS FILE DATA
DO NOT REMOVE FROM OFFICE