


MAP FILE M110-56

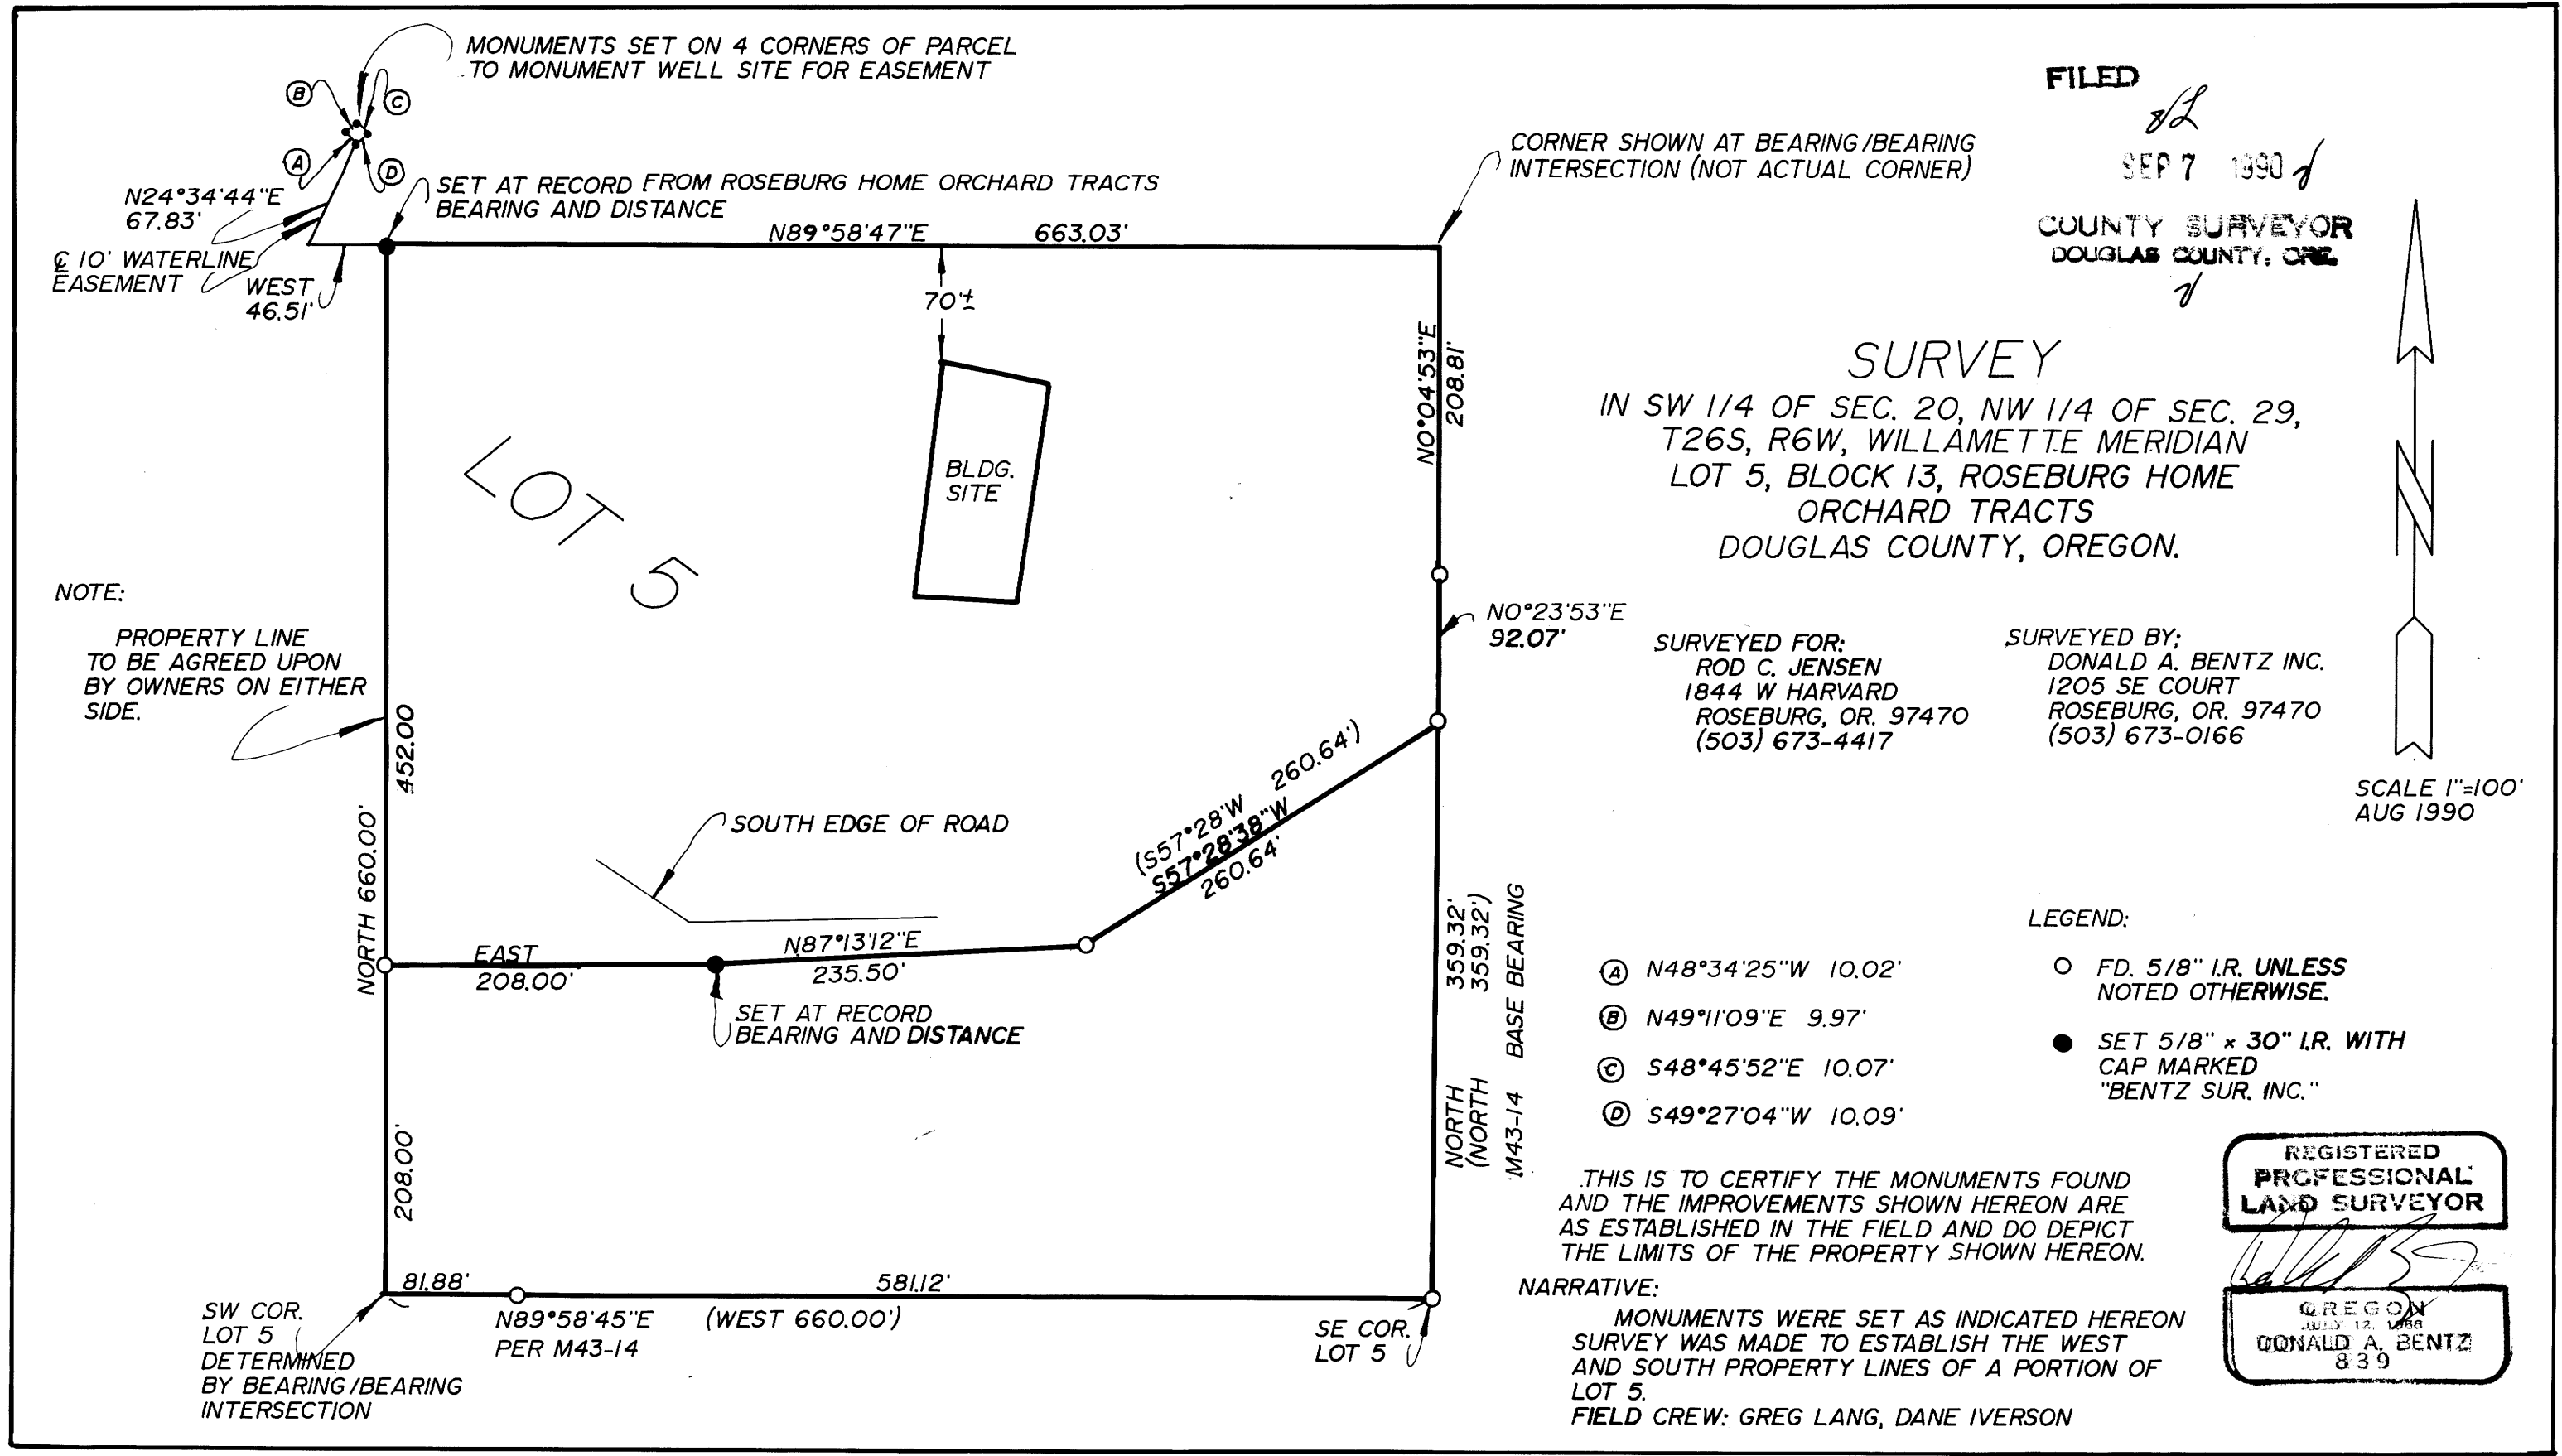

MAP FILE M110-56