PROPERTY SURVEY IN THE N.E. 1/4, SECTION 30, T.25 S., R.7 W., W.M. DOUGLAS CO., OR.

COUNTY SURVEYORS FILE DATA
DO NOT REMOVE FROM OFFICE

FOR· DENISE PARRNELL
c/o KNIGHT REALTY

BY· ROBERT L. DOLAN
3614 NONPAREIL RD.
SUTHERLIN, OR. 97479

DATE· DECEMBER 1990

SCALE· 1"=50'

Legend· ⊙ FOUND AS NOTED
● SET 5/8"x 30" IRON ROD W/CAP (LS 1076)

NARRATIVE·
SURVEY TO MONUMENT PROPERTY CORNERS. CORNERS COMPUTED FROM DOUGLAS COUNTY DEED RECORDS NO. 51593

NOTE "A"
FOUND 5/8" IRON ROD WITH BEARING TREES
ROD ~~BEARS~~ N 88°31'03"W, 20.61 FT. FROM COMPUTED C.E. 1/16
NOTE - EXISTING FENCES ON THE PARCEL ARE NOT ON THE PROPERTY LINES.

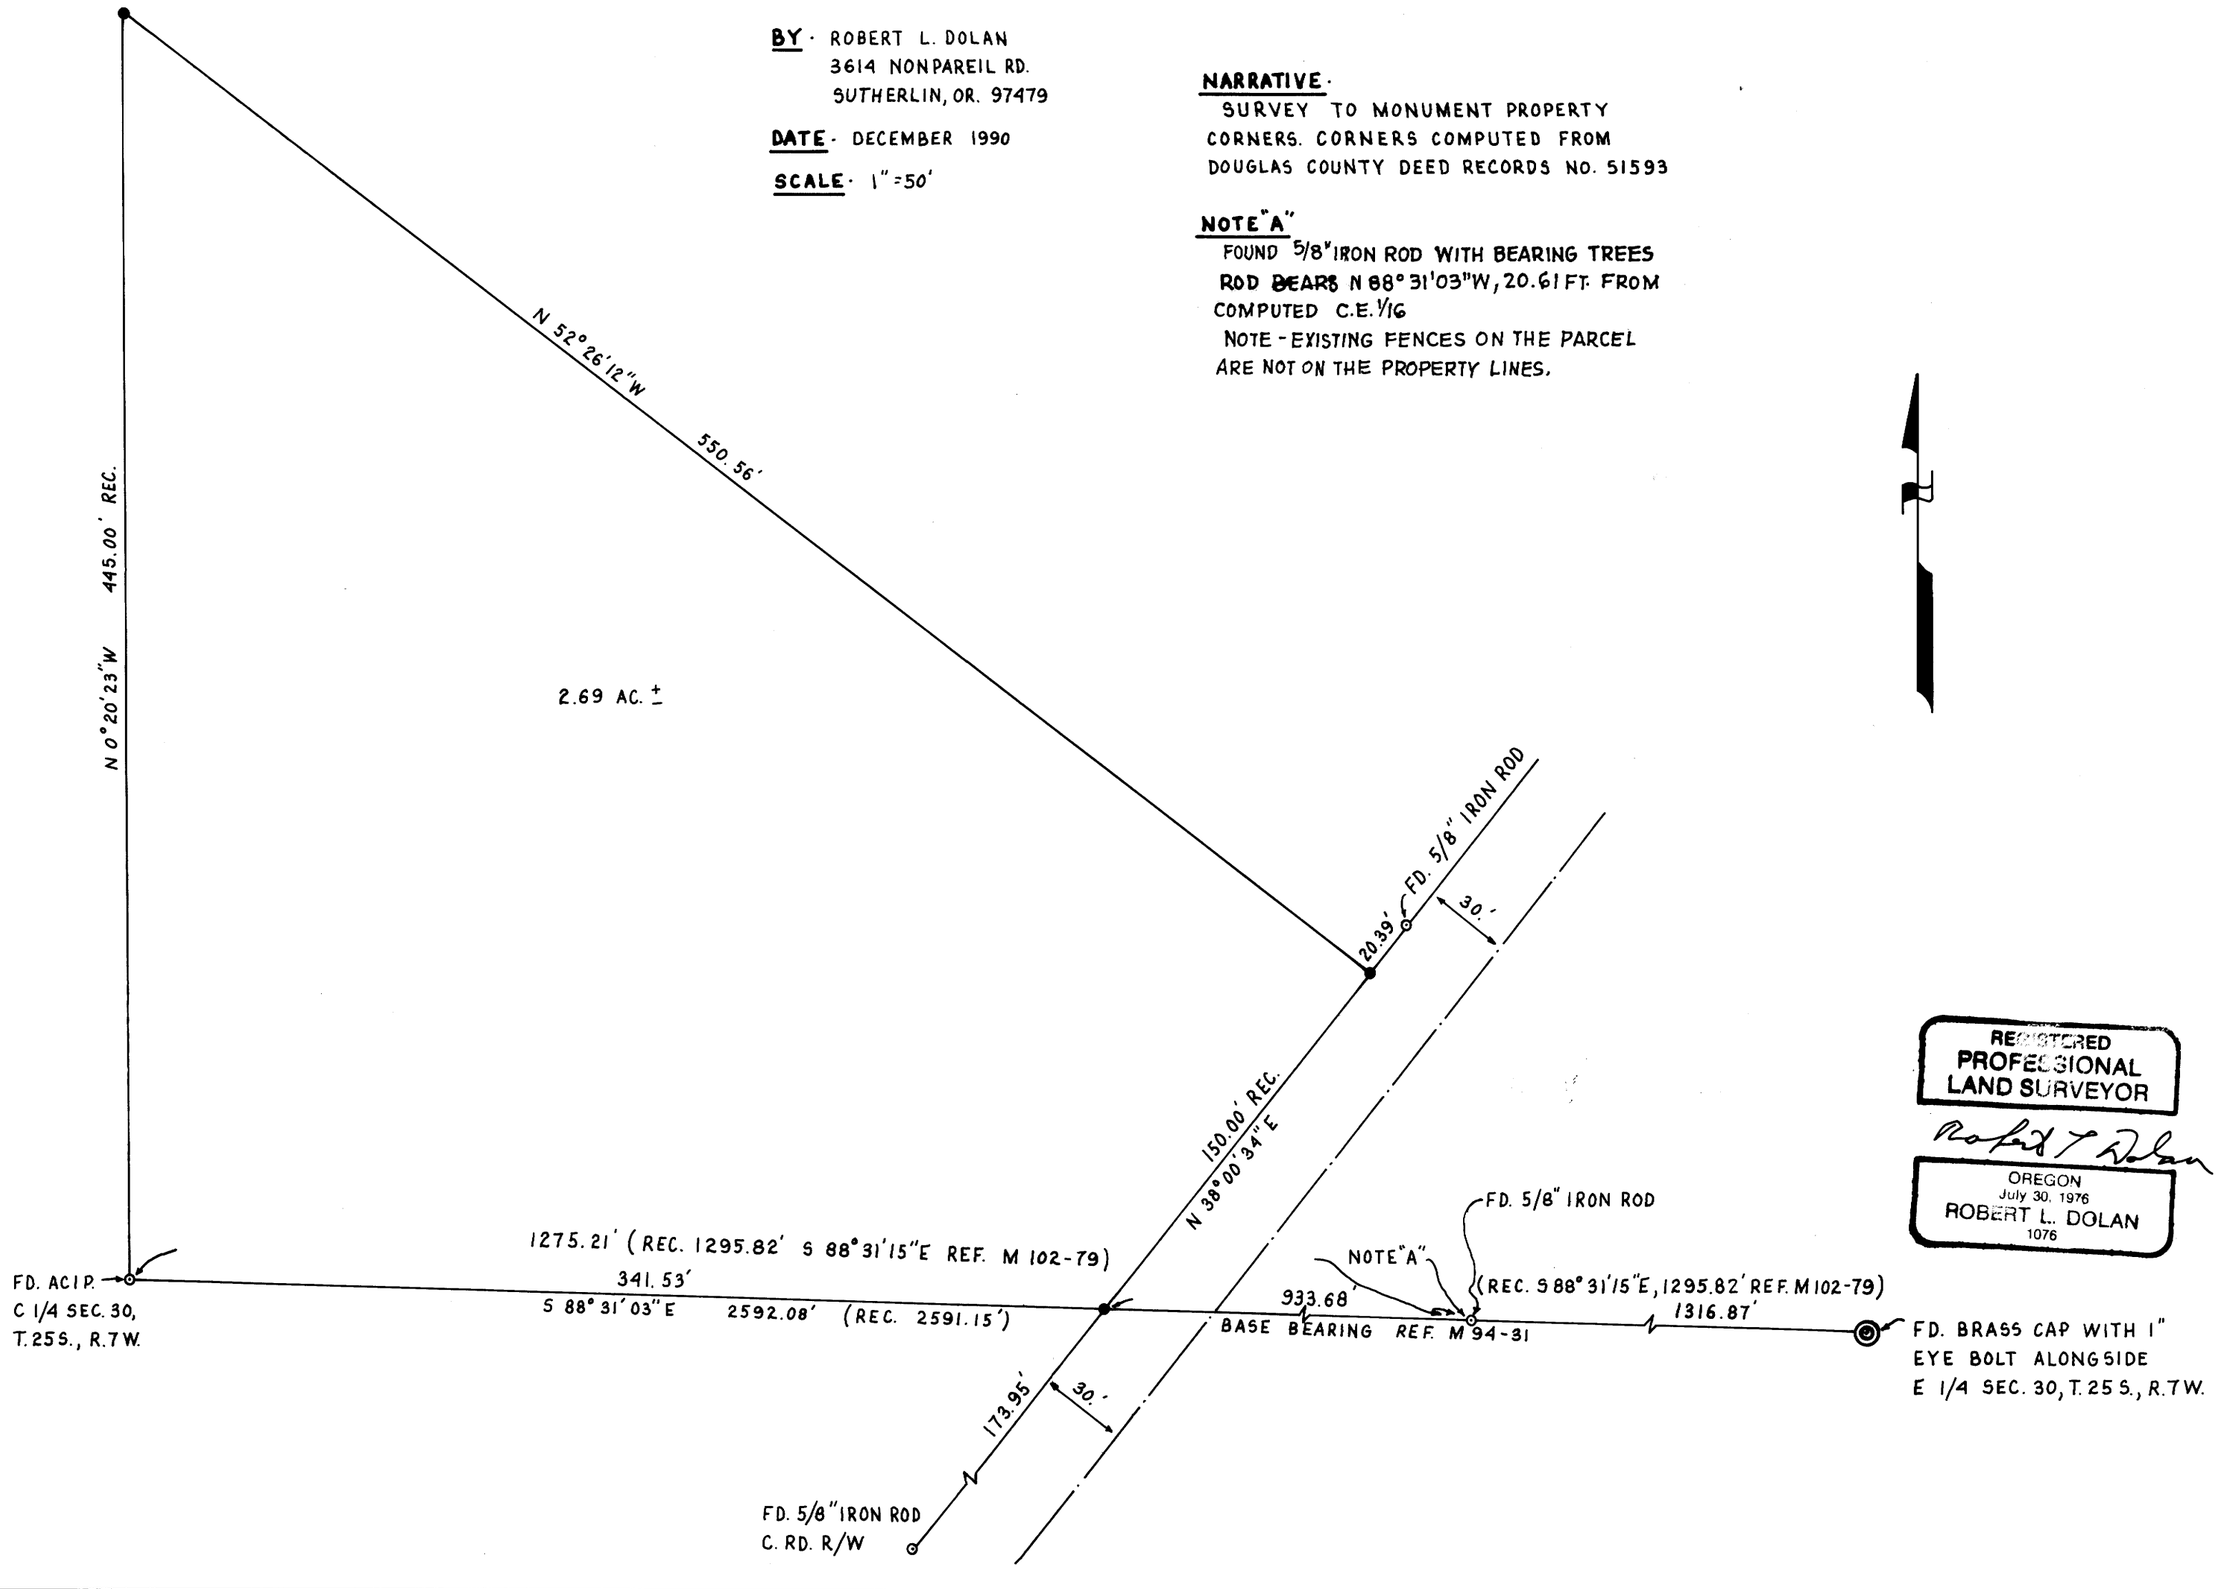

REGISTERED
PROFESSIONAL
LAND SURVEYOR
Robert L Dolan
OREGON
July 30, 1976
ROBERT L. DOLAN
1076

MAP FILE M III - 28

MAP FILE M III - 28