COUNTY SURVEYORS FILE DATA
DO NOT REMOVE FROM OFFICE

FILED

N.W. CORNER SECTION 4
FD. 1952 G.L.O. BRASS CAP
BRASS CAP NOT TIED THIS SURVEY

"A" W-W-W- 1/256 CORNER SECTION 4
FD. 2 1/2" ALUMINUM PIPE AND CAP AS SET IN SURVEY M85-46.
26" FIR, S54°W, 9.0' (SCAR VIS.), 1980 B.T.
40" FIR, N34°W, 13.5' (SCAR VIS.), 1980 B.T.

NORTH 1/4 CORNER SECTION 4
FD. 1952 G.L.O. BRASS CAP
48" FIR, S08°W, 6.5' (SCAR VIS.), 1952 B.T.
50" FIR, N75°E, 94.0' (SCAR VIS.), 1952 B.T.

N.E. CORNER SECTION 4
FD. 1952 G.L.O. BRASS CAP
12" FIR , S53°E, 13.7' (SCAR VIS.), 1952 B.T.
13" FIR SNAG, S25°W, 7.3' (SCAR VIS.), 1952 B.T.
14" FIR , N28°W, 10.9' (SCAR VIS.), 1952 B.T.
18" FIR , N57°E, 6.4' (SCAR VIS.), 1952 B.T.
SET 2 1/2" x 30" ALUMINUM PIPE AND CAP FOR R.M. BRASS CAP BEARS N89°42'30"E, 63.06' FROM REFERENCE MONUMENT

EXAMINED AND ACCEPTED FOR THE U.S. FOREST SERVICE THIS 11th DAY OF JANUARY, 1991.
Randall M. Lynn C.O.R. I CERTIFY THAT THIS SURVEY WAS PERFORMED AT THE REQUEST OF THE SIUSLAW NATIONAL FOREST SUPERVISOR.
SIGNATURE Wendy A. Hewett
DATE 4/1/91

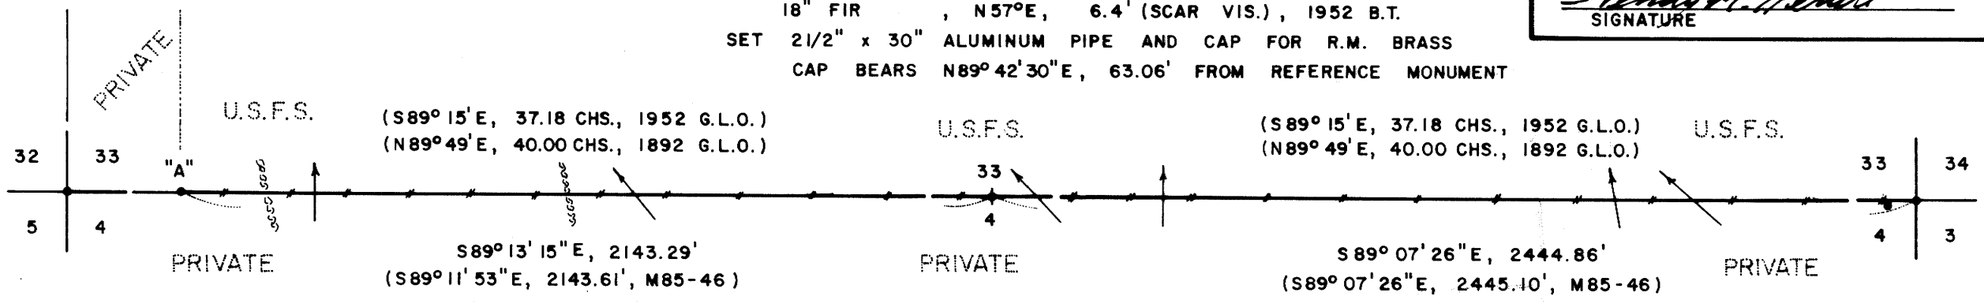

REGISTERED PROFESSIONAL LAND SURVEYOR
Les Roberts
OREGON
AUGUST 22, 1975
L. D. ROBERTS
1039

MAP FILE M III - 33
63/126

SURVEY HISTORY, THE NORTH LINE OF SECTION 4 WAS ORIGINALLY SURVEYED BY NATHANIEL MARTIN IN 1892. IN 1918, DEPUTY COUNTY SURVEYOR, F.C. FREAR RENEWED THE N.W. CORNER FROM ORIGINAL B.T.'S. IN 1922, G.L.O. SURVEYOR, FRED MENSCH RETRACED THE NORTH LINE OF SECTION 4 AND REMONUMENTED SAID N.W. CORNER. IN 1952, G. L. O. SURVEYOR, TOM TILLMAN RESURVEYED THE NORTH LINE OF SECTION 4 AND REMONUMENTED SAID N.W. CORNER. TILLMAN ALSO RE-ESTABLISHED THE NORTH 1/4 CORNER AND THE NORTHEAST SECTION CORNER BY SINGLE PROPORTIONATE MEASURE. RICHARD HINTZ, P.L.S. NO. 497, SUBDIVIDED THE N.E. 1/4 OF SECTION 4 IN 1978 AS SHOWN ON SURVEY M69-78. DONALD PEEL, P.L.S. NO. 752, SUBDIVIDED SECTION 33 IN 1980 AS SHOWN ON SURVEY M85-46. THE W-W-W 1/256 CORNER BETWEEN SECTIONS 4 AND 33 WAS SET BY PEEL IN SURVEY M 85-46.

NARRATIVE, THE PURPOSE OF THIS SURVEY IS TO POST AND BLAZE THE NORTH LINE OF SECTION 4. THE N.E. SECTION CORNER, THE NORTH 1/4 CORNER AND THE W-W-W 1/256 CORNER WERE FOUND IN THE FIELD AS SHOWN. AN "OPEN-ENDED" PROPERTY LINE TRAVERSE, USING A WILD T-16 THEODOLITE AND A DI-4L E.D.M., WAS RUN ALONG THE NORTH LINE OF SECTION 4. OFFSETS WERE COMPUTED FROM THIS RANDOM PROPERTY LINE TRAVERSE TO THE TRUE LINE. TRUE PROPERTY LINES WERE MARKED WITH RED PAINTED BLAZES, RED PLASTIC RIBBON AND ORANGE FIBERGLASS POSTS WITH U.S. FOREST SERVICE PROPERTY LINE DECALS ATTACHED THEREON.

MAP FILE M III - 33
63/126

LEGEND

- • CORNERS FOUND AS NOTED
- ° R.M. SET, 2 1/2" x 30" ALUMINUM PIPE AND CAP. CAP STAMPED S4, T20S, R10W. P.L.S. 1039 DATED 1990. R.M. - N89°42'30"E, 63.06' →
- LINES BLAZED AND POSTED THIS SURVEY. PROPERTY LINES MARKED WITH RED PAINTED BLAZES, RED PLASTIC RIBBON AND ORANGE FIBERGLASS POSTS.
- ( ) DATA OF RECORD
- BASIS OF BEARING, EAST 1/2 NORTH LINE SECTION 4 FROM SURVEY M85-46.
- DISTANCES TO BEARING TREES ARE CENTER MEASURE

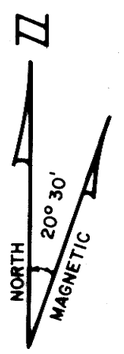

SCALE 0' 400' 800' 1200' / 0 M 121.922 M 243.843 M 365.764 M

PAXTON - CEDAR CADASTRAL SURVEY FOR INTERNATIONAL PAPER COMPANY AND U.S. FOREST SERVICE SIUSLAW NATIONAL FOREST SECTION 4, T20S, R10W, W.M. DOUGLAS COUNTY, OREGON

BY
ROBERTS SURVEYING INC.
29 WEST 29TH STREET
EUGENE, OREGON 97405

DECEMBER 12, 1990
SCALE 1" = 400'

STATEMENT, I, LES ROBERTS, A REGISTERED LAND SURVEYOR IN THE STATE OF OREGON, HEREBY CERTIFY THAT THIS PLAT AND THE NOTES HEREON ARE A CORRECT REPRESENTATION OF THE SURVEY I PERFORMED DURING THE MONTHS OF MAY AND JUNE OF 1990. SAID SURVEY WAS DONE IN ACCORDANCE WITH THE STATUTES OF THE STATE OF OREGON AND ACCORDING TO THE ARTICLES OF MY CONTRACT WITH INTERNATIONAL PAPER COMPANY AND THE UNITED STATES FOREST SERVICE.

Les Roberts
LES ROBERTS, P.L.S. 1039

01-05-91
DATE