SURVEY FOR BOUNDARY LINE ADJUSTMENT IN A PART OF LOT 6, MELROSE ORCHARDS, LOCATED IN THE N.E.1/4 & S.E.1/4, SECTION 1, T.27S., R.7W., W.M., DOUGLAS COUNTY, OREGON

COUNTY SURVEYORS FILE DATA
DO NOT REMOVE FROM OFFICE

FILED
COUNTY SURVEYOR
DOUGLAS COUNTY, ORE.

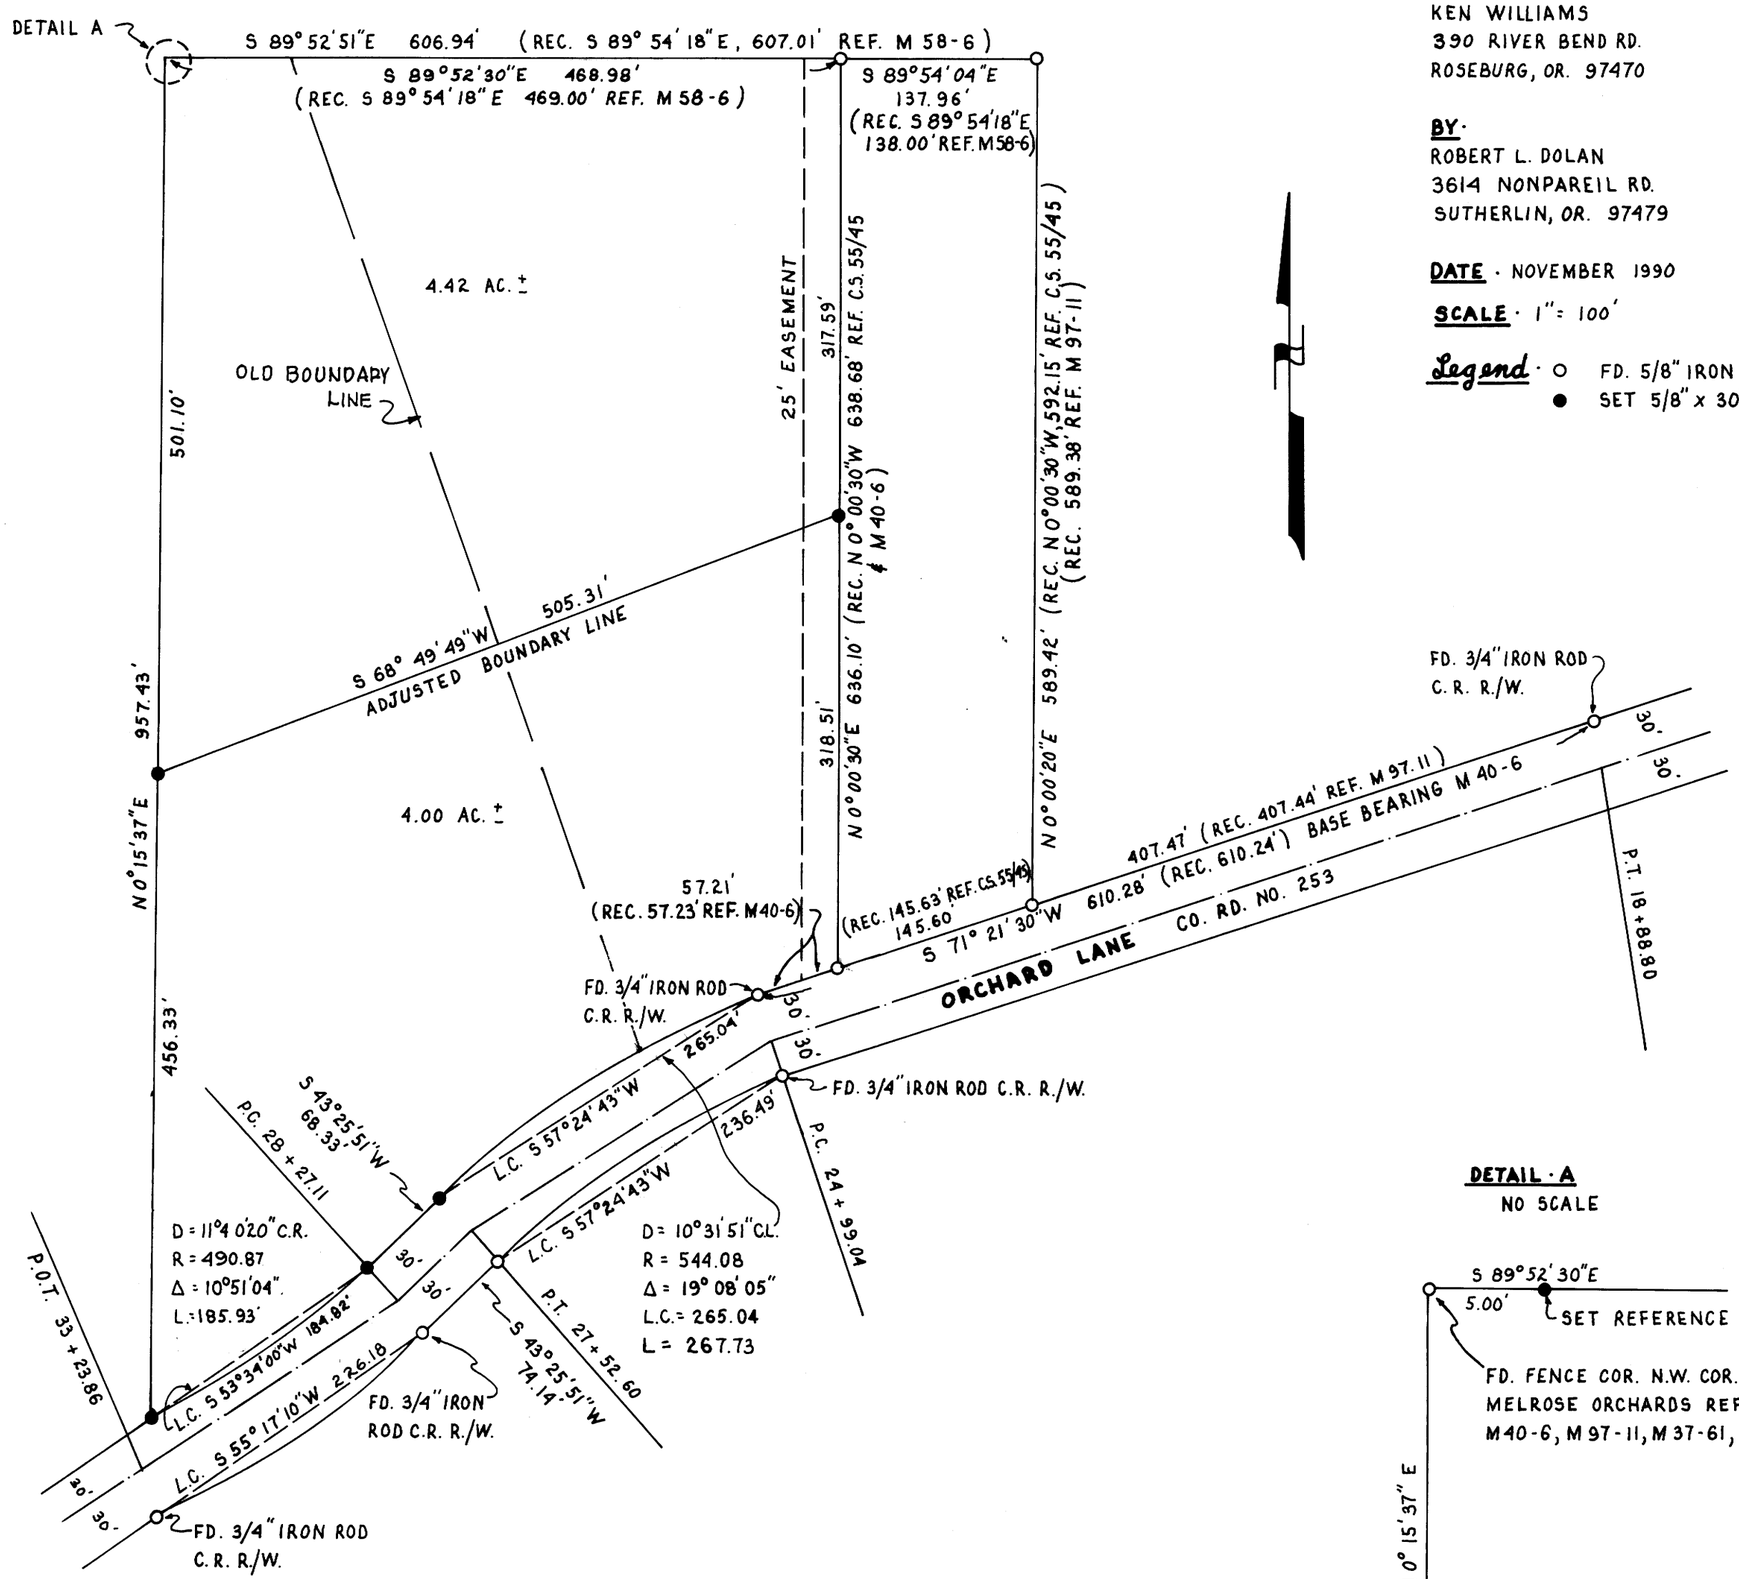

FOR·
KEN WILLIAMS
390 RIVER BEND RD.
ROSEBURG, OR. 97470

BY·
ROBERT L. DOLAN
3614 NONPAREIL RD.
SUTHERLIN, OR. 97479

DATE · NOVEMBER 1990

SCALE · 1" = 100'

Legend · ○ FD. 5/8" IRON ROD OR AS NOTED
● SET 5/8" x 30" IRON ROD W/CAP (L.S. 1076)

NARRATIVE·
SURVEY TO MONUMENT PROPERTY CORNERS. REF. M 58-6, M 40-6, M 97-11, M 37-61 & C.S. 55/45.

INSTRUMENTS·
THEODOLITE & DISTANCE METER.

Keith L. Cubic 12/4/90
PLANNING DIRECTOR DATE

DETAIL · A
NO SCALE

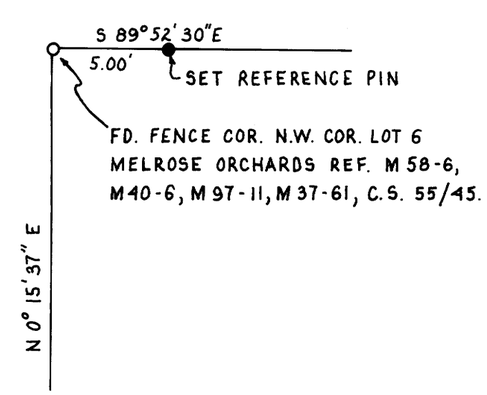

REGISTERED
PROFESSIONAL
LAND SURVEYOR
Robert L. Dolan
OREGON
July 30, 1976
ROBERT L. DOLAN
1076

MAP FILE M.III - 8