MAP FILE M112 - 6.1

SURVEYORS FILE DATA
DO NOT REMOVE FROM OFFICE

FILED
Dec 21 1992
COUNTY SURVEYOR
DOUGLAS COUNTY, OREGON

BOUNDARY SURVEY

in the SW 1/4, SECTION 8, T.25S., R.7W., W.M.
for DAN FUGATE

8 DEC 1992

LEGEND

- ● SET 5/8"X30" IRON ROD MARKED "AA SURVEYING SERVICES, INC."
- ◎ BRASS CAP
- ∘ CALCULATED POINT
- ( ) RECORD PER GLO PLAT 1896

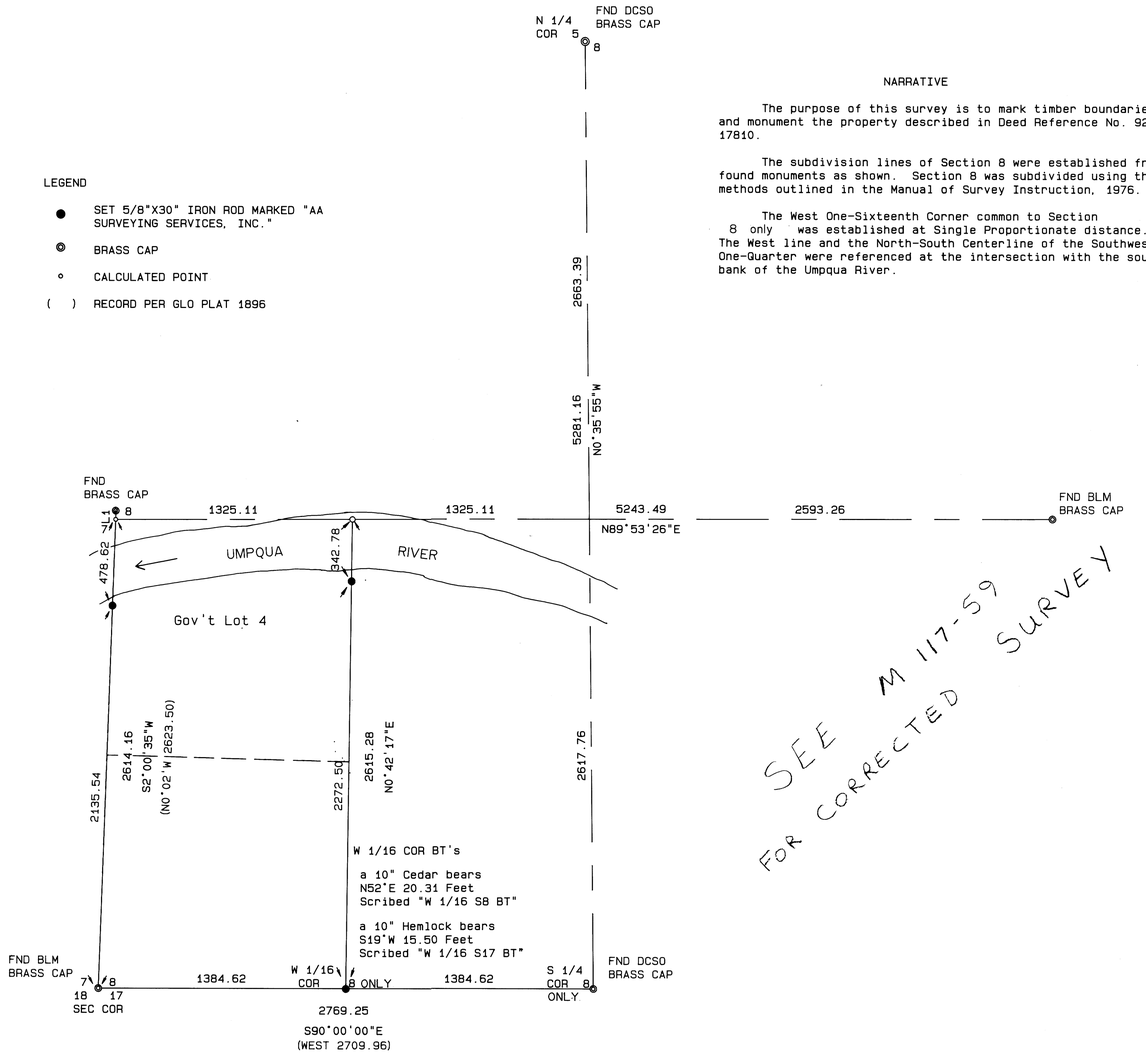

BASIS OF BEARINGS PER GLO PLAT 1896

NARRATIVE

The purpose of this survey is to mark timber boundaries of and monument the property described in Deed Reference No. 92-17810.

The subdivision lines of Section 8 were established from found monuments as shown. Section 8 was subdivided using the methods outlined in the Manual of Survey Instruction, 1976.

The West One-Sixteenth Corner common to Section 8 only was established at Single Proportionate distance. The West line and the North-South Centerline of the Southwest One-Quarter were referenced at the intersection with the south bank of the Umpqua River.

LINE	DISTANCE	BEARING
L1	49.30	S0°00'00"E

SEE M 117-59 FOR CORRECTED SURVEY

REGISTERED PROFESSIONAL LAND SURVEYOR
Mark A. Heimburger
OREGON
JULY 16, 1987
MARK A. HEIMBURGER
2287

0 400 800 1200
1 inch : 400 feet

SURVEYORS FILE DATA
DO NOT REMOVE FROM OFFICE

AA SURVEYING SERVICE, INC - 2566 N. STEPHENS STREET - ROSEBURG, OREGON 97470 - TEL (503) 672-2096

MAP FILE M112 - 6.1