COUNTY SURVEYORS FILE DATA
DO NOT REMOVE FROM OFFICE

MAY 4
COUNTY
DOUGLAS

MAP FILE M 112-71

SURVEY FOR PROPERTY LINE ADJUSTMENT IN WEST 1/2 SECTION 26, T29S, R5W, WM

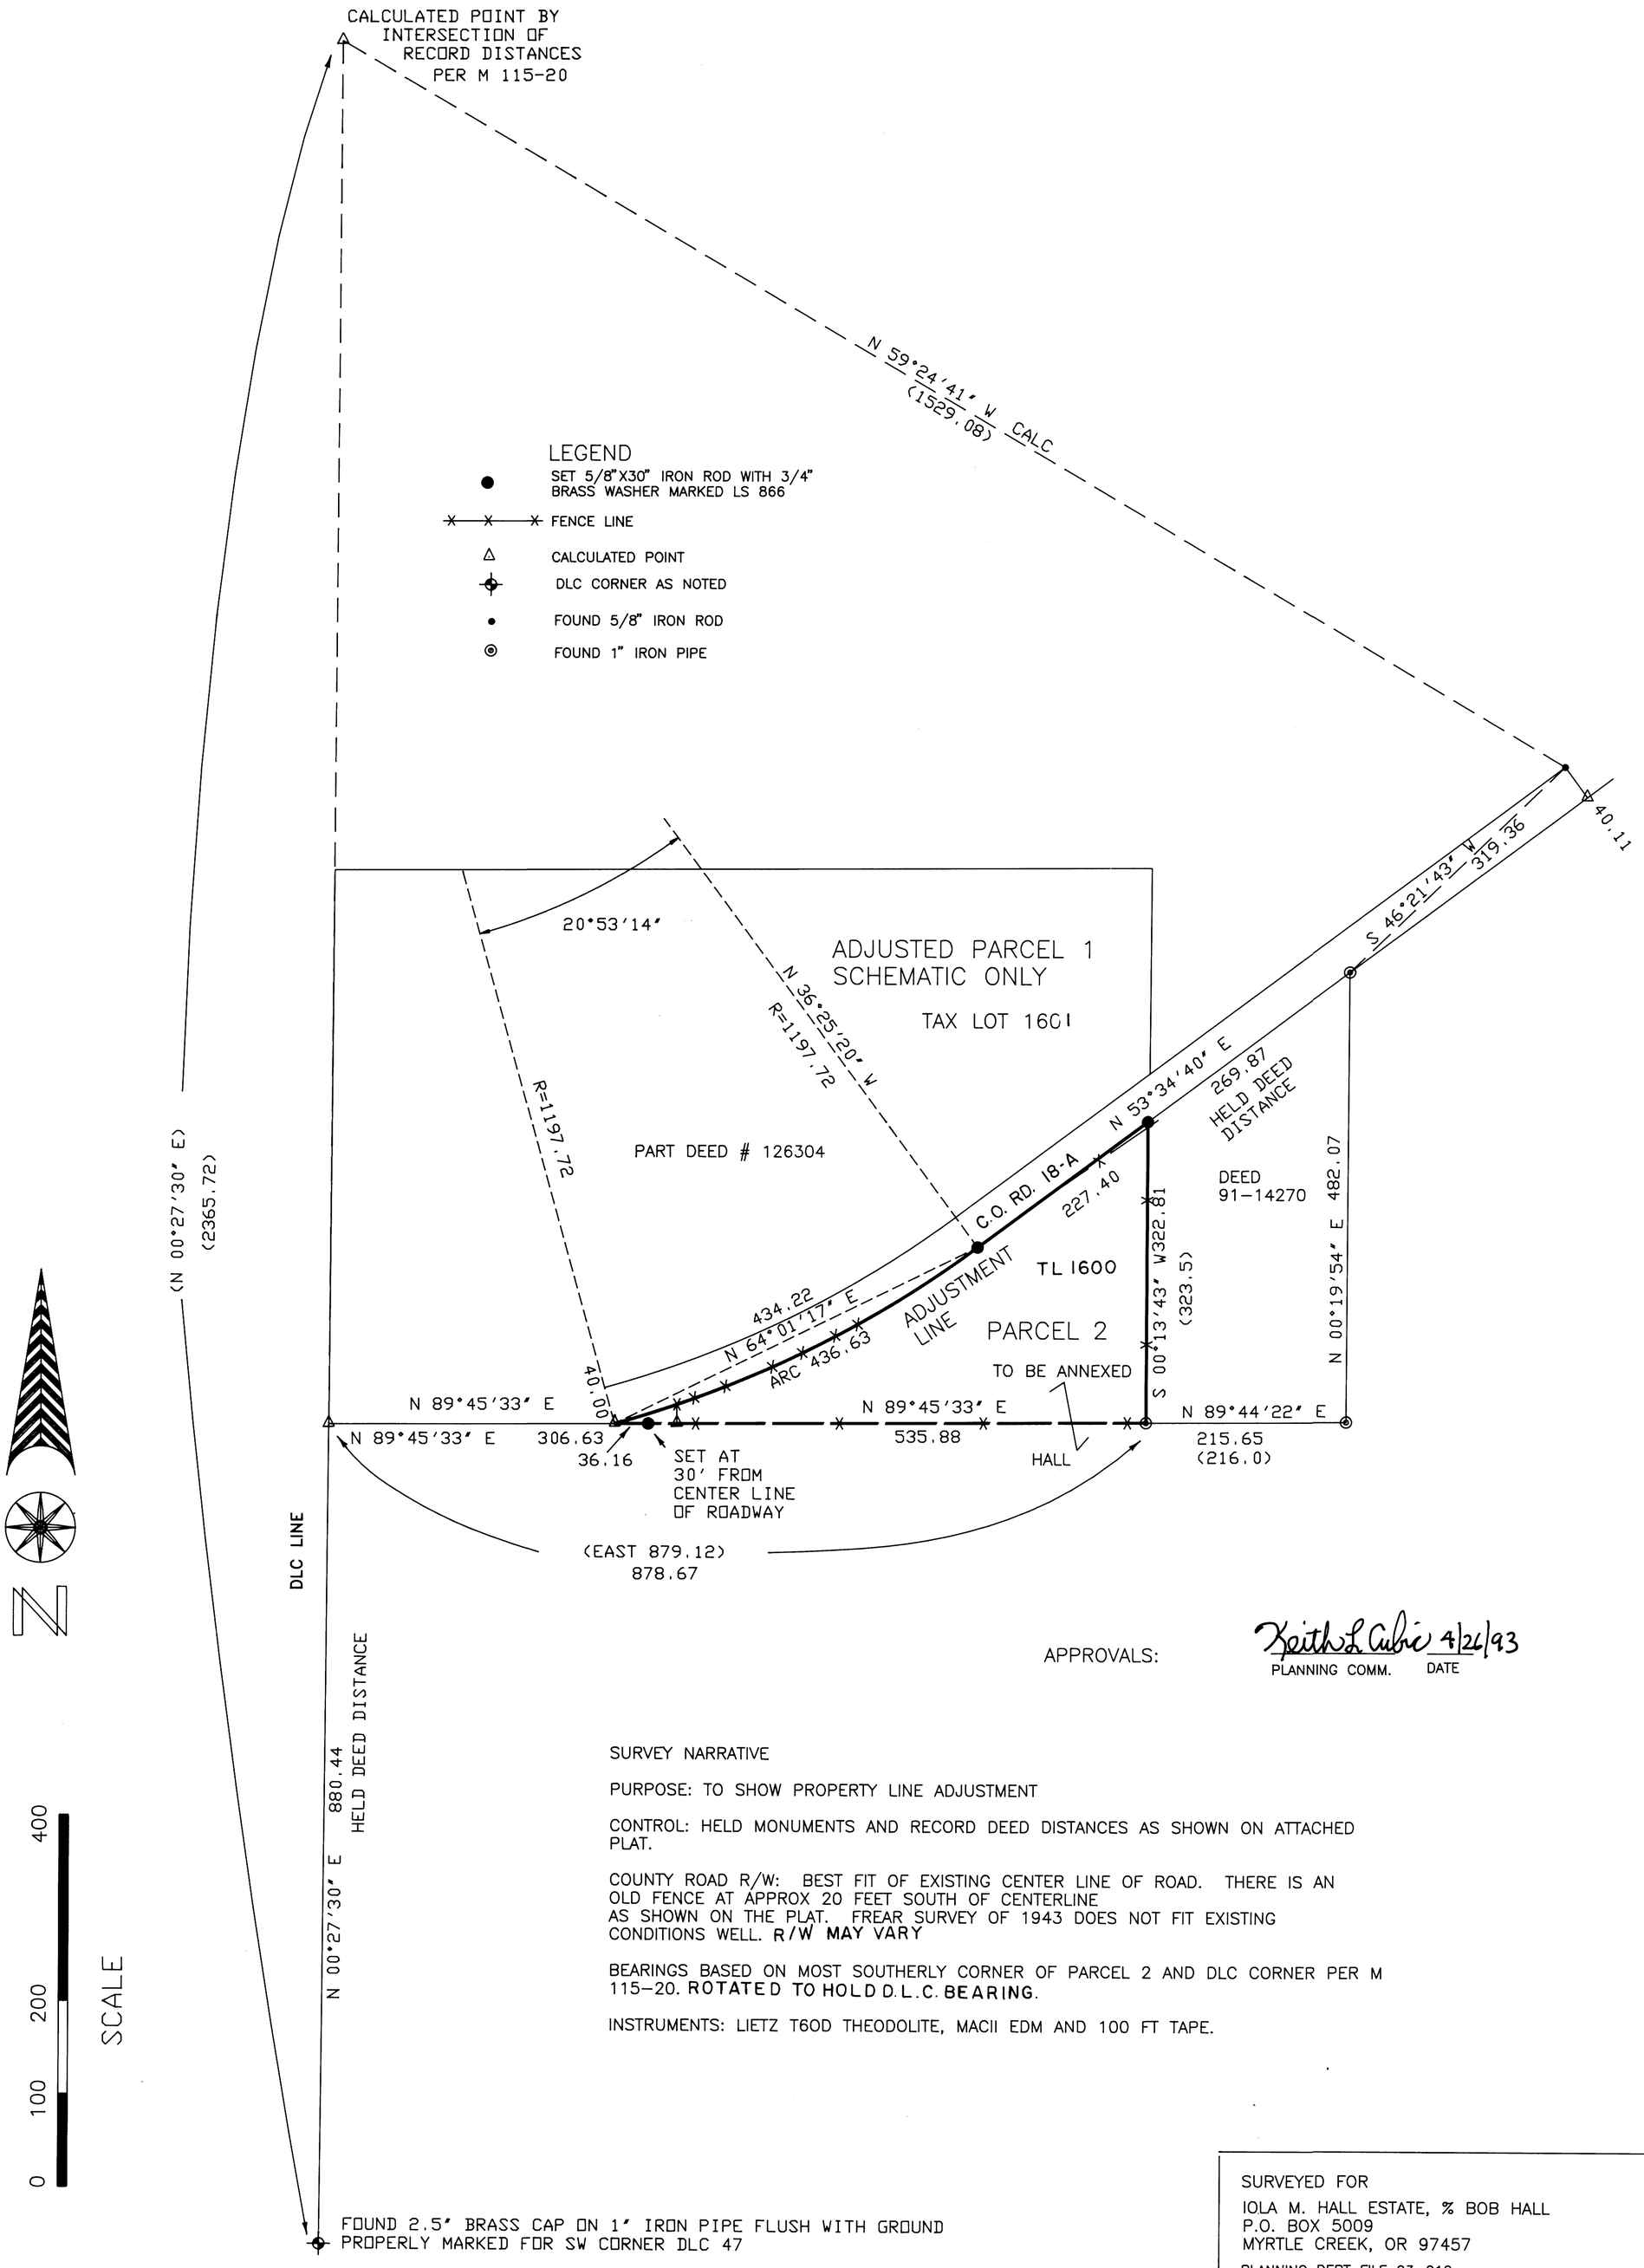

APPROVALS:

Keith L Cubic 4/26/93
PLANNING COMM. DATE

SURVEY NARRATIVE

PURPOSE: TO SHOW PROPERTY LINE ADJUSTMENT

CONTROL: HELD MONUMENTS AND RECORD DEED DISTANCES AS SHOWN ON ATTACHED PLAT.

COUNTY ROAD R/W: BEST FIT OF EXISTING CENTER LINE OF ROAD. THERE IS AN OLD FENCE AT APPROX 20 FEET SOUTH OF CENTERLINE AS SHOWN ON THE PLAT. FREAR SURVEY OF 1943 DOES NOT FIT EXISTING CONDITIONS WELL. R/W MAY VARY

BEARINGS BASED ON MOST SOUTHERLY CORNER OF PARCEL 2 AND DLC CORNER PER M 115-20. ROTATED TO HOLD D.L.C. BEARING.

INSTRUMENTS: LIETZ T6OD THEODOLITE, MACII EDM AND 100 FT TAPE.

SURVEYED FOR
IOLA M. HALL ESTATE, % BOB HALL
P.O. BOX 5009
MYRTLE CREEK, OR 97457

PLANNING DEPT FILE 93-012
ZONE: RR & FG

SURVEYED BY: WILLIAM J. RUPPERT
P.O. BOX 1564
MYRTLE CREEK, OR 97457
APRIL 1993

MY REGISTRATION EXPIRES
DECEMBER 31, 1994

COUNTY SURVEYORS FILE DATA
DO NOT REMOVE FROM OFFICE

MAP FILE M 112-71