SURVEYORS FILE DATA
REMOVE FROM OFFICE

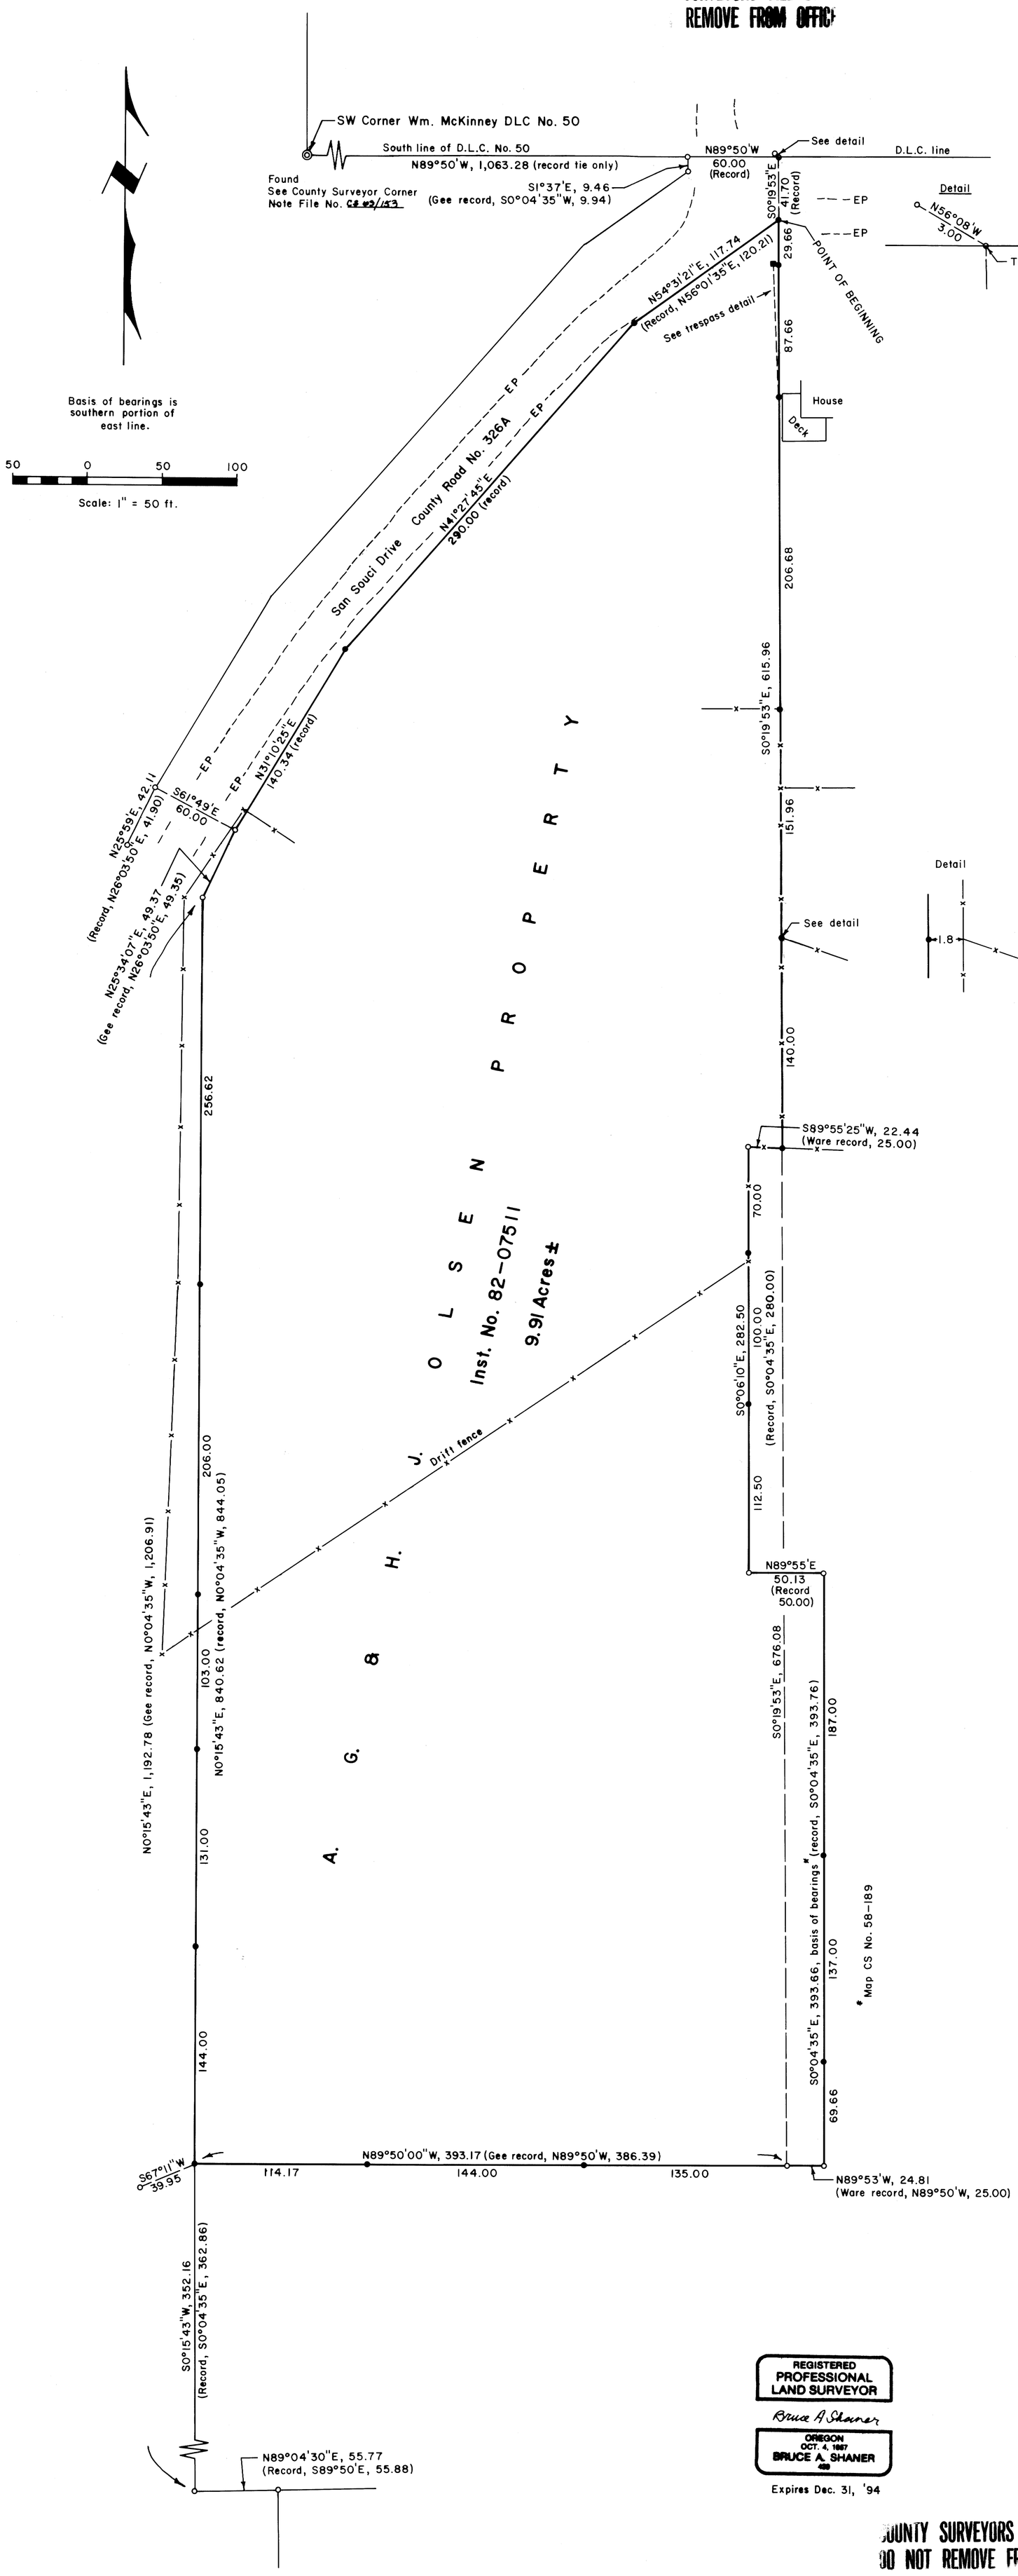

NARRATIVE:

The survey was accomplished for the purpose of re-establishing the property line.

The work was based primarily on the surveys by R. H. Gee, No. M 32-42 and No. M 36-17 and by R. E. Ware's Survey CS No. 58-189, all map files of the Douglas County Surveyor's Office.

The field survey was done in late May and June, 1993. The instruments used were a Jena 0°00'01" theodolite and a Mac II distance meter.

LEGEND

Corner found, 5/8" iron rod	○
Corner set, 5/8" x 30" iron rod with aluminum cap mkd. "Shaner Engr. RLS 430"	●
Corner computed, not set	⊖
Property line	———
Barb wire fence	—x——x—
Edge of pavement	— — EP — —
Power pole	■

REGISTERED PROFESSIONAL LAND SURVEYOR
Bruce A. Shaner
OREGON OCT. 4, 1967 BRUCE A. SHANER 430
Expires Dec. 31, '94

COUNTY SURVEYORS FILE DATA
DO NOT REMOVE FROM OFFICE

PROPERTY LINE SURVEY
in the SW 1/4 of Section 16, T27S, R6W, W.M., Douglas County, Oregon

For: Adolph G. & Hazel J. Olsen
564 San Souci Drive
Roseburg, Oregon 97470

By: Shaner Engineering, Inc.
P. O. Box 1430
Roseburg, Oregon 97470

June 14, 1993

Map File M 112-75
63/153