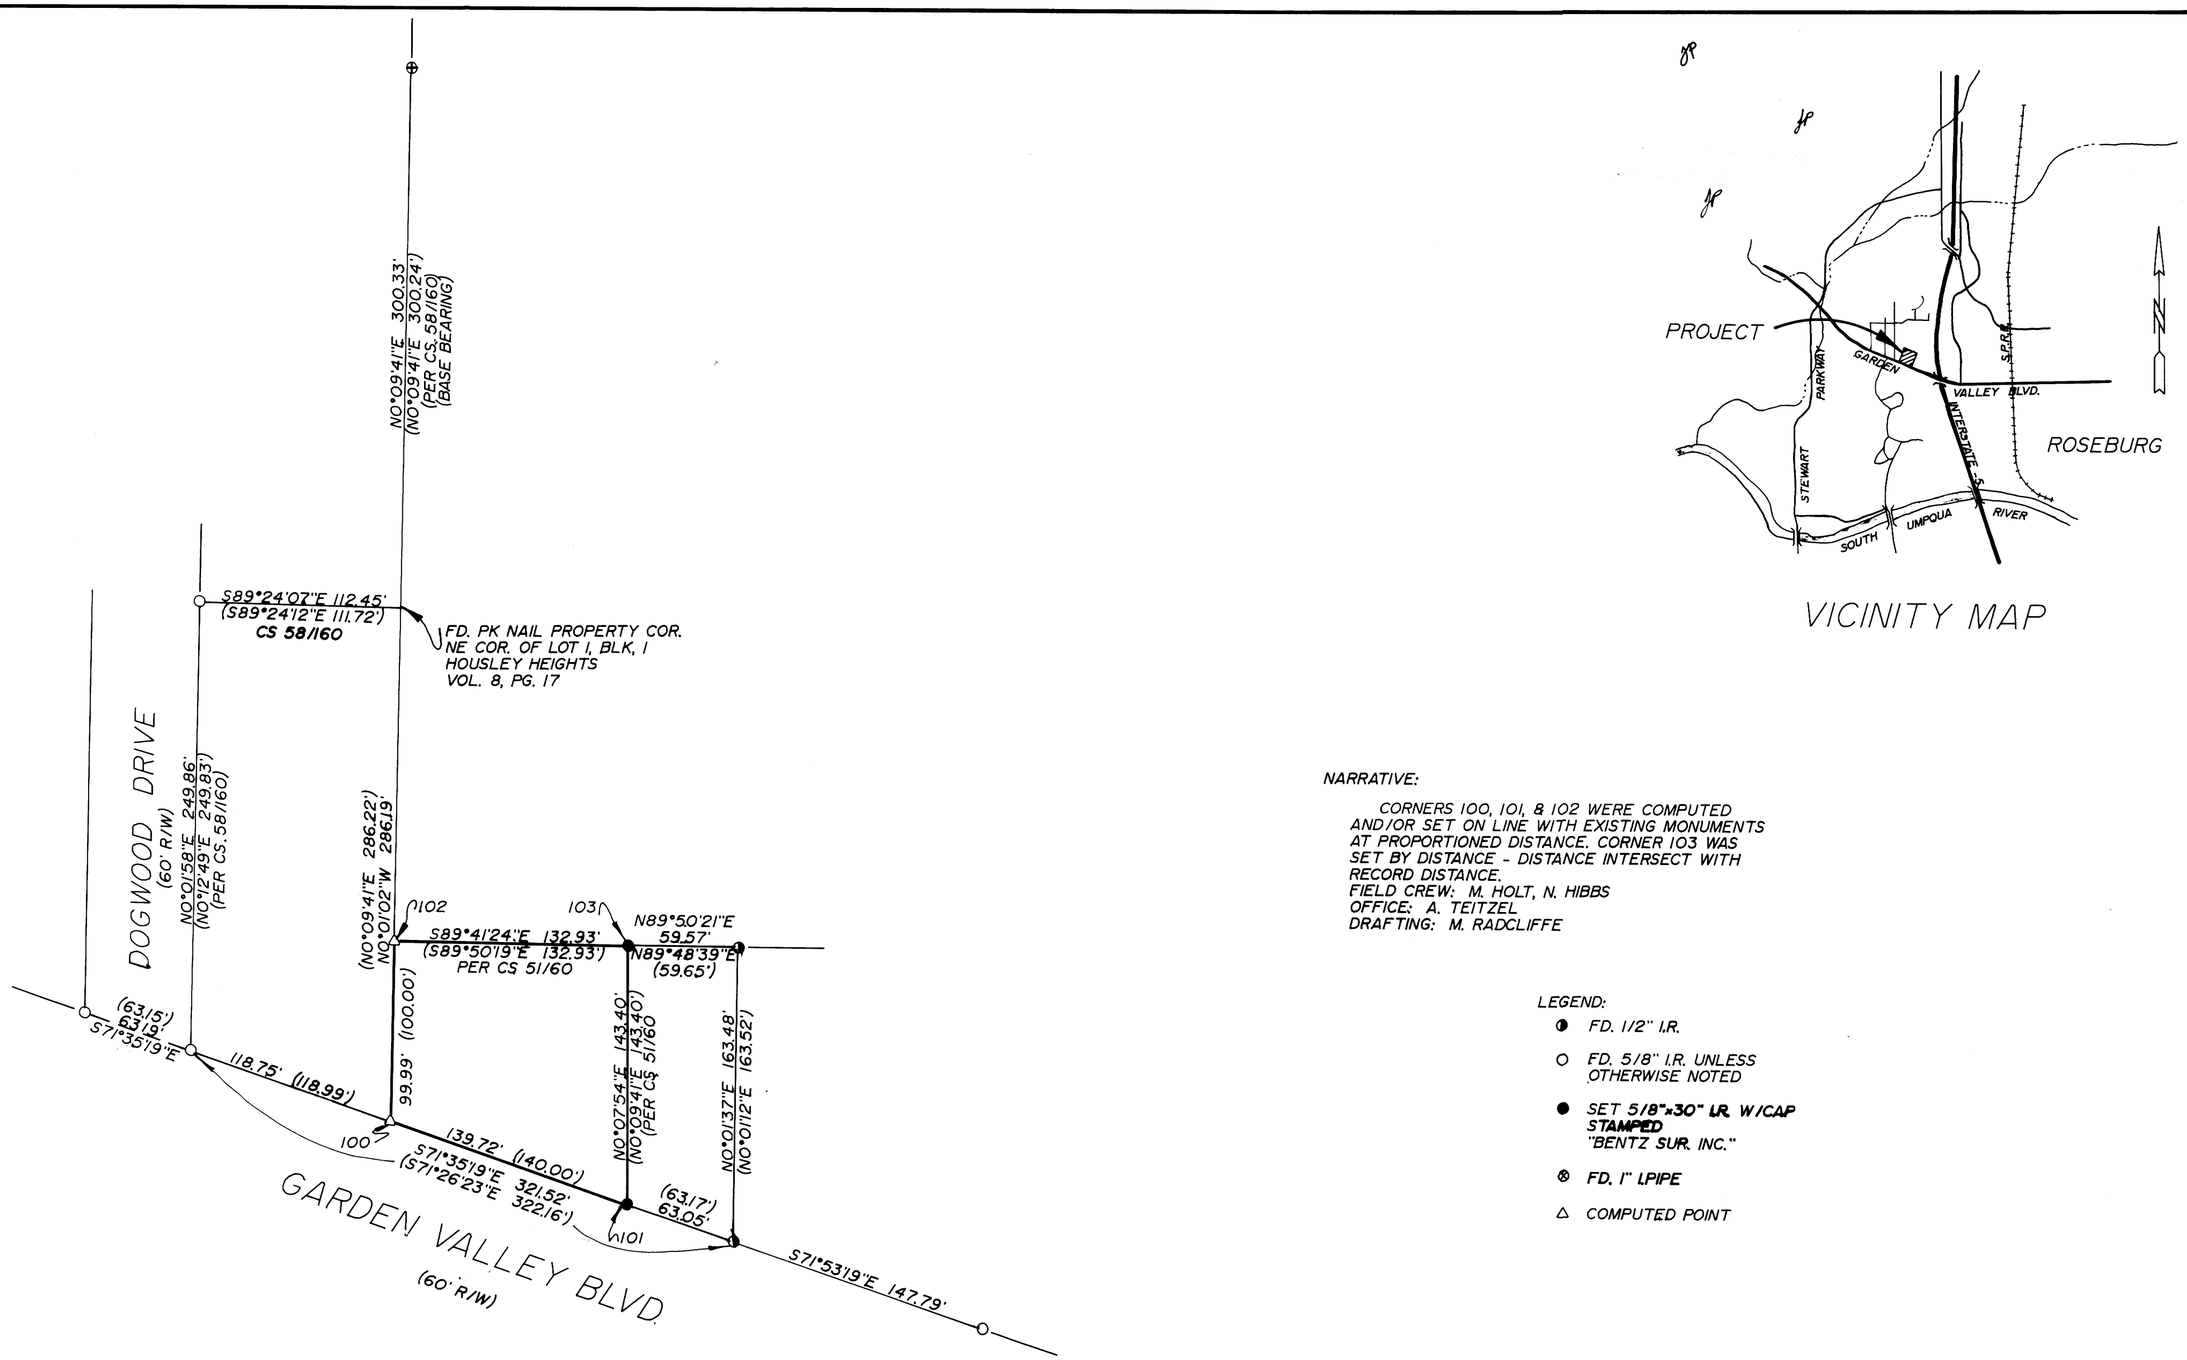

VICINITY MAP

NARRATIVE:

CORNERS 100, 101, & 102 WERE COMPUTED AND/OR SET ON LINE WITH EXISTING MONUMENTS AT PROPORTIONED DISTANCE. CORNER 103 WAS SET BY DISTANCE - DISTANCE INTERSECT WITH RECORD DISTANCE.
FIELD CREW: M. HOLT, N. HIBBS
OFFICE: A. TEITZEL
DRAFTING: M. RADCLIFFE

LEGEND:

- ◑ FD. 1/2" I.R.
- ○ FD. 5/8" I.R. UNLESS OTHERWISE NOTED
- ● SET 5/8"x30" I.R. W/CAP STAMPED "BENTZ SUR. INC."
- ⊗ FD. 1" I.PIPE
- △ COMPUTED POINT

REGISTERED
OREGON
LAND SURVEYOR
JULY 12, 1968
DONALD A. BENTZ
839

SURVEY
IN THE NW 1/4 OF
SEC. 13, T27S, R6W,
W.M., DOUGLAS COUNTY, OREGON

SURVEYED FOR:
GARDEN VALLEY SHELL
792 NW. GARDEN Vly. Bv
ROSEBURG, OREGON

SURVEYED BY:
i.e. ENGINEERING
1205 SE COURT
ROSEBURG OR. 97470
(503) 673-0166

SCALE: .1" = 60' | DATE: AUG. 1991 | C.N. 0132 J.N. 05 | PAGE: .1 OF 1

COUNTY SURVEYORS FILE DATA
DO NOT REMOVE FROM OFFICE

M 113 - 54

MAP M 113 - 54