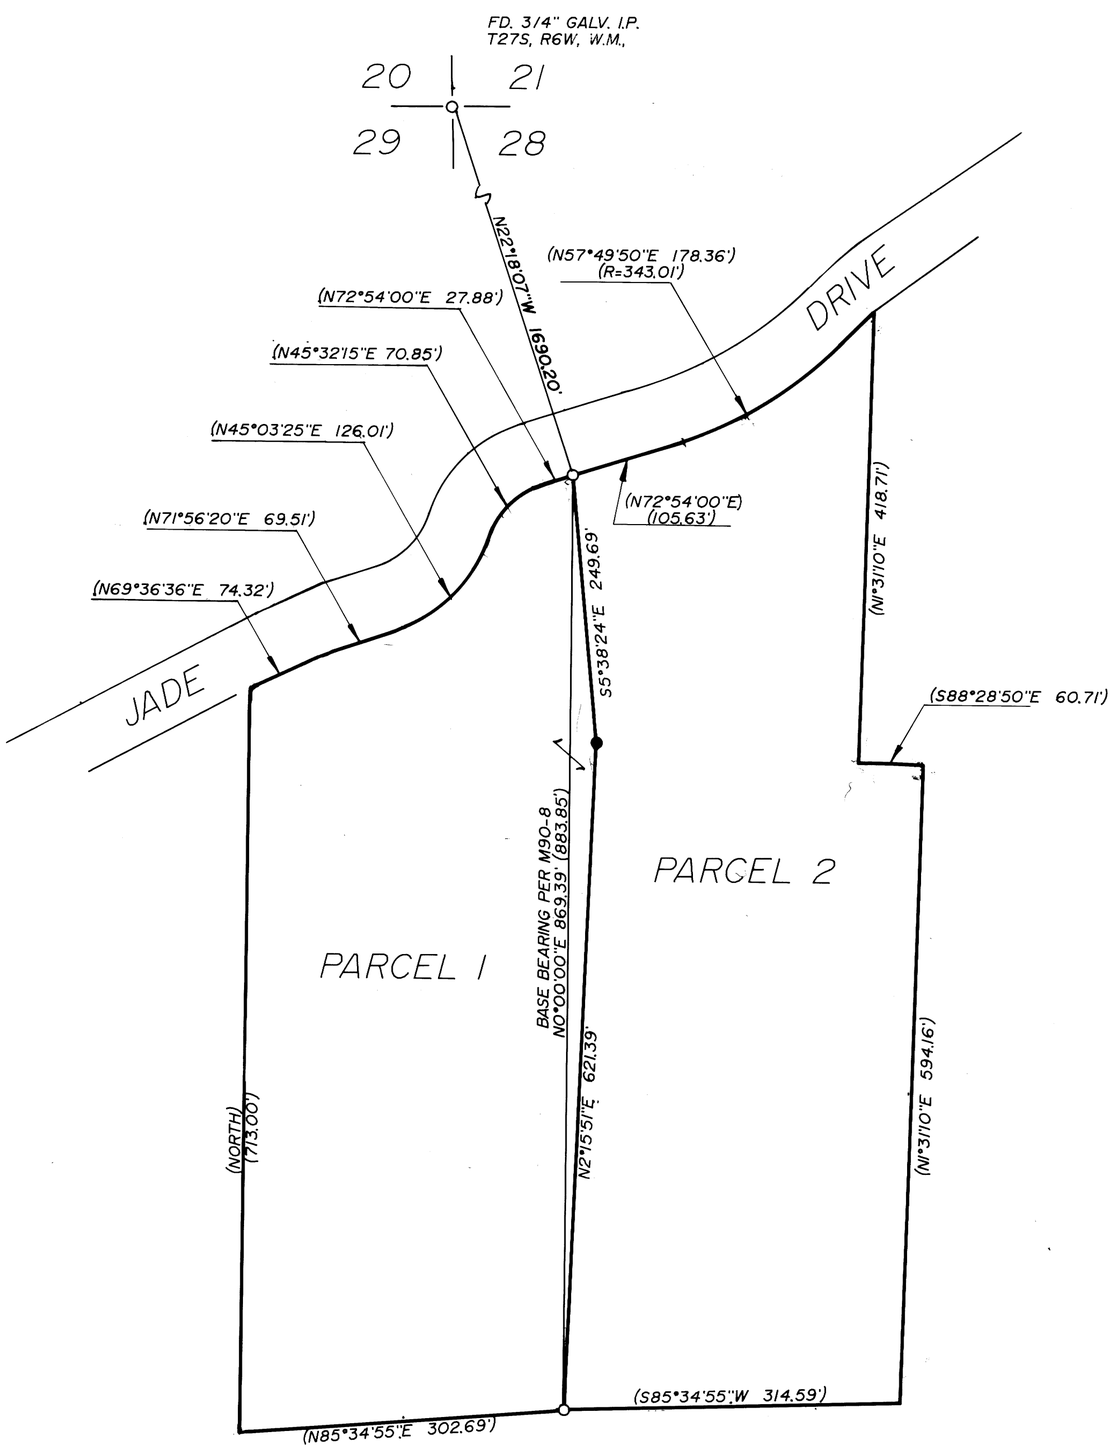

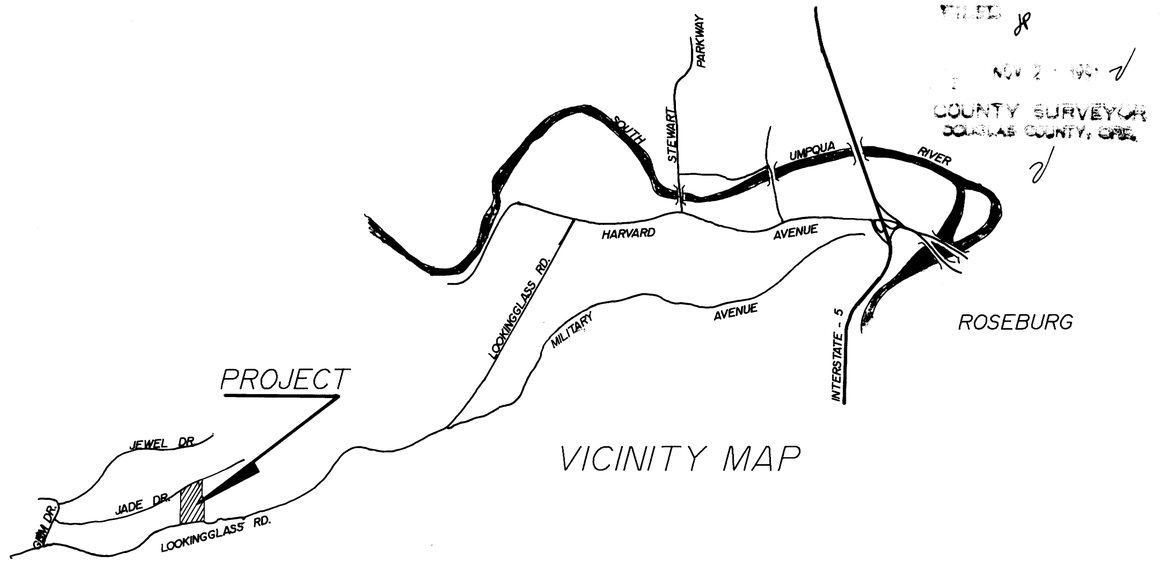

VICINITY MAP

FILED
NOV 2 1991
COUNTY SURVEYOR
DOUGLAS COUNTY, ORE.

MAP FILE M 114 - 9

NARRATIVE:

ADJUSTED LOT LINE FOR ADDITIONAL PROPERTY FOR PARCEL I TO PLACE A WELL, USED EXISTING MONUMENTS BETWEEN PARCEL #1 AND PARCEL #2.
FIELD CREW: N. HIBBS, M. HOLT
OFFICE: A. TEITZEL
DRAFTING: M. RADCLIFFE

LEGEND:

- ○ FD. 5/8" I.R. UNLESS OTHERWISE NOTED
- ● SET 5/8"x30" I.R. W/CAP STAMPED "BENTZ SUR. INC."

REGISTERED
OREGON
LAND SURVEYOR
JULY 31, 1979
DONALD A. BENTZ
839

APPROVALS:

Keith L. Cubic 11/29/91
DO. CO. PLANNING DIRECTOR — DATE

LOT LINE ADJUSTMENT

IN NW 1/4 OF SEC. 28, T27S, R6W, W.M., DOUGLAS COUNTY, OREGON.

SURVEYED FOR:	SURVEYED BY:
ROBERT COLLEY 923 JADE DR. ROSEBURG, OR. 97470	i.e. ENGINEERING 1205 SE COURT ROSEBURG OR. 97470 (503) 673-0166

SCALE:	DATE:	PAGE:
1" = 100'	JULY 1991	1 OF 1

COUNTY SURVEYORS FILE DATA
DO NOT REMOVE FROM OFFICE

MAP FILE M 114 - 9