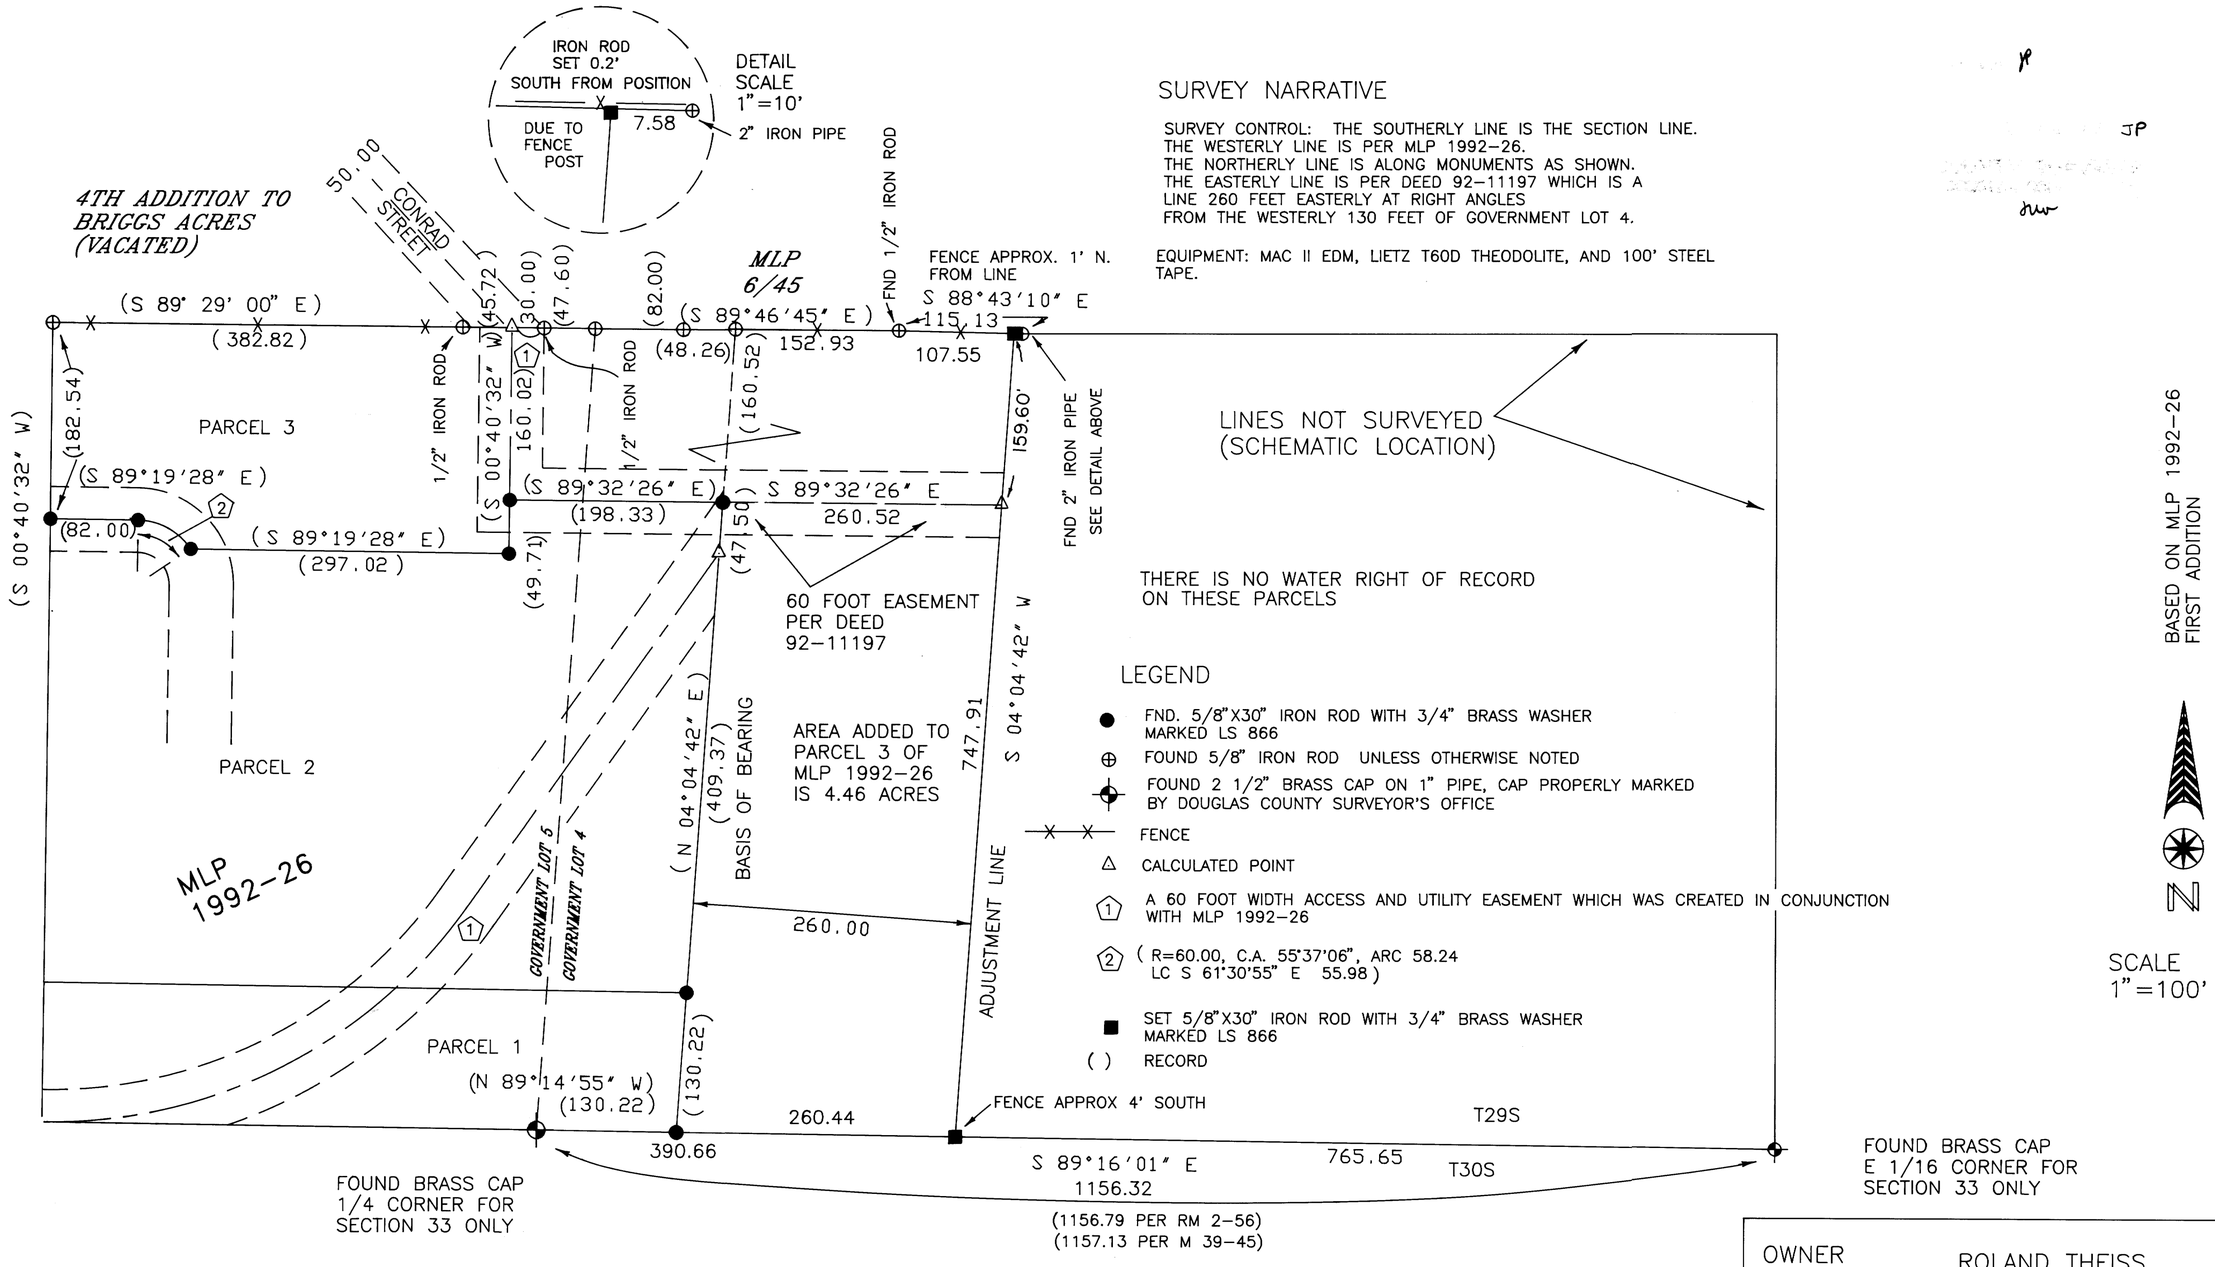

SURVEY NARRATIVE

SURVEY CONTROL: THE SOUTHERLY LINE IS THE SECTION LINE. THE WESTERLY LINE IS PER MLP 1992-26. THE NORTHERLY LINE IS ALONG MONUMENTS AS SHOWN. THE EASTERLY LINE IS PER DEED 92-11197 WHICH IS A LINE 260 FEET EASTERLY AT RIGHT ANGLES FROM THE WESTERLY 130 FEET OF GOVERNMENT LOT 4.

EQUIPMENT: MAC II EDM, LIETZ T60D THEODOLITE, AND 100' STEEL TAPE.

PROPERTY LINE ADJUSTMENT

LOCATED IN SOUTH 1/2 SECTION 33, T29S, R5W, WM

APPROVALS:

Keith L. Cubic 10/7/92
PLANNING DIRECTOR DATE

OWNER ROLAND THEISS
ADDRESS: P.O. BOX 824
MYRTLE CREEK, OR 97457

MAP PREPARED BY:
WILLIAM J. RUPPERT
P.O. BOX 1564
MYRTLE CREEK, OR 97457

SEPTEMBER 1992

MAP FILE M115 - 70

MAP FILE M115 - 70

COUNTY SURVEYORS FILE DATA
DO NOT REMOVE FROM OFFICE