SECTION CORNER 5, 6, 7, 8
FOUND : 1-1/4" IRON PIPE WITH DOUGLAS CO. BRASS CAP "1962"
36" ROTTEN FIR STUMP , N88W , 21.6' - WEYCO TAG
32" ROTTEN FIR STUMP , N15E , 35.8' - 2 B.L.M. TAGS
48" FIR STUMP , S80-1/2E , 20.6' - WEYCO TAG
21" FIR , S20E , 34.7' - CLOSED FACE
23" WHITE FIR , S9W , 80.6' - CLOSED FACE

1/4 CORNER 5 & 8
FOUND : 2" IRON PIPE WITH BRASS CAP
SEE C.S. NO. M111-75
18" FIR , N4W , 14.7' - VISIBLE SCRIBE
14" WHITE FIR , S73W , 15.7' - VISIBLE SCRIBE
15" WHITE FIR , N83-1/2E , 18.3' - VISIBLE SCRIBE
18" WHITE FIR , S2-1/2W , 26.3' - VISIBLE SCRIBE
(NOTE: DISTANCES TO "W" NAIL IN LOWER BLAZE)

SECTION CORNER 4, 5, 8, 9
FOUND : 2-1/2" IRON PIPE WITH B.L.M. BRASS CAP "1963"
28" WHITE FIR , N34-3/4E , 60.2' - CLOSED FACE, WEYCO & B.L.M. TAGS
32" WHITE FIR , S50-1/2E , 21.3' - CLOSED FACE, WEYCO & B.L.M. TAGS
24" WHITE FIR , S60-1/4W , 55.9' - CLOSED FACE, B.L.M. TAG
(RECORD, S68-1/4W , 64 LKS.)
63" FIR , S79-1/4W , 36.1' - VISIBLE BARK SCRIBE, WEYCO & B.L.M. TAGS
(LIVE TREE, NOT SNAG AS PER RECORD)
38" FIR , N47-1/4W , 42.1' - CLOSED FACE, WEYCO TAG
NOTE : 3/4" IRON PIPE 0.8 FT. NORTHWESTERLY

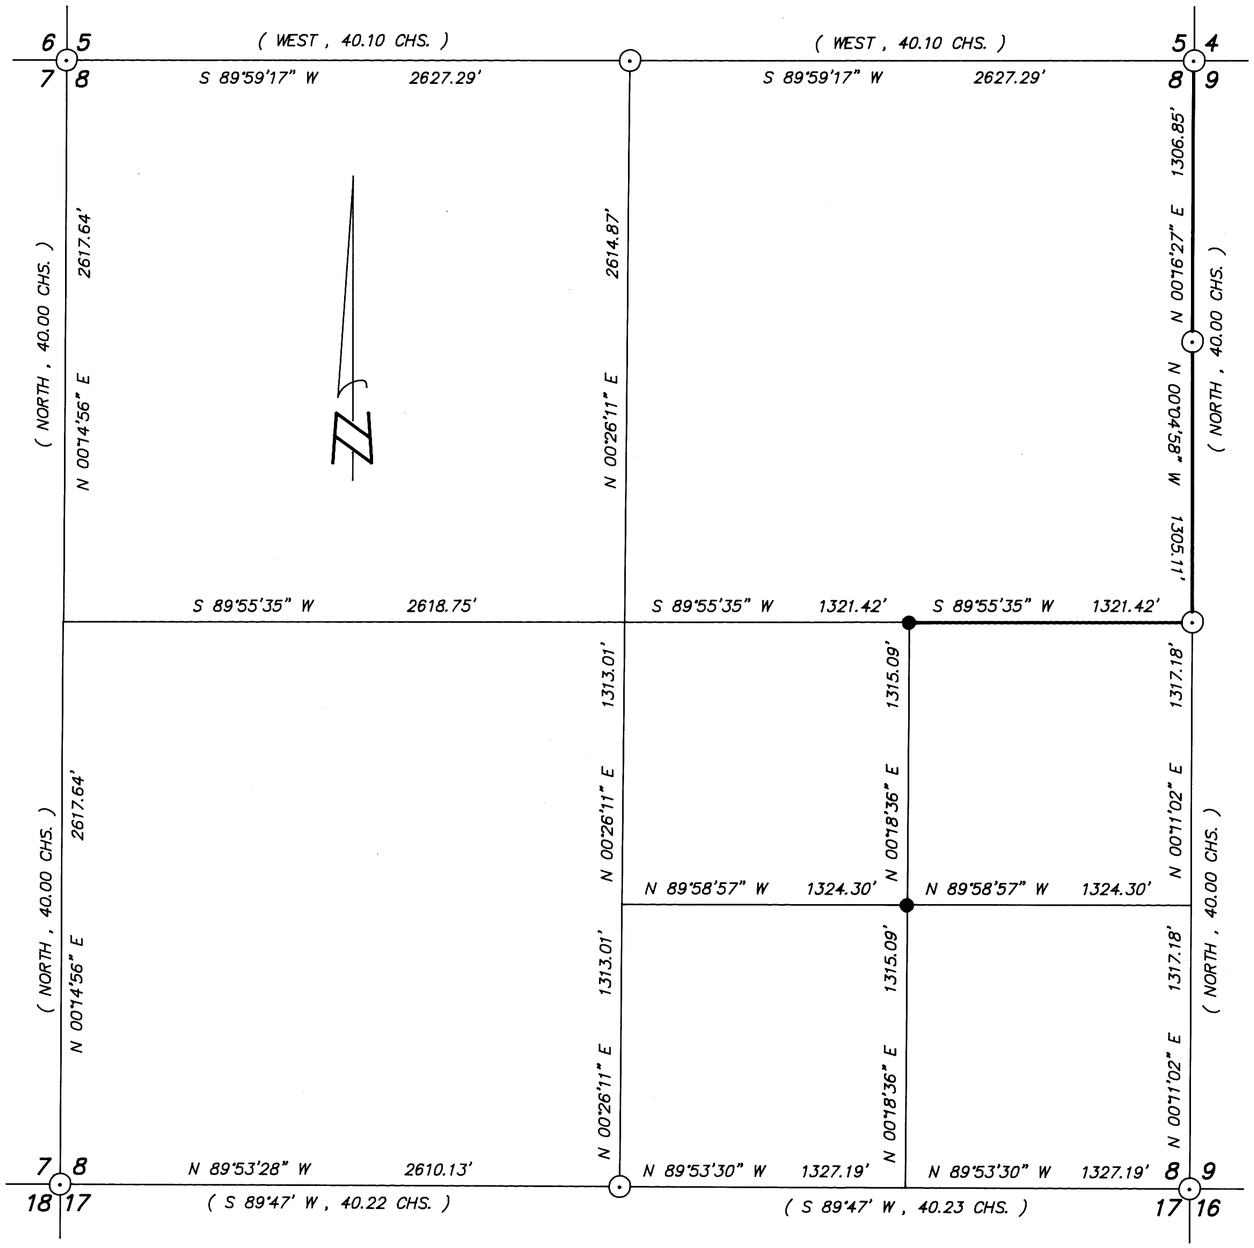

NORTH 1/16 CORNER 8 & 9
FOUND : 2-1/2" IRON PIPE WITH B.L.M. BRASS CAP "1963"
24" FIR , S58-1/2E , 16.7' - CLOSED FACE
21" FIR , N29-1/4W , 17.6' - CLOSED FACE, B.L.M. TAG

1/4 CORNER 8 & 9
FOUND : 1-1/4" IRON PIPE WITH DOUGLAS CO. BRASS CAP "1958"
39" FIR , N77-1/4E , 65.1' - CLOSED FACE, WEYCO & B.L.M. TAGS
31" FIR , N20W , 30.1' - CLOSED FACE, WEYCO & B.L.M. TAGS
66" FIR , N10W , 53.7' - PREVIOUSLY OPENED, DOUG COUNTY FOREST APPRAISAL TAG

CENTER-EAST 1/16 CORNER SECTION 8
SET : 2" X 42" IRON PIPE WITH BRASS CAP
13" FIR , N81E , 29.7' - SCRIBED "CE1/16S8 BT"
12" FIR , N47W , 5.1' - SCRIBED "CE1/16S8 BT"

T22S R4W
C E1/16 C
S8
PLS 752
1992

SOUTHEAST 1/16 CORNER SECTION 8
SET : 2" X 42" IRON PIPE WITH BRASS CAP
26" WHITE FIR , N80E , 40.0' - SCRIBED "SE1/16S8 BT"
8" FIR , N12W , 29.2' - SCRIBED "SE1/16S8 BT"

T22S R4W
SE1/16 + S8
PLS 752
1992

REGISTERED
PROFESSIONAL
LAND SURVEYOR
Donald L. Peel
OREGON
JULY 8, 1986
DONALD L. PEEL
752

- NARRATIVE -

THIS SURVEY WAS MADE IN AUGUST AND SEPTEMBER, 1992 BY DONALD L. PEEL OF PEEL BAKER LAND SURVEYING, INC., 1385 OAK STREET - SUITE 3, EUGENE, OREGON. THE PURPOSE OF THIS SURVEY WAS TO LOCATE AND MARK SOME OF THE PROPERTY LINES OF THE LAND OWNED BY WEYERHAEUSER COMPANY IN SECTION 8, T22S, R4W, W.M. AND TO ALSO SET THE CENTER-EAST 1/16 AND THE SOUTHEAST 1/16 CORNERS OF SAID SECTION 8. A WILD T1000 THEOMAT AND DI5S E.D.M. WERE USED TO PERFORM THIS SURVEY. THIS SURVEY IS A CONTINUATION OF MY EARLIER SURVEY IN SECTION 8 (M111-75). BEARINGS ARE BASED ON A SOLAR OBSERVATION AS PER SURVEY M111-75. CLOSED RANDOM TRAVERSES WERE RUN BETWEEN FOUND CORNERS FOR CONTROL.A CLOSED RANDOM TRAVERSE WAS RUN AS NEAR AS POSSIBLE TO THE PROPERTY LINES THAT WERE TO BE MARKED. OFFSETS FROM THE RANDOM TRAVERSE LINE TO THE TRUE PROPERTY LINE WERE CALCULATED AND USED TO DETERMINE THE POSITION OF THE TRUE PROPERTY LINE. THE TRUE PROPERTY LINE WAS MARKED IN THE FIELD BY BLAZING TREES (BLAZES NOTCHED AND PAINTED RED) ON BOTH SIDES OF THE TRUE LINE. ALL FOUR SECTION CORNERS, THE NORTH, SOUTH, AND EAST 1/4 CORNERS AND THE NORTH 1/16 CORNER ON THE EAST LINE WERE ALL FOUND AND USED FOR CONTROL. THE WEST 1/4 CORNER WAS SEARCHED FOR BUT NOT FOUND. THE POSITION FOR THE WEST 1/4 CORNER WAS DETERMINED (BUT NOT SET) AT MIDPOINT BETWEEN THE NORTHWEST AND SOUTHWEST SECTION CORNERS. THE POSITION FOR THE CENTER 1/4 CORNER WAS DETERMINED (BUT NOT SET) AT THE POINT OF INTER-SECTION OF THE NORTH-SOUTH AND THE EAST-WEST CENTERLINES. THE CENTER-EAST 1/16 CORNER WAS SET AT MIDPOINT BETWEEN THE CENTER 1/4 CORNER AND THE EAST 1/4 CORNER. THE SOUTHEAST 1/16 CORNER WAS SET AT THE POINT OF INTERSECTION OF THE NORTH-SOUTH AND THE EAST-WEST CENTERLINES OF THE SOUTHEAST 1/4. BOTH CORNERS SET IN THIS SURVEY WERE MONUMENTED AS SHOWN ON THIS PLAT. FOR ALL BEARING TREES MARKED IN THIS SURVEY, THE DISTANCE WAS MEASURED FROM THE CORNER TO A "W" NAIL IN THE LOWER BLAZE AND THE BEARINGS ARE MAGNETIC, VARIATION 20°.

BASIS OF BEARING : SOLAR OBSERVATION (AS PER C.S. M111-75)

SCALE : 1 = 500'

⊙ CORNERS FOUND
● CORNERS SET THIS SURVEY
——— PROPERTY LINE BLAZED
( ) RECORD DATA G.L.O. 1855

SURVEYORS FILE DATA
REMOVE FROM OFFICE

SURVEY IN
E1/2 SECTION 8, T22S, R4W, W.M.
DOUGLAS COUNTY, OREGON
FOR
WEYERHAEUSER COMPANY
BY
PEEL BAKER LAND SURVEYING, INC.
1385 OAK ST. - SUITE 3, EUGENE, OREGON
SEPTEMBER 25, 1992

SECTION CORNER 7, 8, 17, 18
FOUND : 1-1/4" IRON PIPE WITH DOUGLAS COUNTY BRASS CAP DATED 1956

1/4 CORNER 8 & 17
FOUND : 1-1/4" IRON PIPE WITH DOUGLAS COUNTY BRASS CAP DATED 1965
26" FIR , N81-1/4E , 41.1' - CLOSED FACE
32" CEDAR , S18-1/2W , 33.8' - CLOSED FACE, B.L.M. TAG
25" FIR , S53-3/4W , 19.3' - CLOSED FACE (NO REC.)
16" FIR STUB , N21-3/4W , 63.9' - VISIBLE SCRIBE "BT"

SECTION CORNER 8, 9, 16, 17
FOUND : 2-1/2" IRON PIPE WITH B.L.M. BRASS CAP "1963"
32" MAPLE , N57-1/2E , 72.6' - CLOSED FACE
45" MAPLE , S70E , 71.3' - CLOSED FACE
19" CEDAR , N60W , 31.0' - SCRIBING VISIBLE
(LIVE TREE NOT A SNAG AS PER RECORD)
21" CEDAR , N35-1/2W , 35.0' - CLOSED FACE
35" CEDAR STUB , S20W , 6.6'
NOTE : 1" AXLE AND HAINES "T" BAR ALONGSIDE TO NORTH

M111-75