COUNTY SURVEYORS FILE DATA
DO NOT REMOVE FROM OFFICE

M 116 - 10

nw

nw

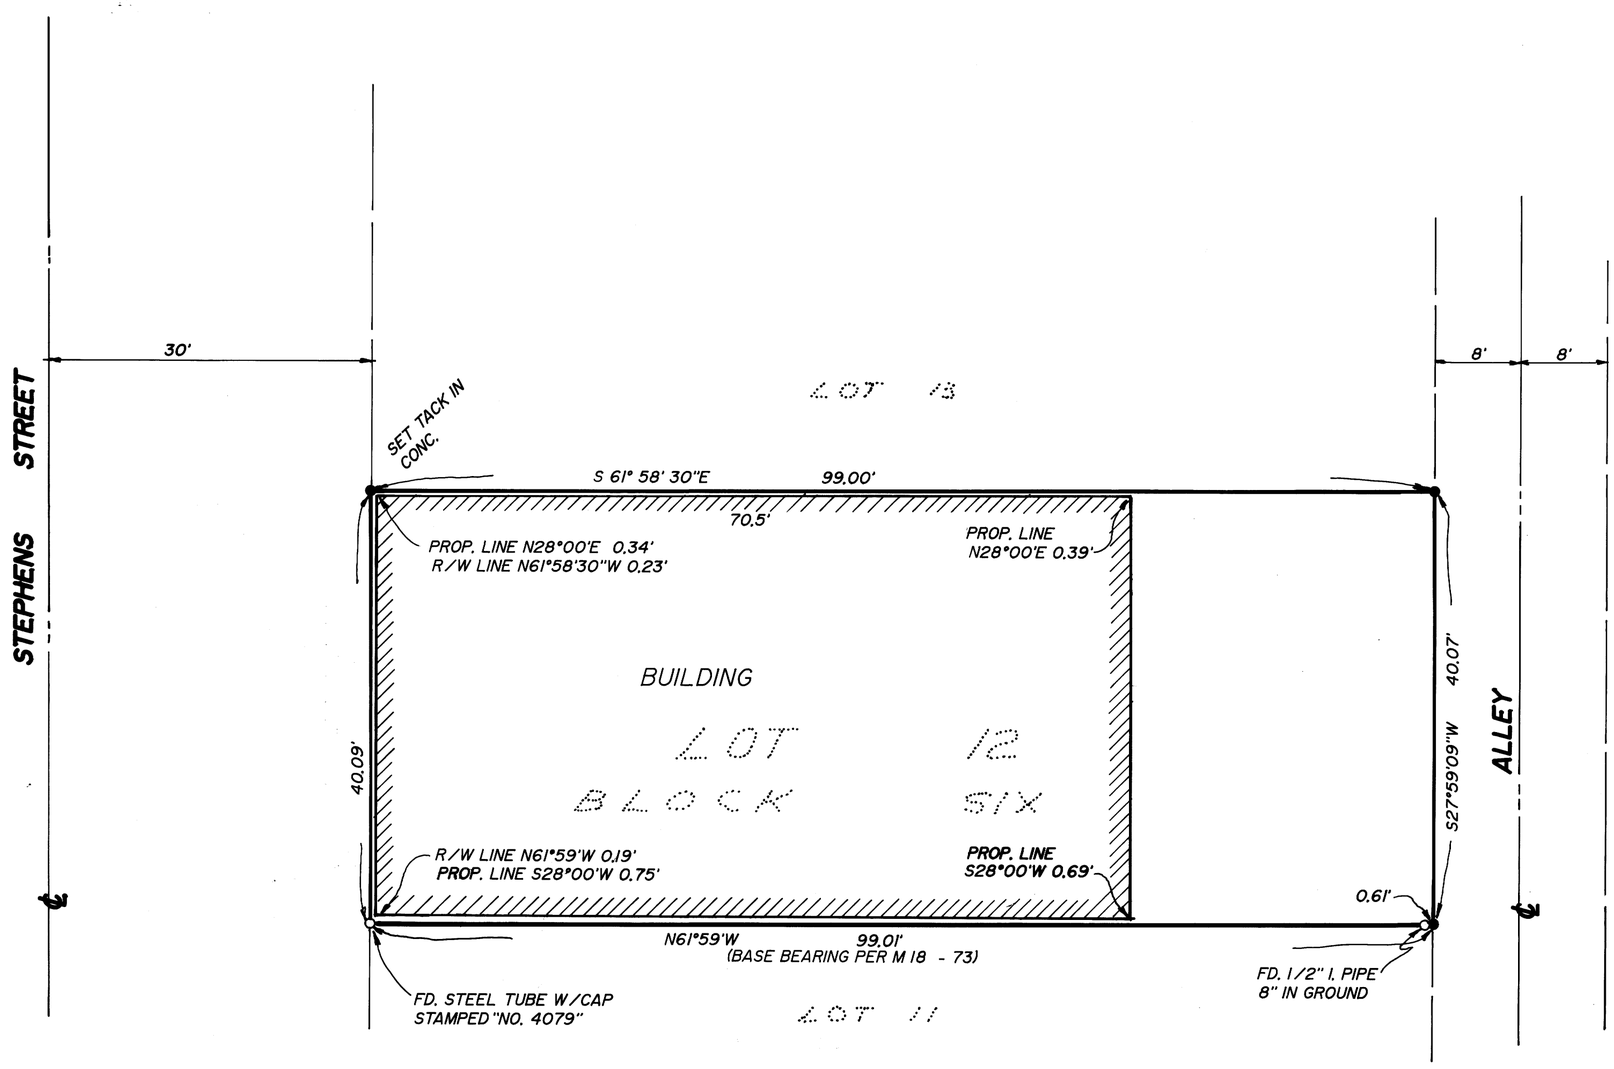

NARRATIVE:
SURVEY TO RESET MISSING PROPERTY CORNERS PER SURVEY M 18 - 73. MONUMENTS SET WERE MEASURED FROM MONUMENTS FOUND USING THE RECORD ANGLES AND DISTANCE PER M 18 - 73 WITH CALLS SHOWN HEREON PER SAID SURVEY.
FIELD CREW: R. WARE, & DEREK FEIGEL

EQUIPMENT: WILD T-16 THEODOLITE MOUNTED W/ NIKON ND 160 EDM

OFFICE COMPUTATIONS: R. WARE
DRAFTING: K. VANGORDON

LEGEND:

- ● SET 5/8" X 30" IRON ROD WITH CAP MARKED "i.e. ENGINEERING
- ○ FD. MONUMENT NOTED

REGISTERED
OREGON
LAND SURVEYOR
JULY 12, 1968
DONALD A. BENTZ
839

SURVEY TO RESET PROPERTY CORNERS

OF LOT 12, BLOCK 6, WAITE'S ADDITION TO ROSEBURG
IN SOUTHEAST 1/4 SECTION 24, TOWNSHIP 27 SOUTH, RANGE 6 WEST,
WILLAMETTE MERIDIAN, DOUGLAS COUNTY, OREGON

SURVEY FOR:	SURVEYED BY:
FRAN HUNTINGTON 1660 WHISTLER'S LN. ROSEBURG, OREGON 97470	i.e. ENGINEERING 1205 SE COURT ROSEBURG, OREGON 97470

SCALE: 1"=10'	DATE: NOV. 1992	245-03	PAGE 1 OF 1

COUNTY SURVEYORS FILE M 116 - 10