COUNTY SURVEYOR FILE
DO NOT REMOVE FROM

BOUNDARY LINE ADJUSTMENT

IN THE SE 1/4 OF SEC 35 T26S R6W WM
SURVEYED FOR CASEY MORGAN-1421 N MYRTLE RD., MYRTLE CR., OR.
BY BRUCE R. ROGERS, 443 W UMPQUA, ROSEBURG, OR. 672-2834
SCALE 1"=50' DATE AUG 15, 1992

FILED
DEC 4 1992

MAP FILE M 116-15

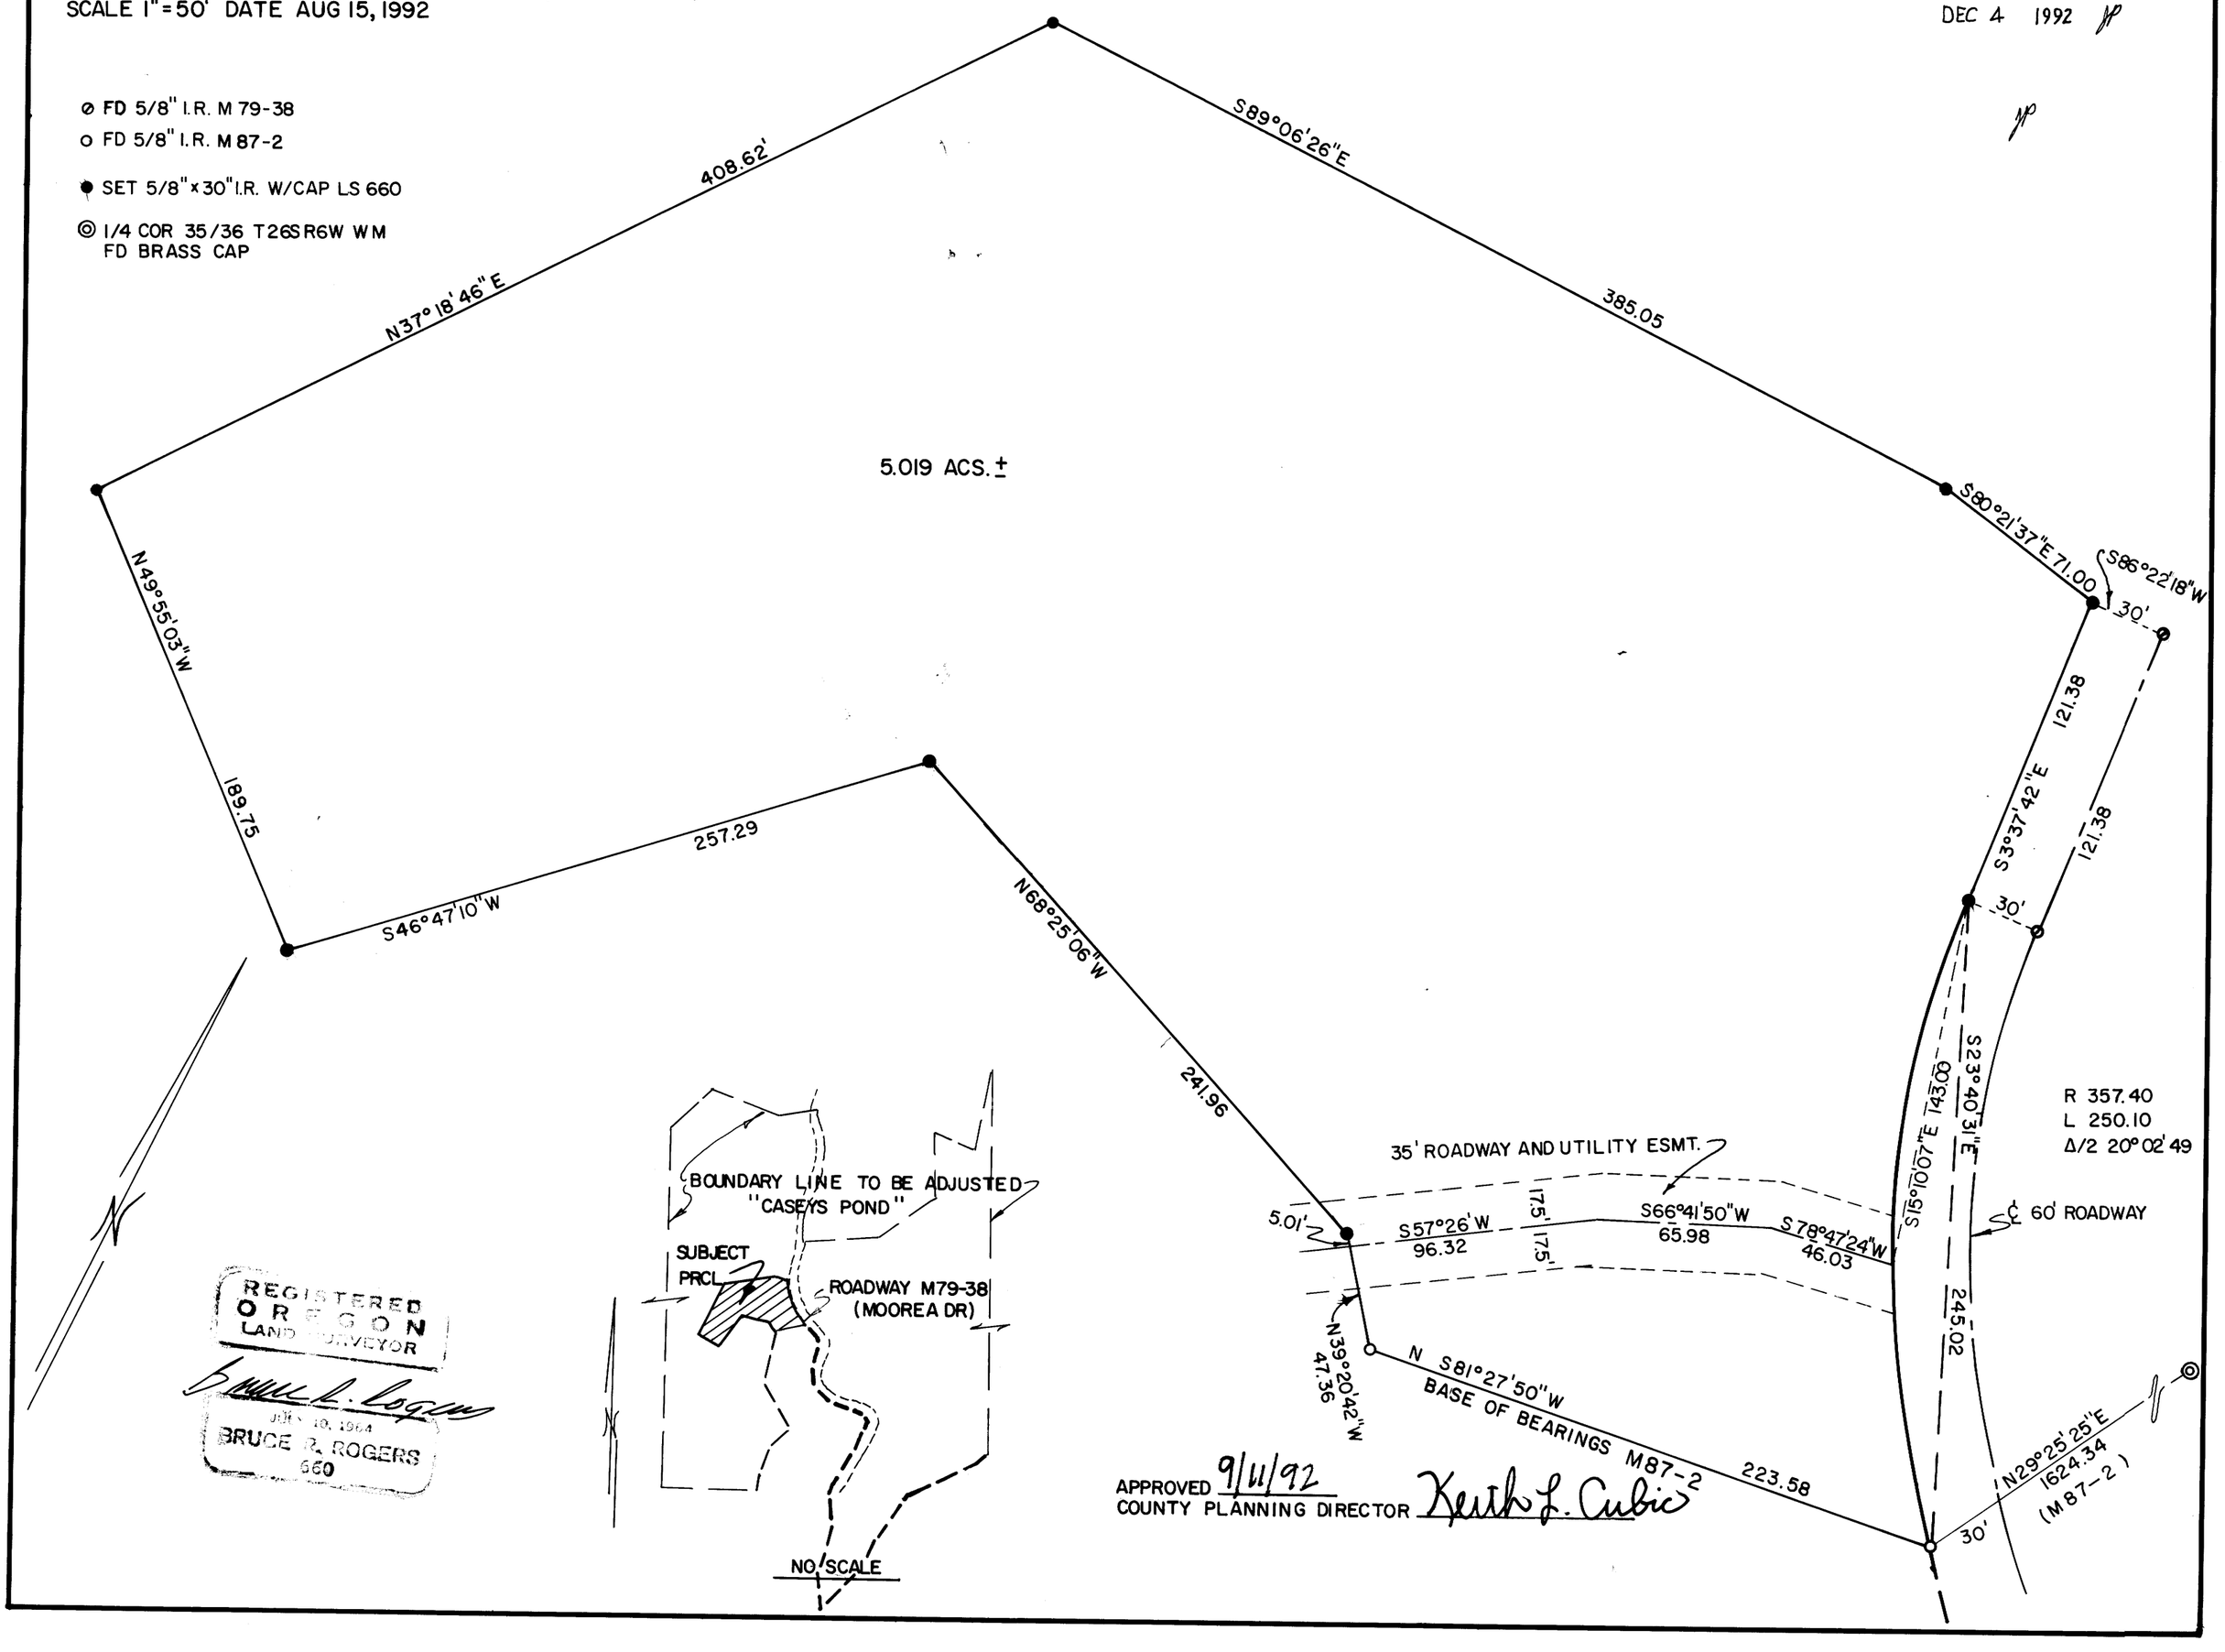

APPROVED 9/11/92
COUNTY PLANNING DIRECTOR Keith L. Cubic

MAP FILE M 116-15